




HÚS, ÁÐUR TEIKNAD AF KRISTJÁNI
OLASVILI ARK.FAT 1. FEB. 1992.

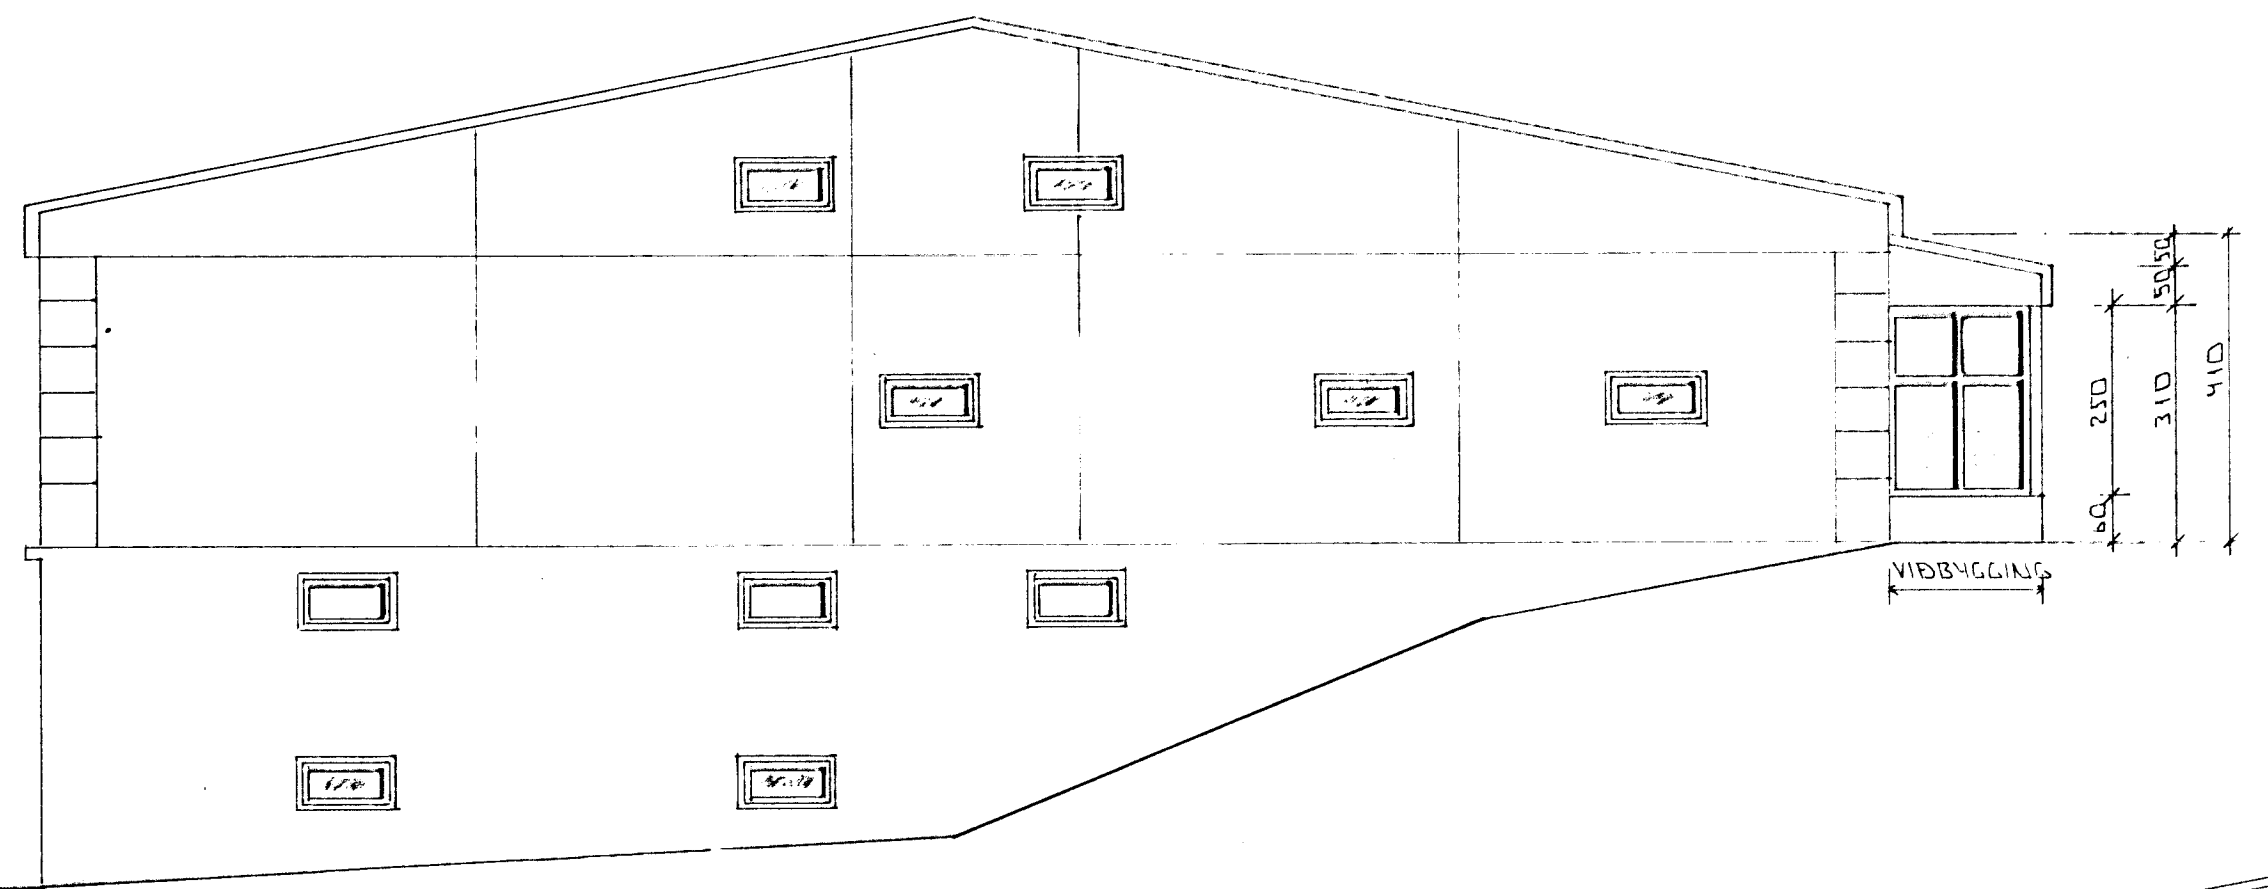

VESTUR

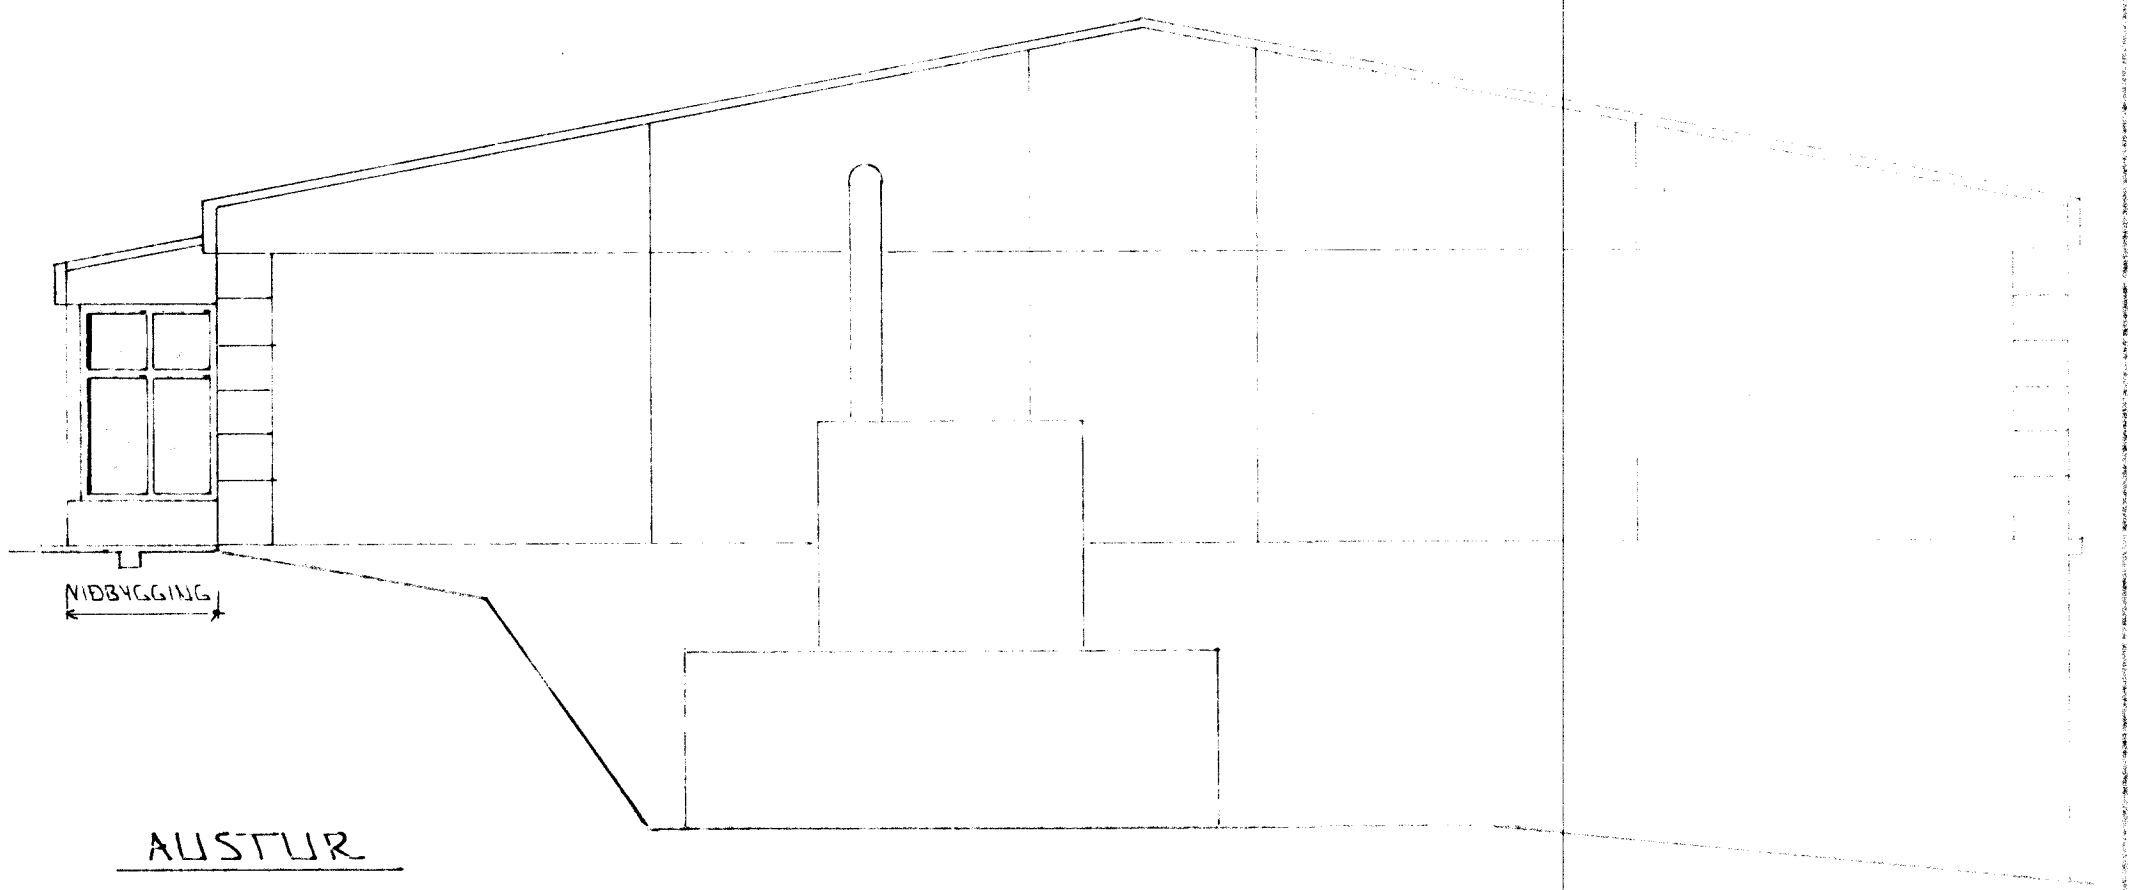

AUSTUR

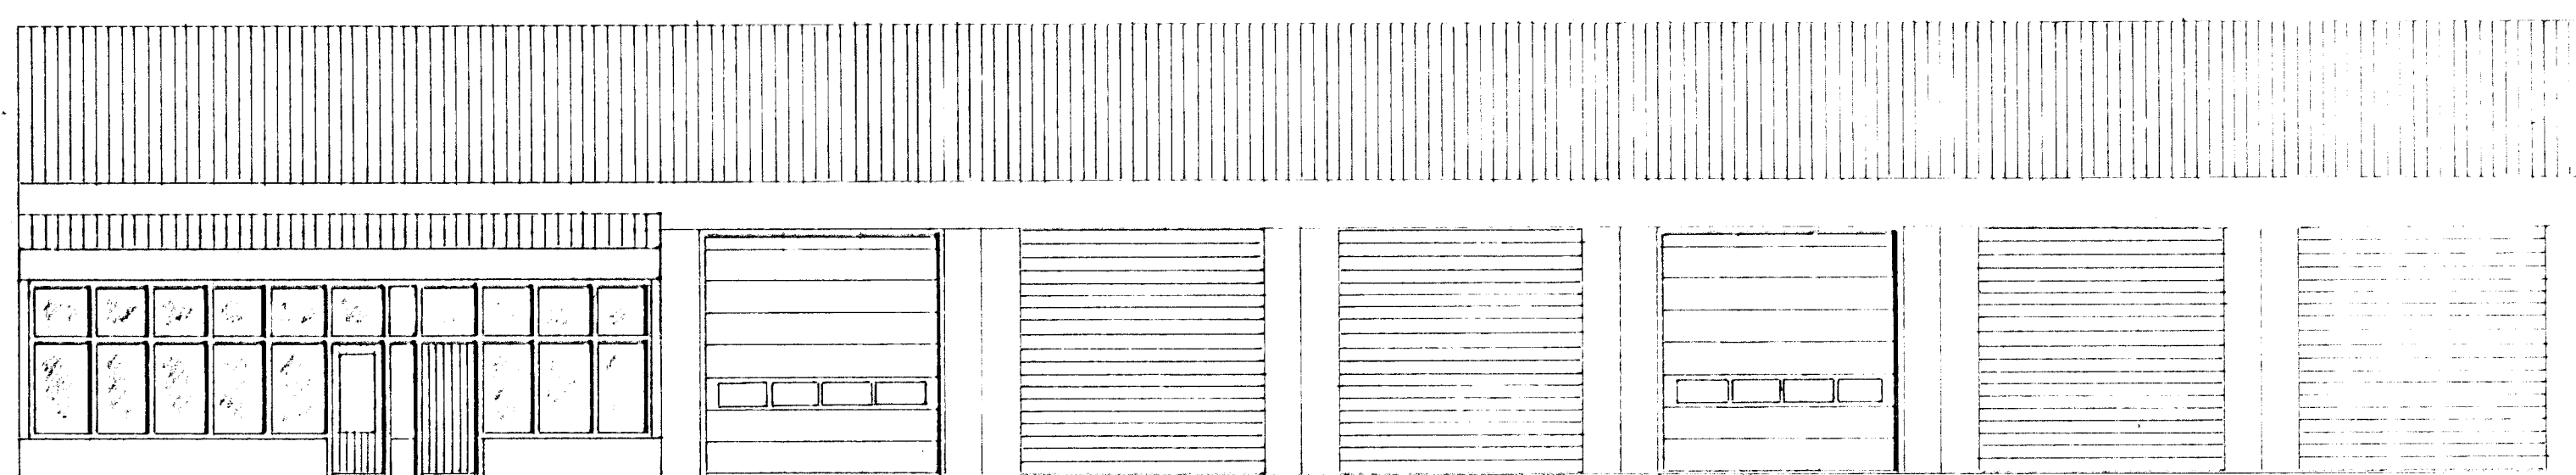

SUÐUR

01 APRÍL '91 BETT VIÐ GLEGGUNÁ VESTURGALE 68
BR. DAGS ED TOR 1991

HVALEYRARBRAIT 39
HAFNARFIRÐI

ÚTLIT

NKV * 1 : 100
DAGS SEPT '91
VERK NR 9205
TEIKN NR 0-03
HANNAD
TEIKNAD GK
YEIRFARIÐ

TEIKNIDJÓUSTA
SIGURDAR ÞORLEIFSSONAR ehf.
STADUR 101 HAFNARFIRÐI