


NORÐUR

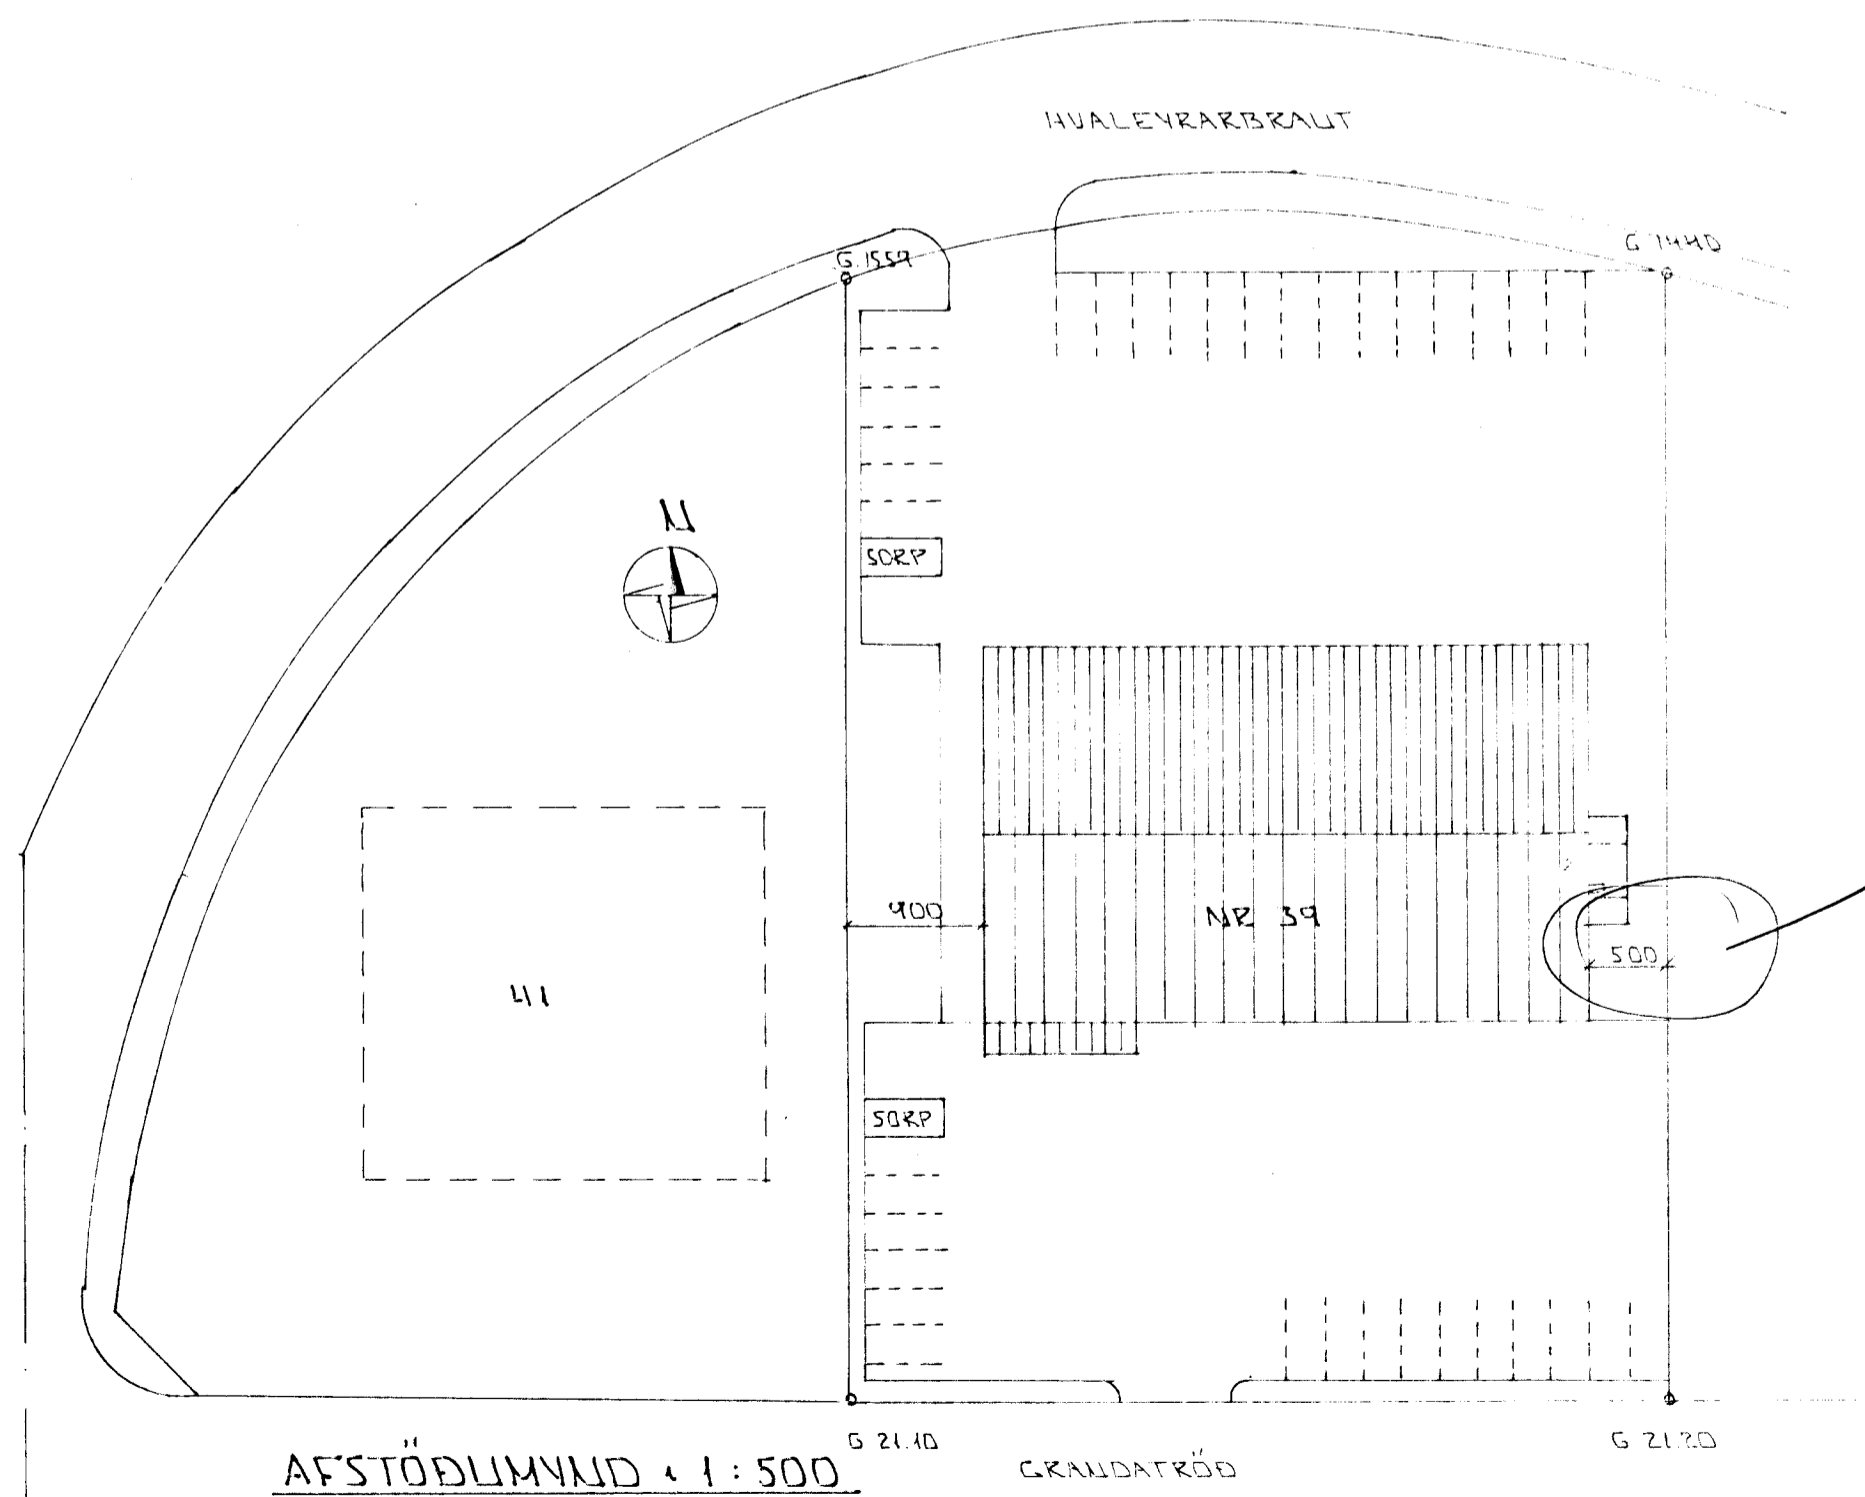

AFSTÖÐLIMNING 1:500

GRANDAFRÖÐ

27/6 '97

Scuff. Brúnaus. lita
 -cc- heilbr. H
 -cc- Vinnuþétt 8.
 Skráninga tofa

01 APRÍL '97 HUNDARÓPLUMR Á 1 HED 8/8
 BR: DAGS EÐL. BR. 100

HVALENRABRAUT 39
 HAFNARFIRÐI

ÚTLIT - AFSTÖÐLIMNING

MKV 1:100
 DAGS 11.01.96
 VERK NR. 9205
 TEIKN NR. 0-04
 HANNAÐ
 TEIKNAD GK
 YFIRFAHID

TEKNIÐJÓNUSTA
 SIGURDAR ÞORLEIFSSONAR EHF
 STRANDGÖTU 11 220 HAFNARFIRÐI TEL. 51 11 11 FAX. 51 11 12