



KP

Úr Gildi

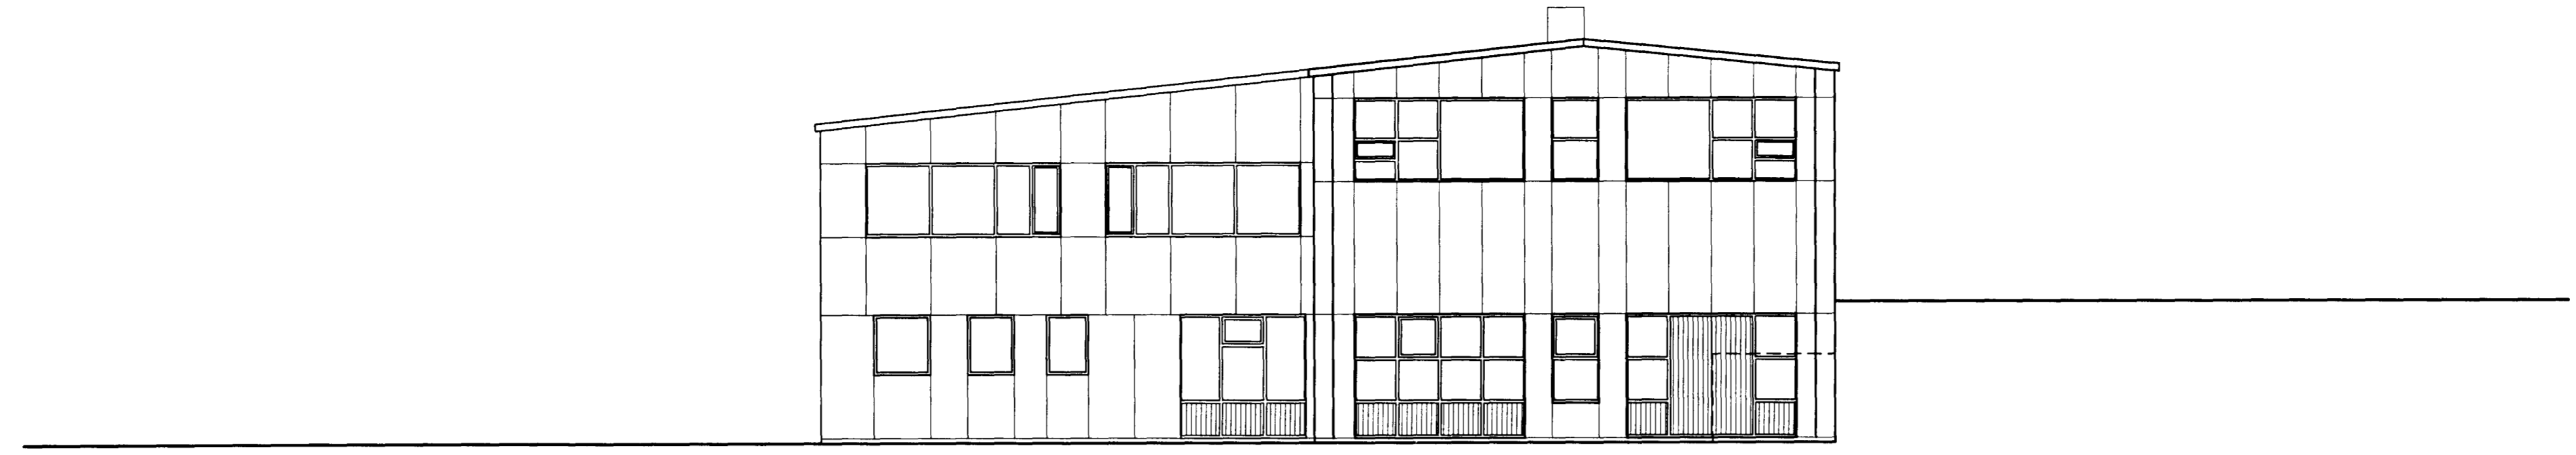


NORDVESTLÆG HLID  
MKV. 1:100

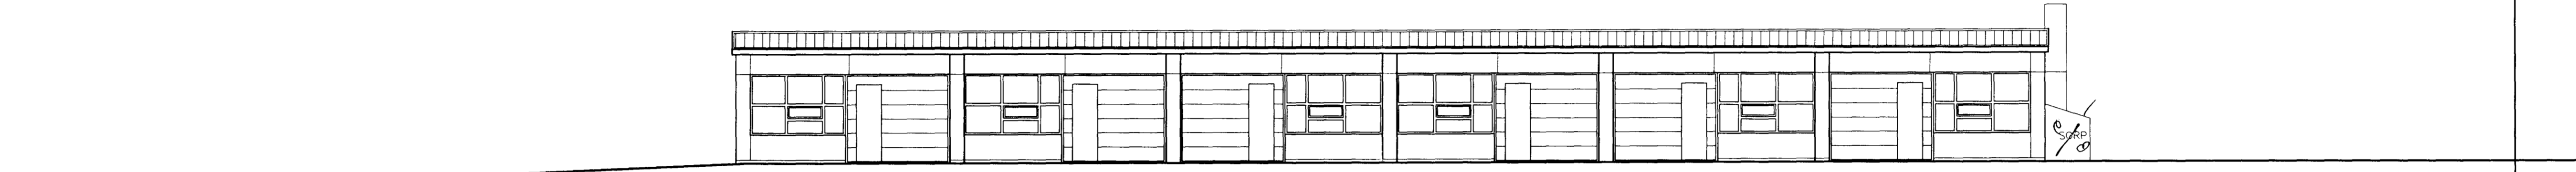

SUDVESTLÆG HLID  
MKV. 1:100



NORDAUSTLÆG HLID  
MKV. 1:100

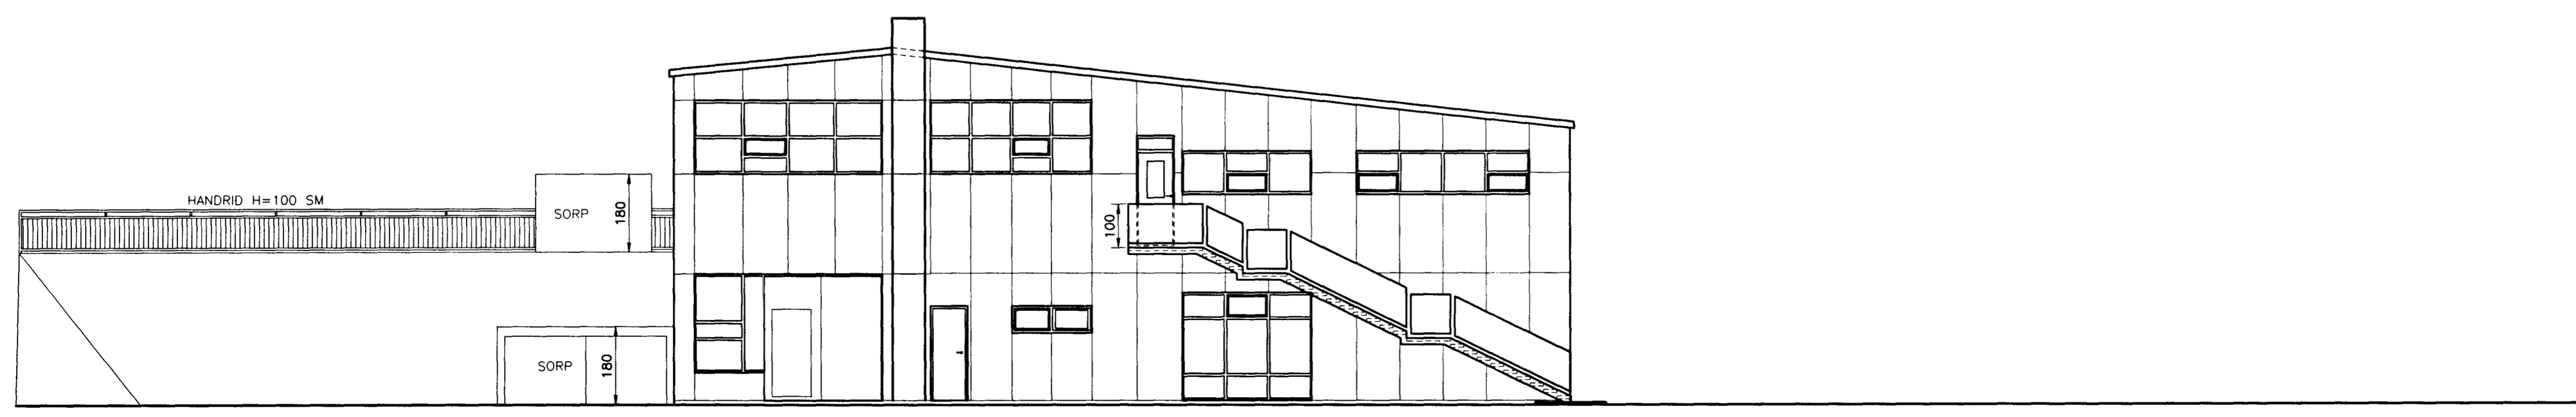

SUDAUSTLÆG HLID  
MKV. 1:100

Stíkkvillir hlífuborgarsvæðisins h.s.

21/12'00  
Deila Þorsteinsson

Br. nr.	Dags.	Af.	Breyting
(A)	07.12.00	þF	HANDRÍÐ A STALLI MILLI LÓÐARHLUTA O.F.L.
(B)			
(C)			
(D)			

**TEIKNISTOFAN  
TORGIÐ**  
RÁÐGJÖF - HÖNNUN - EFTIRLIT

ARMÓLI 36, 108 REYKJAVÍK, SÍMI 568-8866, FAX 568-8878  
Þorsteinn Friðþjófsón, Magnús Þ. Guðmundsson,  
byggingafræðingur innviðsáskiltekt.  
Kt. 211055-5299 Kt. 240654-5359

**HVALEYRARBRAUT 3  
HAFNARFIRÐI**

Tekningarheiti: ÚTLITSMYNDR

Dags. 26.05.2000. Kvartí 1:100  
Hannaþ þF Teknaþ þF Samþ. *Deila Þorsteinsson*  
Verknr. 98-915 Tekn.nr. 104 Breyf.nr. A