
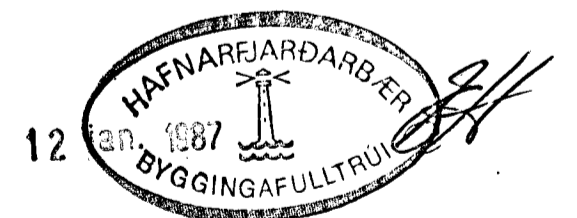


GRUNNMYND 2. HÆÐAR 1:50

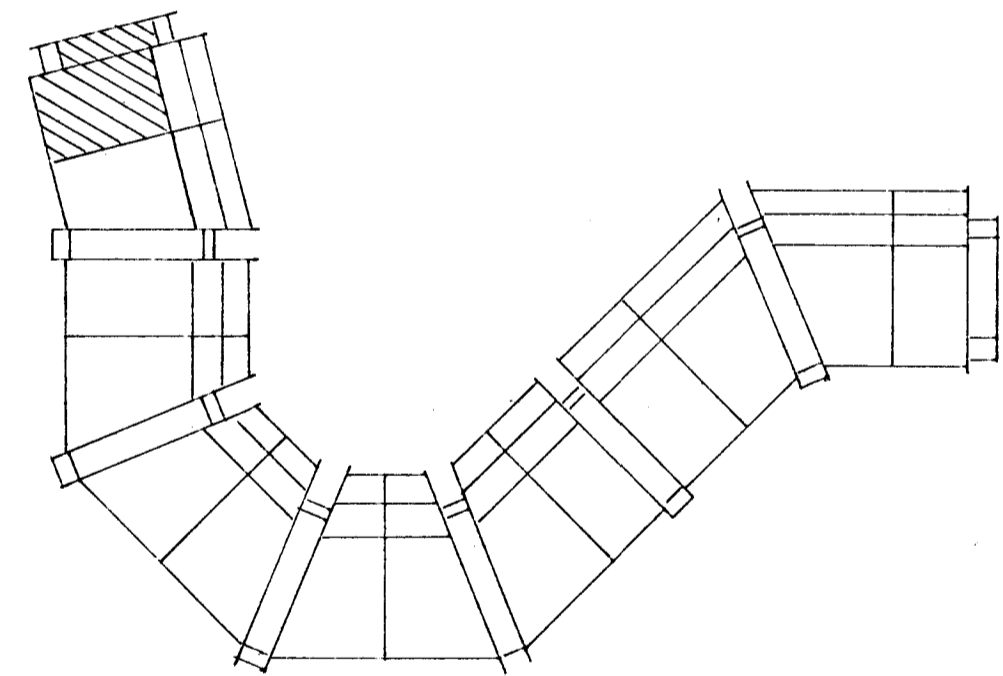

DR. NR.	DAGS	EÐLI BREVTINGAR	SIGN.
01	8.4.87	BR. SKV. LÖGN PÍPUL.M.	36
HIVAMMABRAUT 16 HAFNARFIRÐI HITA-VATNS OG FRÆNNISLAGNIR. 2. HÆÐ. MELIKV. 1:50			DAGS JAN 87 HANJAB TEIKNAB. VERK NR. 8602
SIGURÐUR ÞORLEIFSSON TEKNIFRÆÐINGUR F.T.F.I.			BLAD NR.
STRANDGÖTU 11 HAFNARFIRÐI SÍMI 54751			2-03