


Áskjalur á fundi 19.10.85  
 9.10.85  
 101

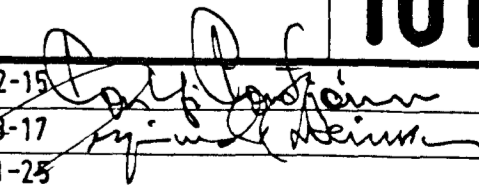

<b>TEIKNISTOFA</b>		HVAMMABRAUT 2-16 HAFN.	
GYLFI GUDJÓNSSON		ADALTEIKNING	
INGIMUNDUR SVEINSSON		GRUNNMYND KJALLARA NR. 2-8	
ARKITEKTAR FAI DSA		VERK 83-151	
SKULACHAUSTI 3, 101 RÍKISBANKAN 2040 OG 14990		BLAD 101	
HANNAÐ GY IS	TEIKNAD GY	REYKJAVN 1983-02-15	 1983-03-17 1985-11-25
KVAÐI	1:100	BREYTT 1983-03-17	
		1985-11-25	