



GRUNNMYND KJALLARA 1 : 50

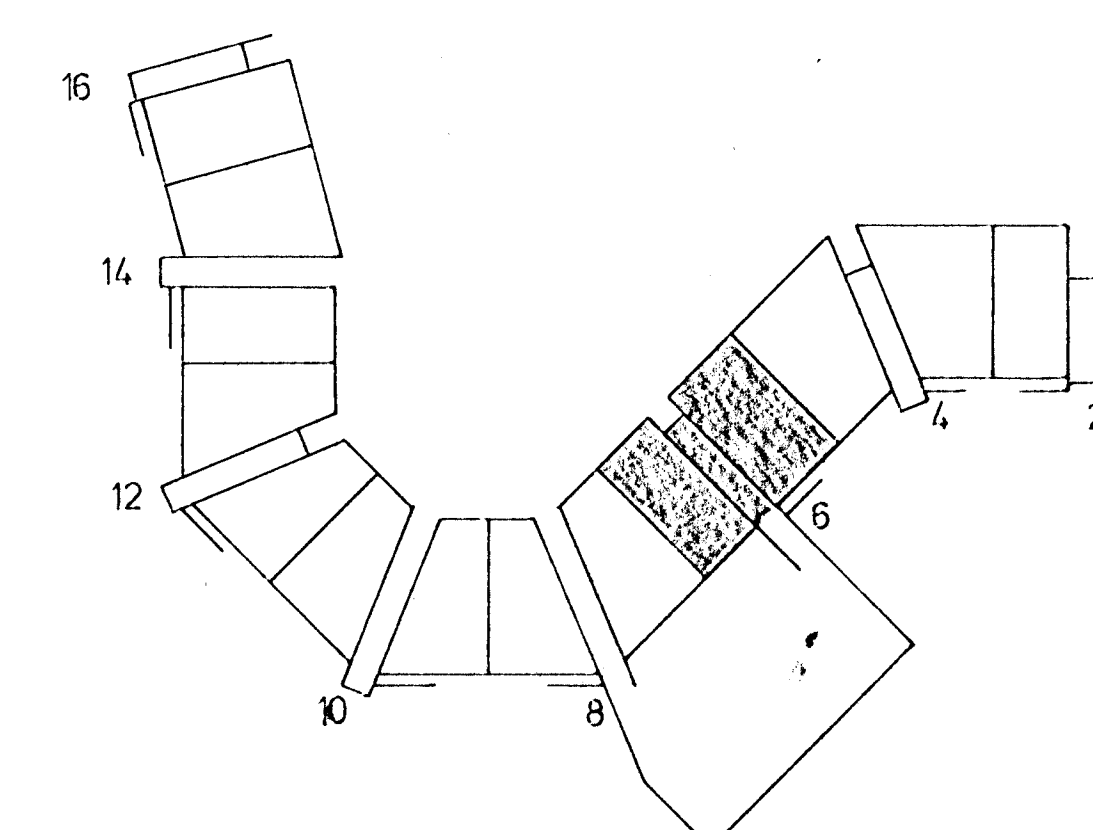

AFSTADA 1 : 50

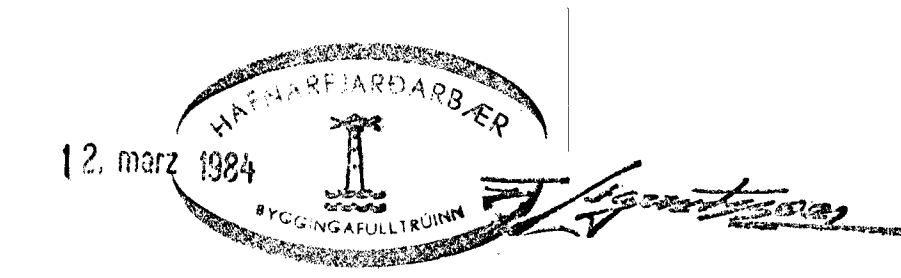

BREYTT SAMKV. OSK HÚSBYGGJANDA

SKÝRINGAR SJÁ TEIKNINGU NR. 2.0

HVAMMABRAUT 6, HAFNARFIRÐI	Mælikv. 1:50	Vark 83017	Teikn. nr. 3.1
HITALÖGN GRUNNMYND KJALLARA	Hannaberg	Yfirfarið: Hannaberg	Dags. JÚLÍ 83
VERKFRÆÐIÞJÓNUSTA JÓHANNIS G. BERGÞÓRSSONAR h/f.	VERKFR. MVFI	HAFNARFIRÐI - SIMAR 53315 OG 5241	