


Samþykkt á fundi bygginga-
nefndar þ. 25.10.1986
BYGGINGAFULLTRÚMIN
Í HAFNARFIRÐI
Einar H

FLATARMÁL TUBBAR Á 1. HÆÐ $172,80 \text{ m}^2$ $169,2 \text{ m}^2$
 --- BIFREIÐAG. + G $45,87 \text{ m}^2$ $46,8 \text{ m}^2$
 ALLS $218,67 \text{ m}^2$ $216,0 \text{ m}^2$ 28R
 RÓMMÁL HÖSS ALLS $792,00 \text{ m}^3$ $799,0 \text{ m}^3$ 8R


FRÁ ÖLLU GLUGGALAUSU RÝMI KOMI LOFTRASTING
SKV. BYGGINGARSAMÞYKKT.
ANNARS SKV. SÉRTEIKNINGUM

KÖLNUNARTÖLUR

ÚTVEGGIR	0,95	W / m ² c ⁰
ÞAK	0,30	---
GÖLF	0,40	---

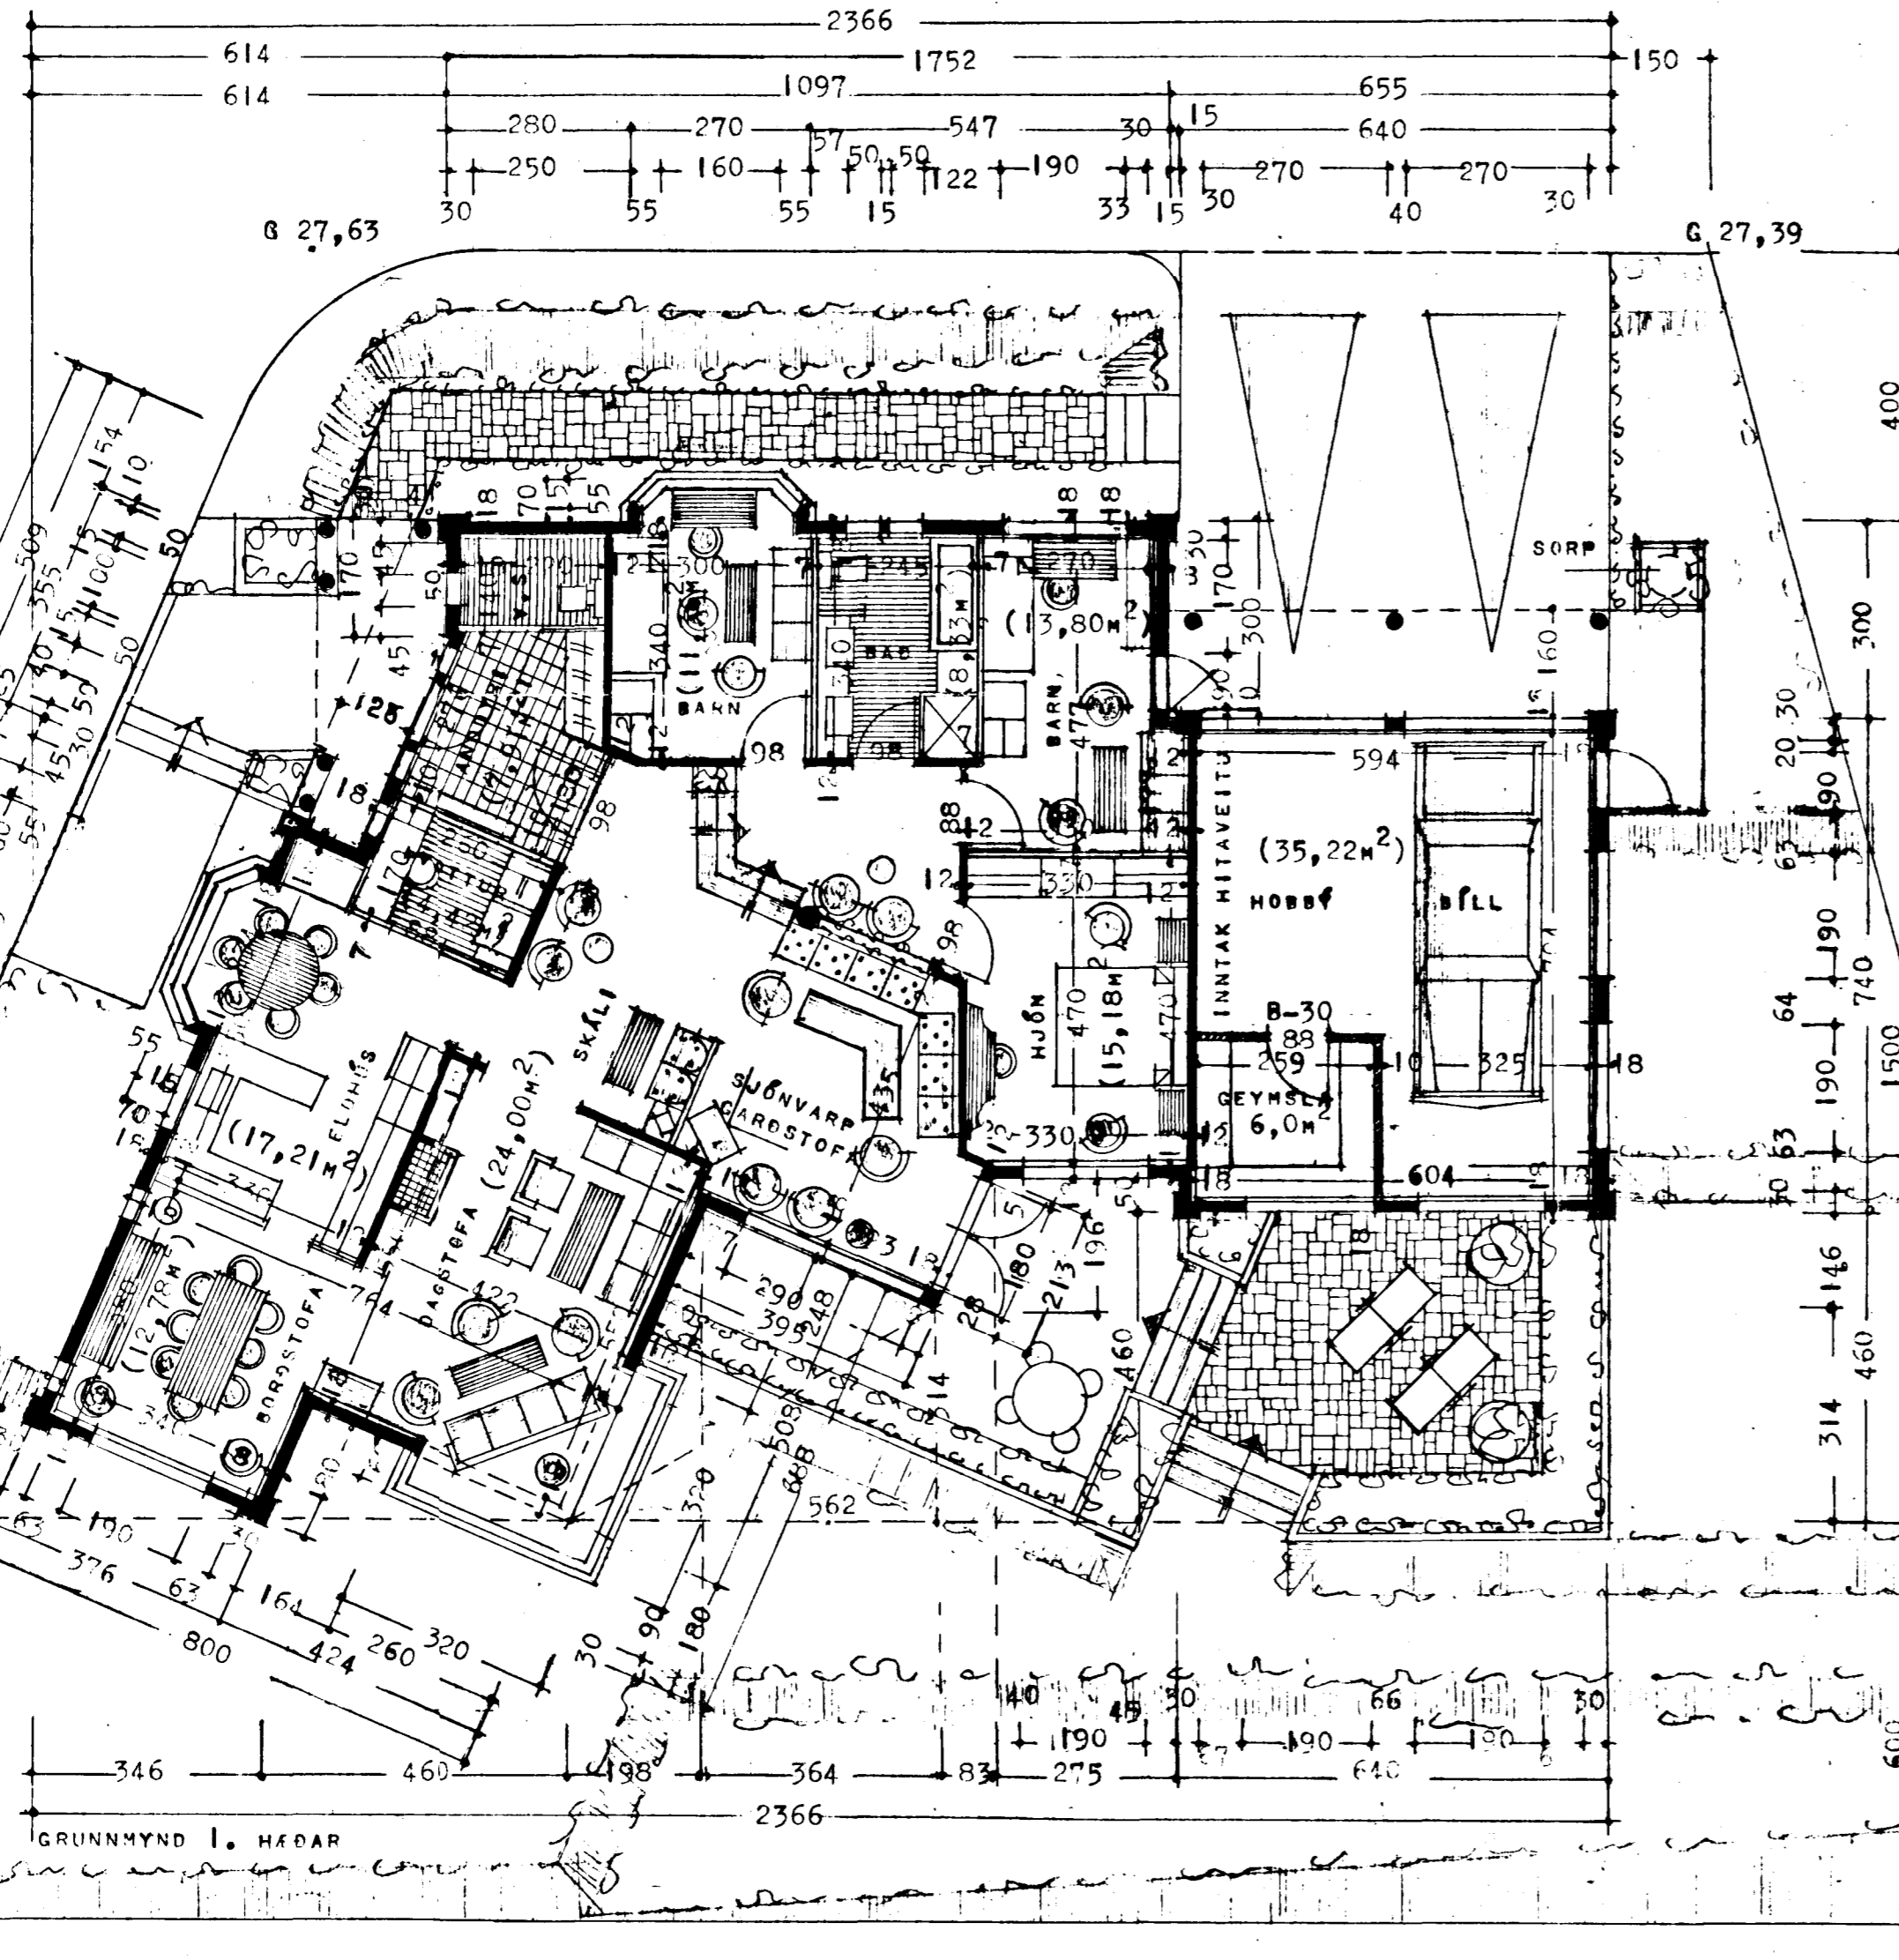

AFSTÖÐUMYND M 1:500

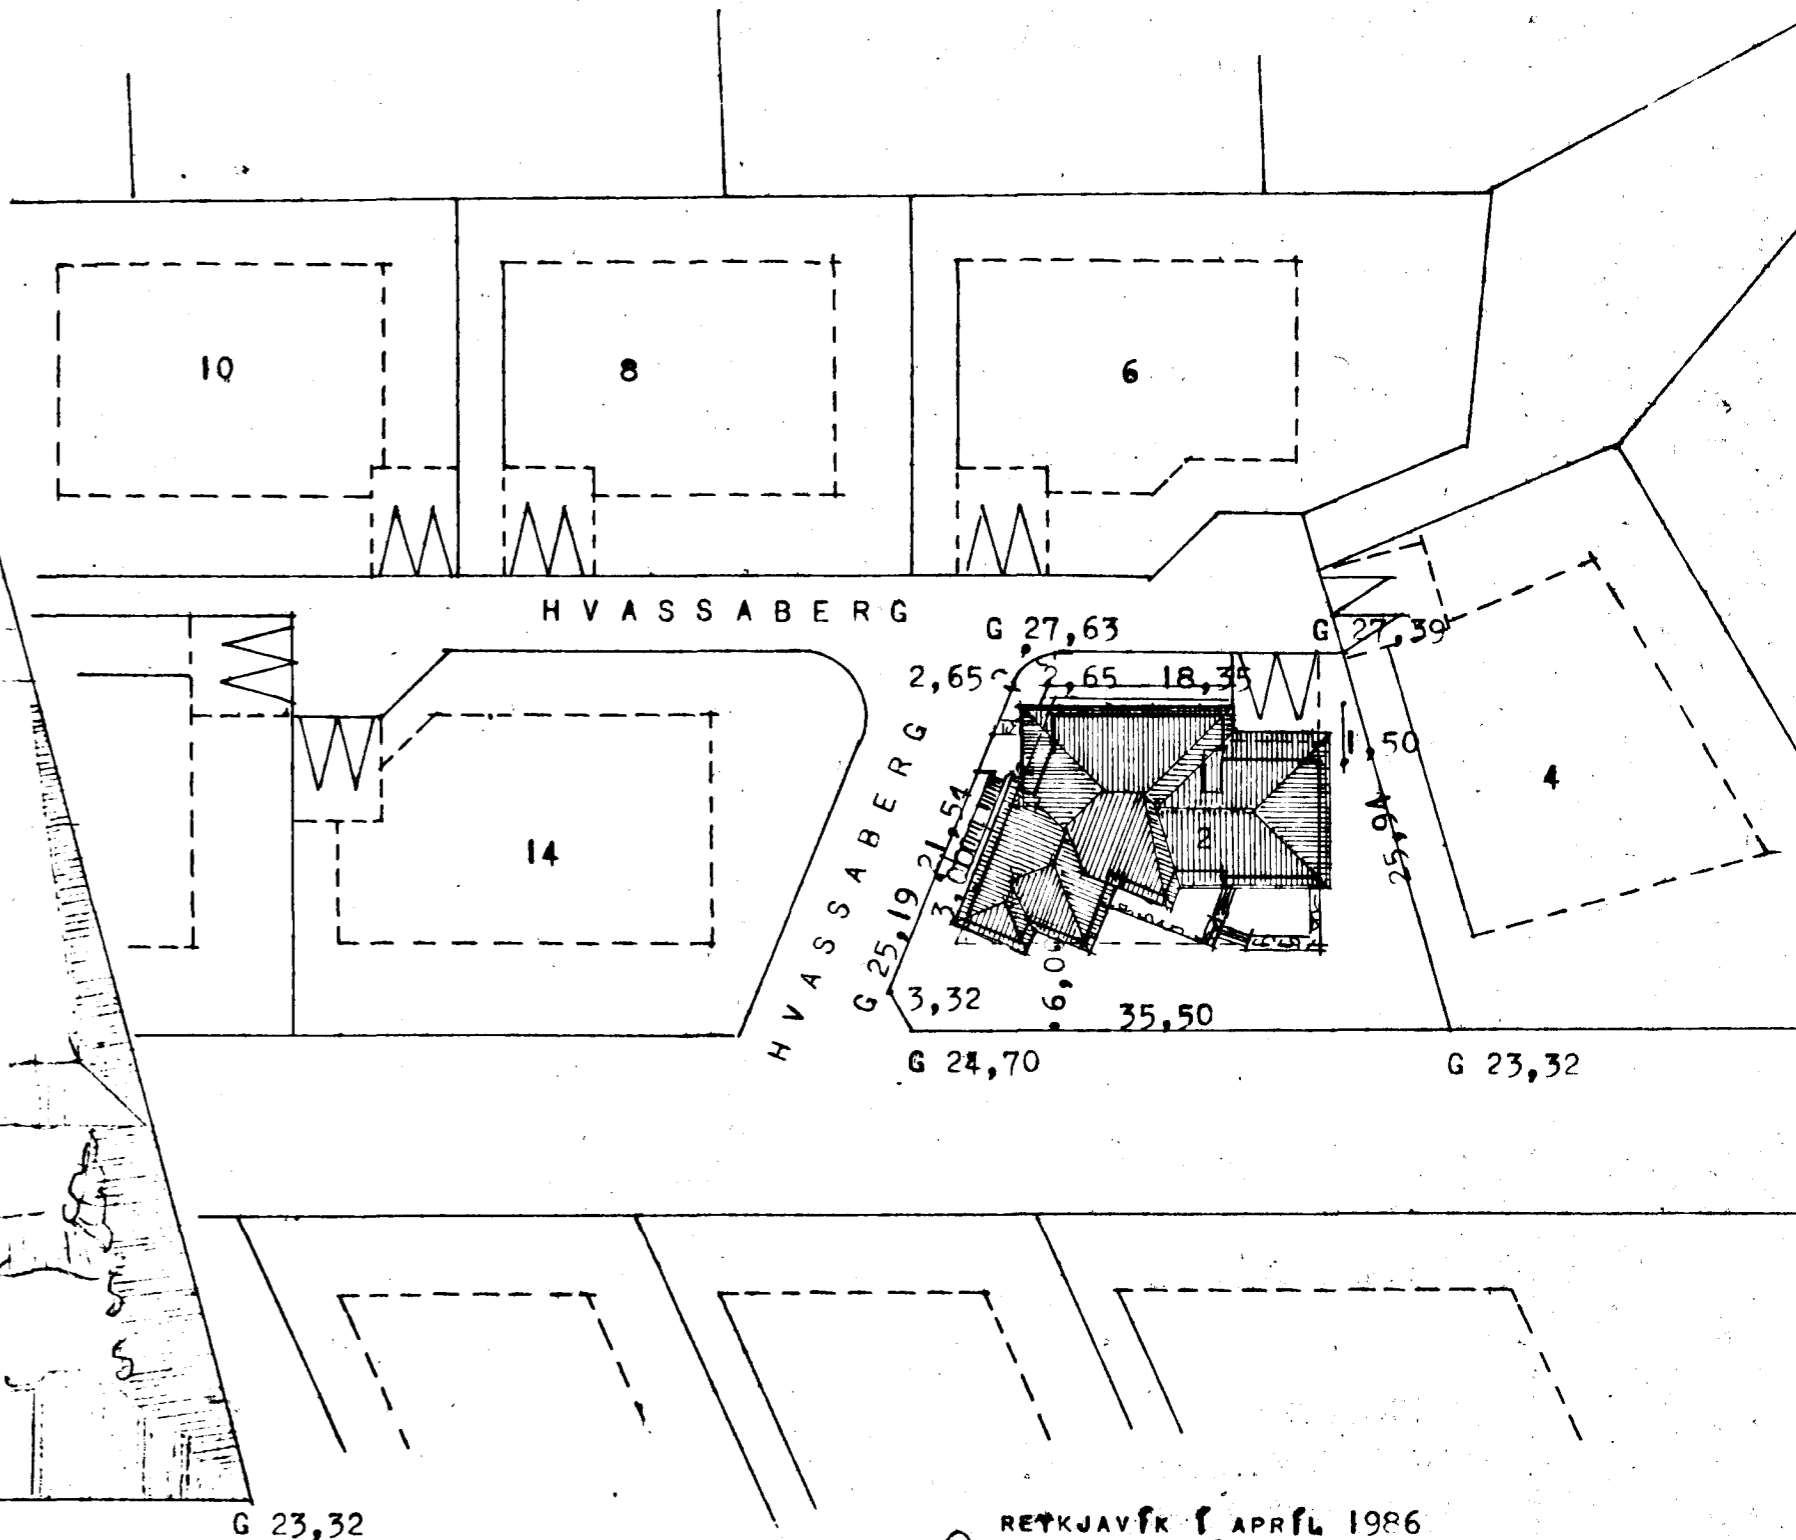

RETKJAVIK 1. APRÍL 1986
Einar H