



Húsið Hverfisgata nr. 48
Breyting
Mál 1:100

Sp. 7/8 1959

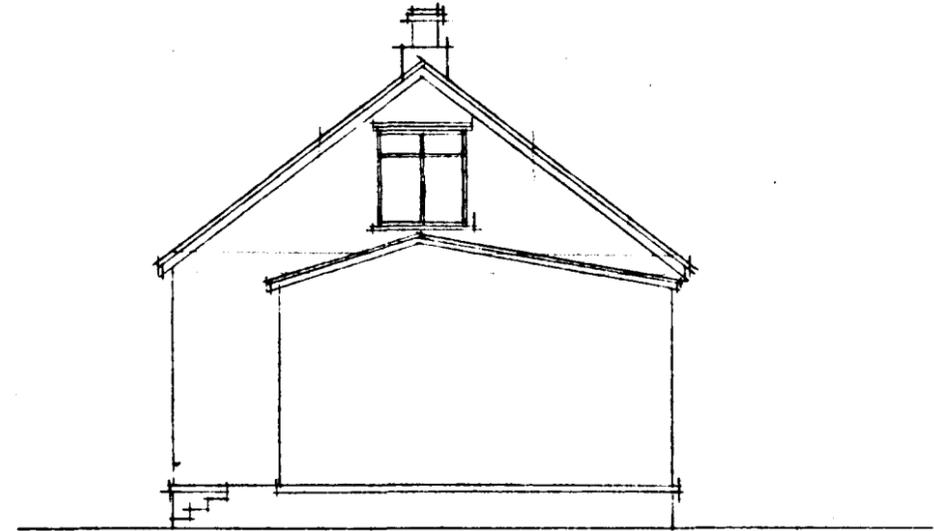

Norður

tifftopdf - ^{vestur}www.rubissoftware.com - Demo Version

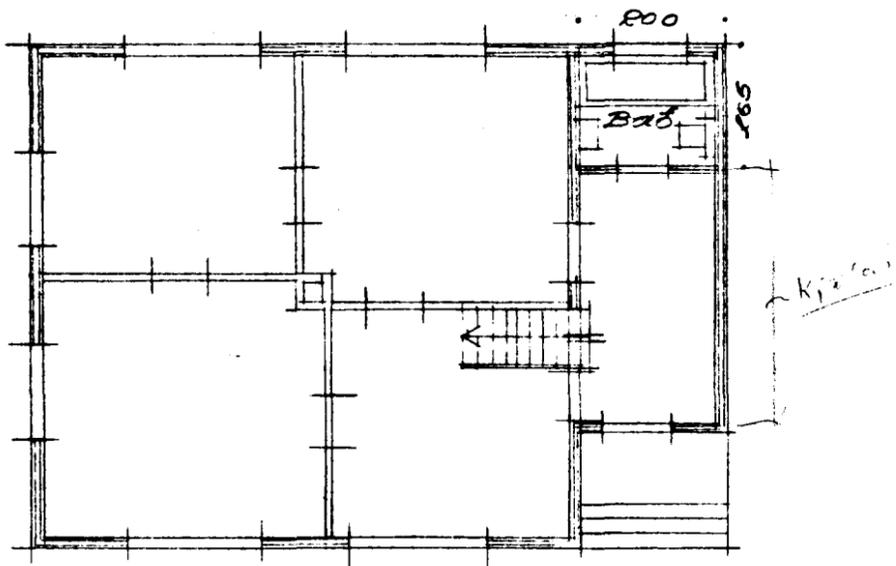

Ásuvarmynd

Háskólinni 5-8-1959
Stefan Sigurðsson