


Sampykkt á fundi bygginga-  
nefndar þ. 15.9. 1993  
BYGGINGAFULLTRÚINN  
Í HAFNARFIRÐI  
Sigrún Halldóttir

FYRIR BREYTINGU




SÚÐVESTUR

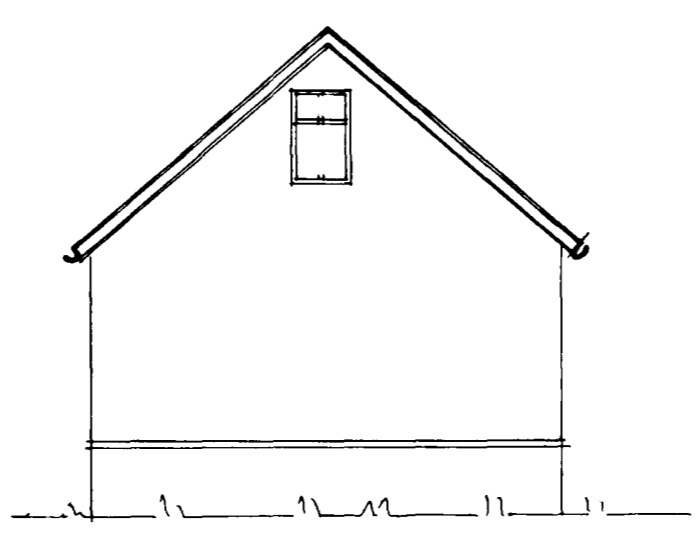

NORÐVESTUR




NORÐAUSTUR

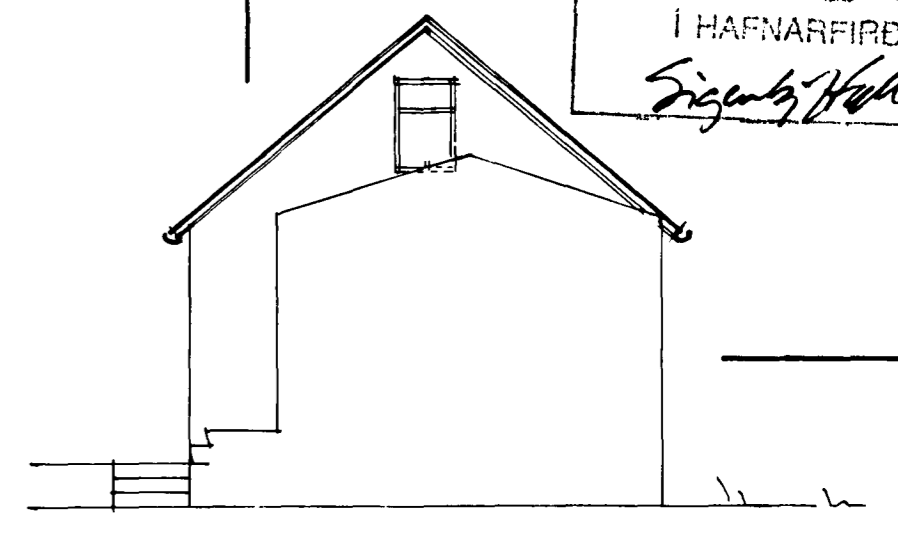


SÚDAUSTUR

EFTIR BREYTINGU

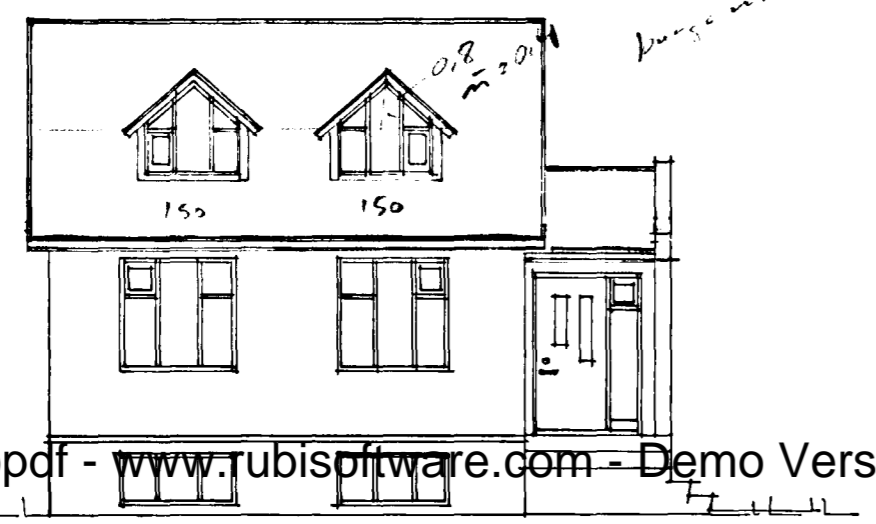


SÚÐVESTUR

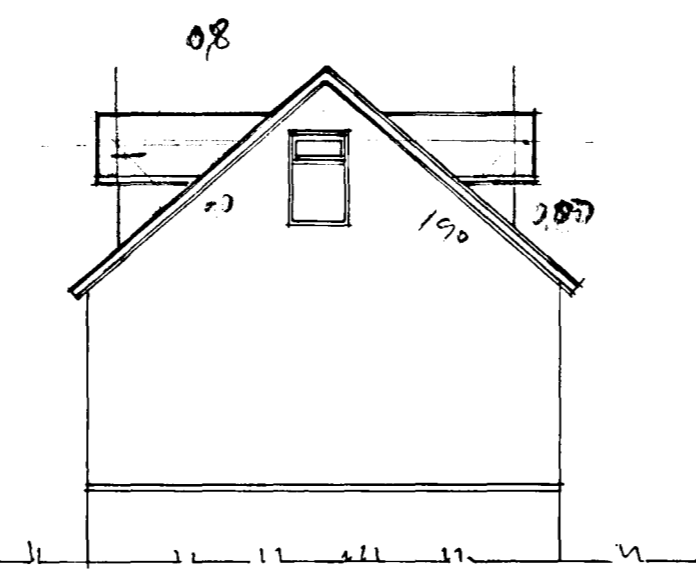

NORÐVESTUR




NORÐAUSTUR

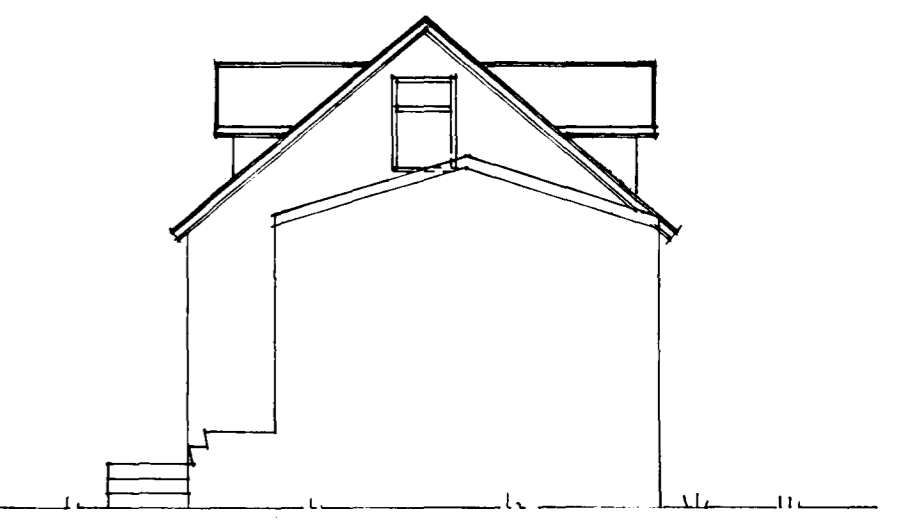


SÚDAUSTUR

*Gluggabreyting*



tifftopdf - www.tubissoftware.com - Demo Version

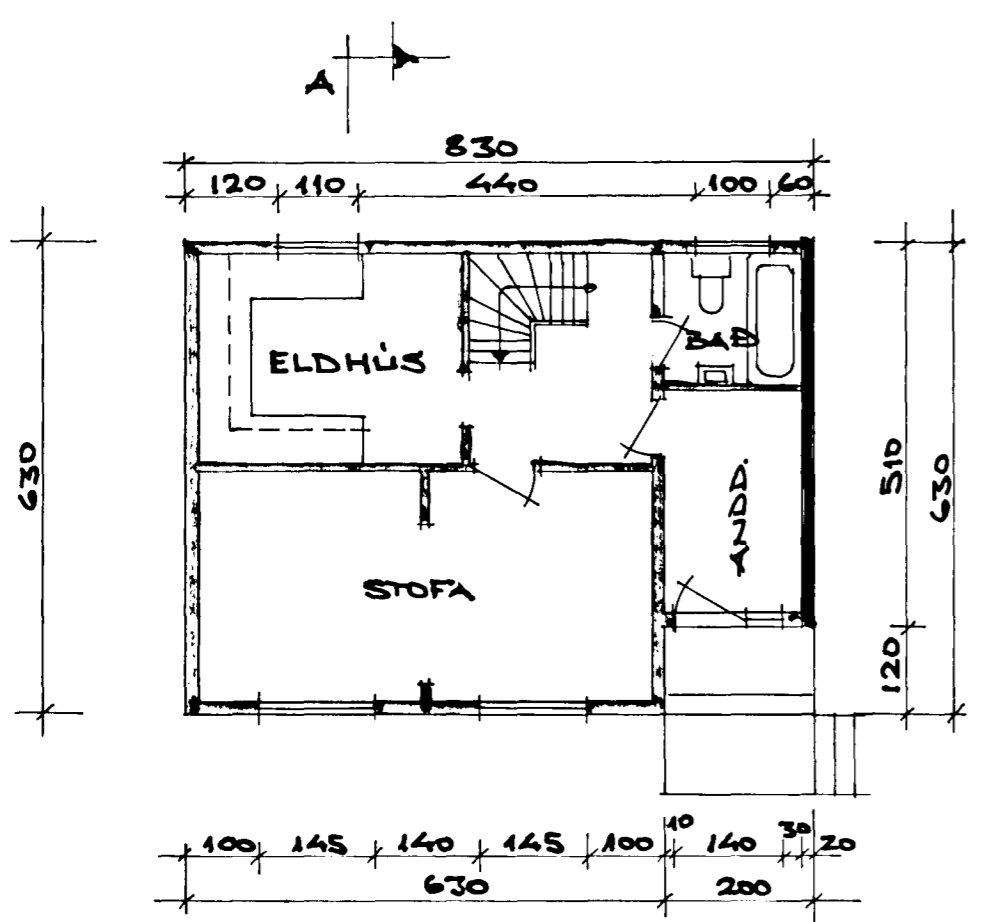

GRUNNMYND M 1:100

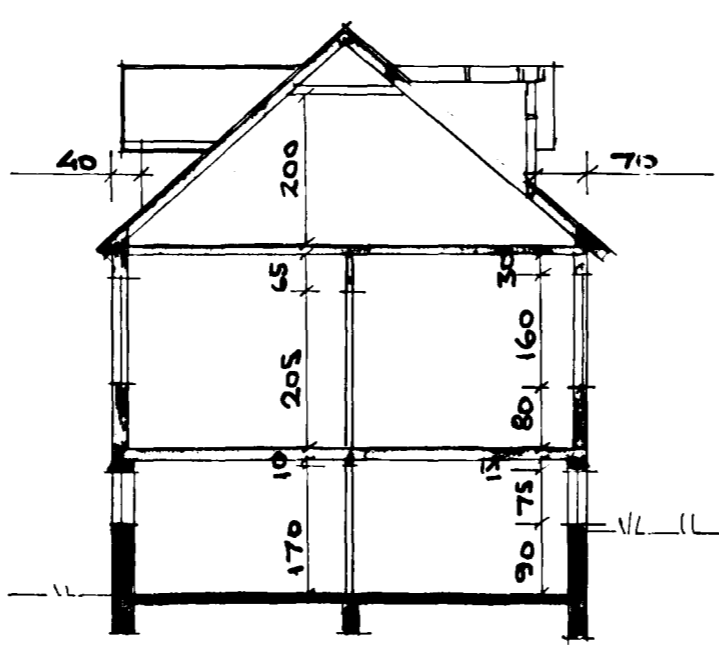

SNID X-A M 1:100

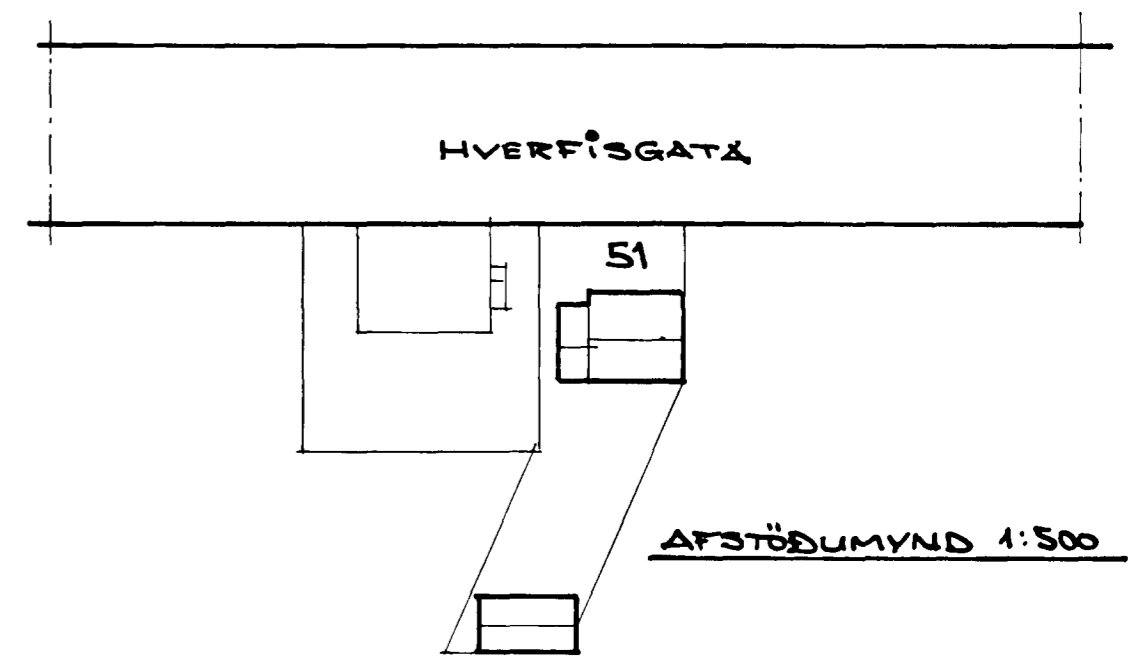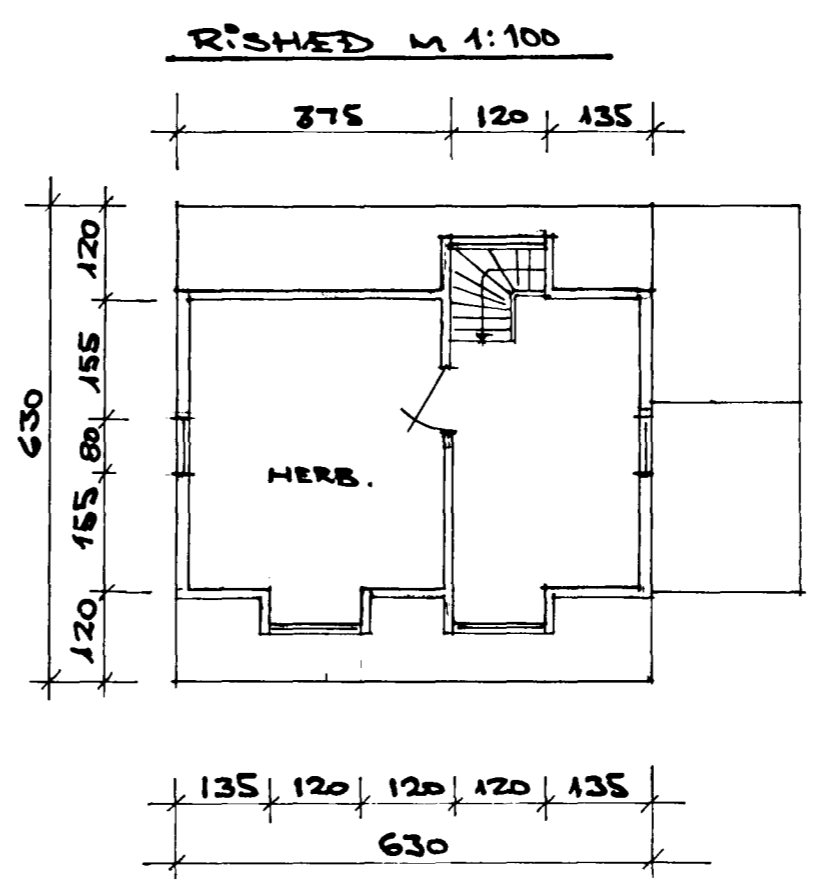

$F = 3 \times \frac{1,9 \times 0,8}{2} = 2,28 \text{ m}^2 = 0,7\% \times 3$   
 $R = 2,28 \times 1,5 = 3,42 \times 3 = 10,26 \text{ m}^3 = 10 \text{ m}^3$

VILMAR ÞÓR KRISTINSSON BYGGINGARTÆKNIFR.		HVERFISGATA NR 51 HAFNARFIRÐI	
TEKEN VPK	SEPT 1993	ÚTLITSBREYTING:	
TEKEN VPK	MÁL: 100/500	ÞEIR NÝSIR KVÍSIR.	