



Grunnmynd ris
 mkv. 1:50

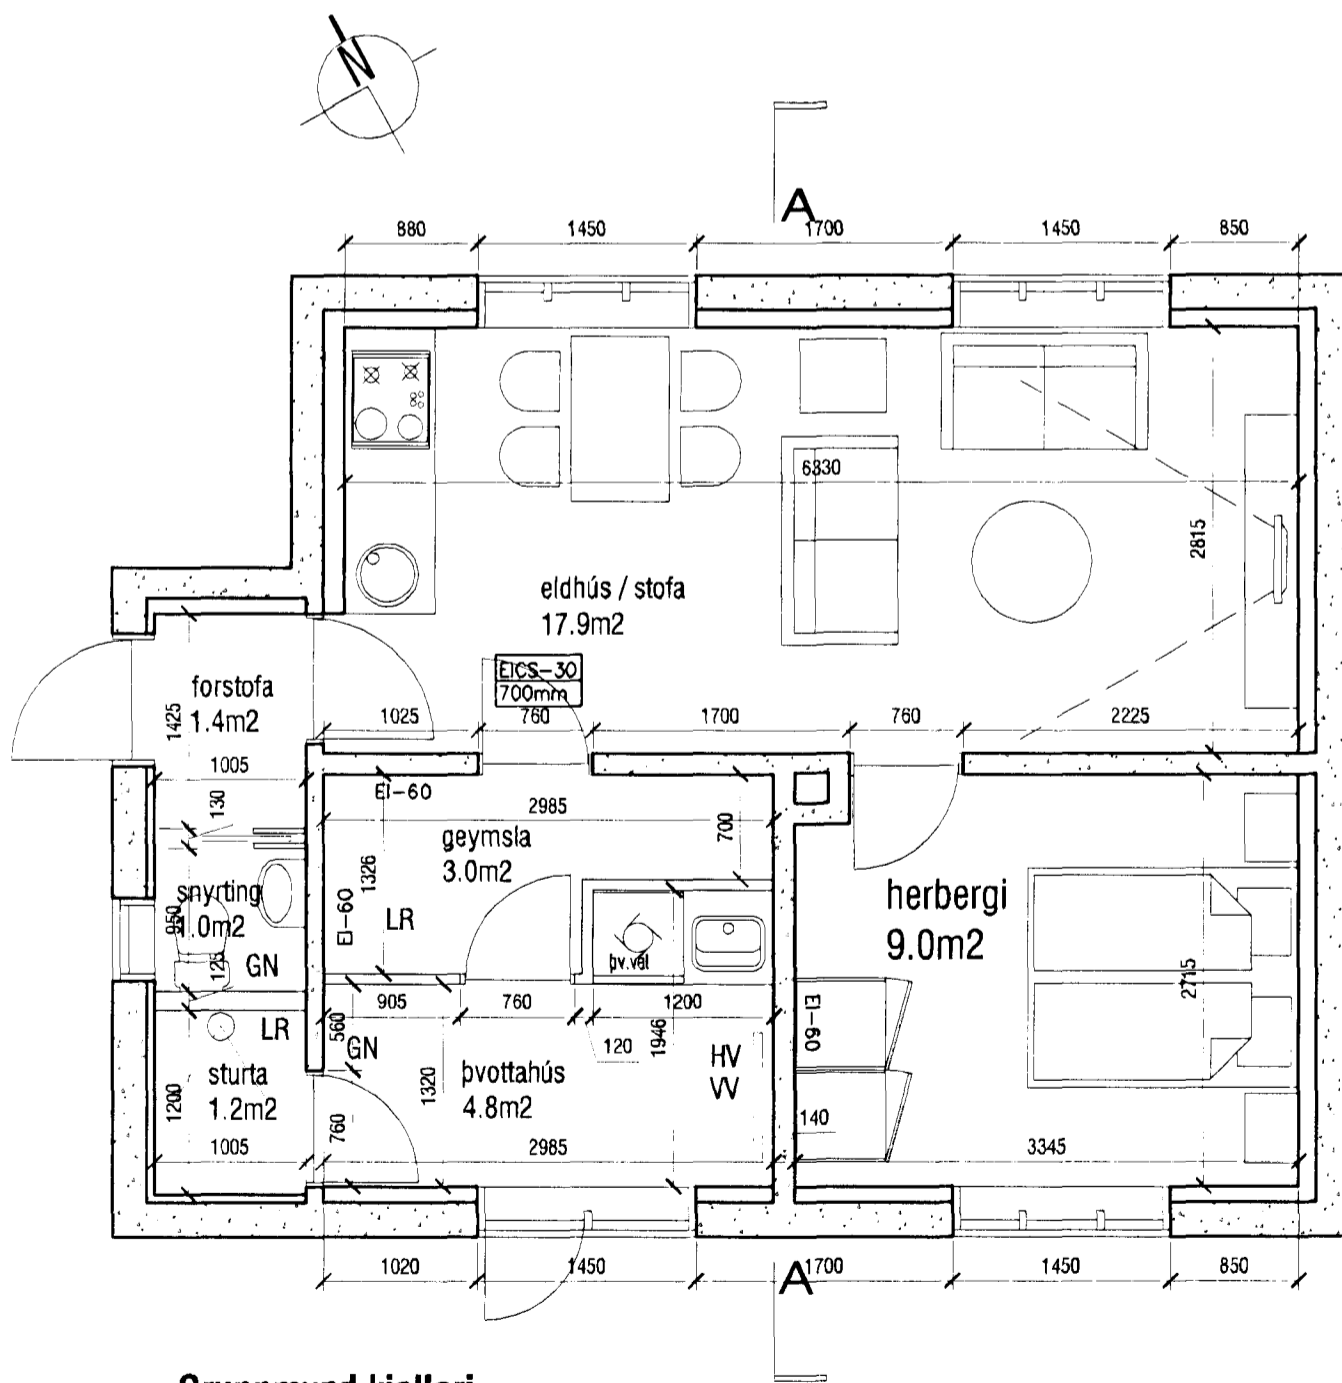

Grunnmynd kjallari
 mkv. 1:50

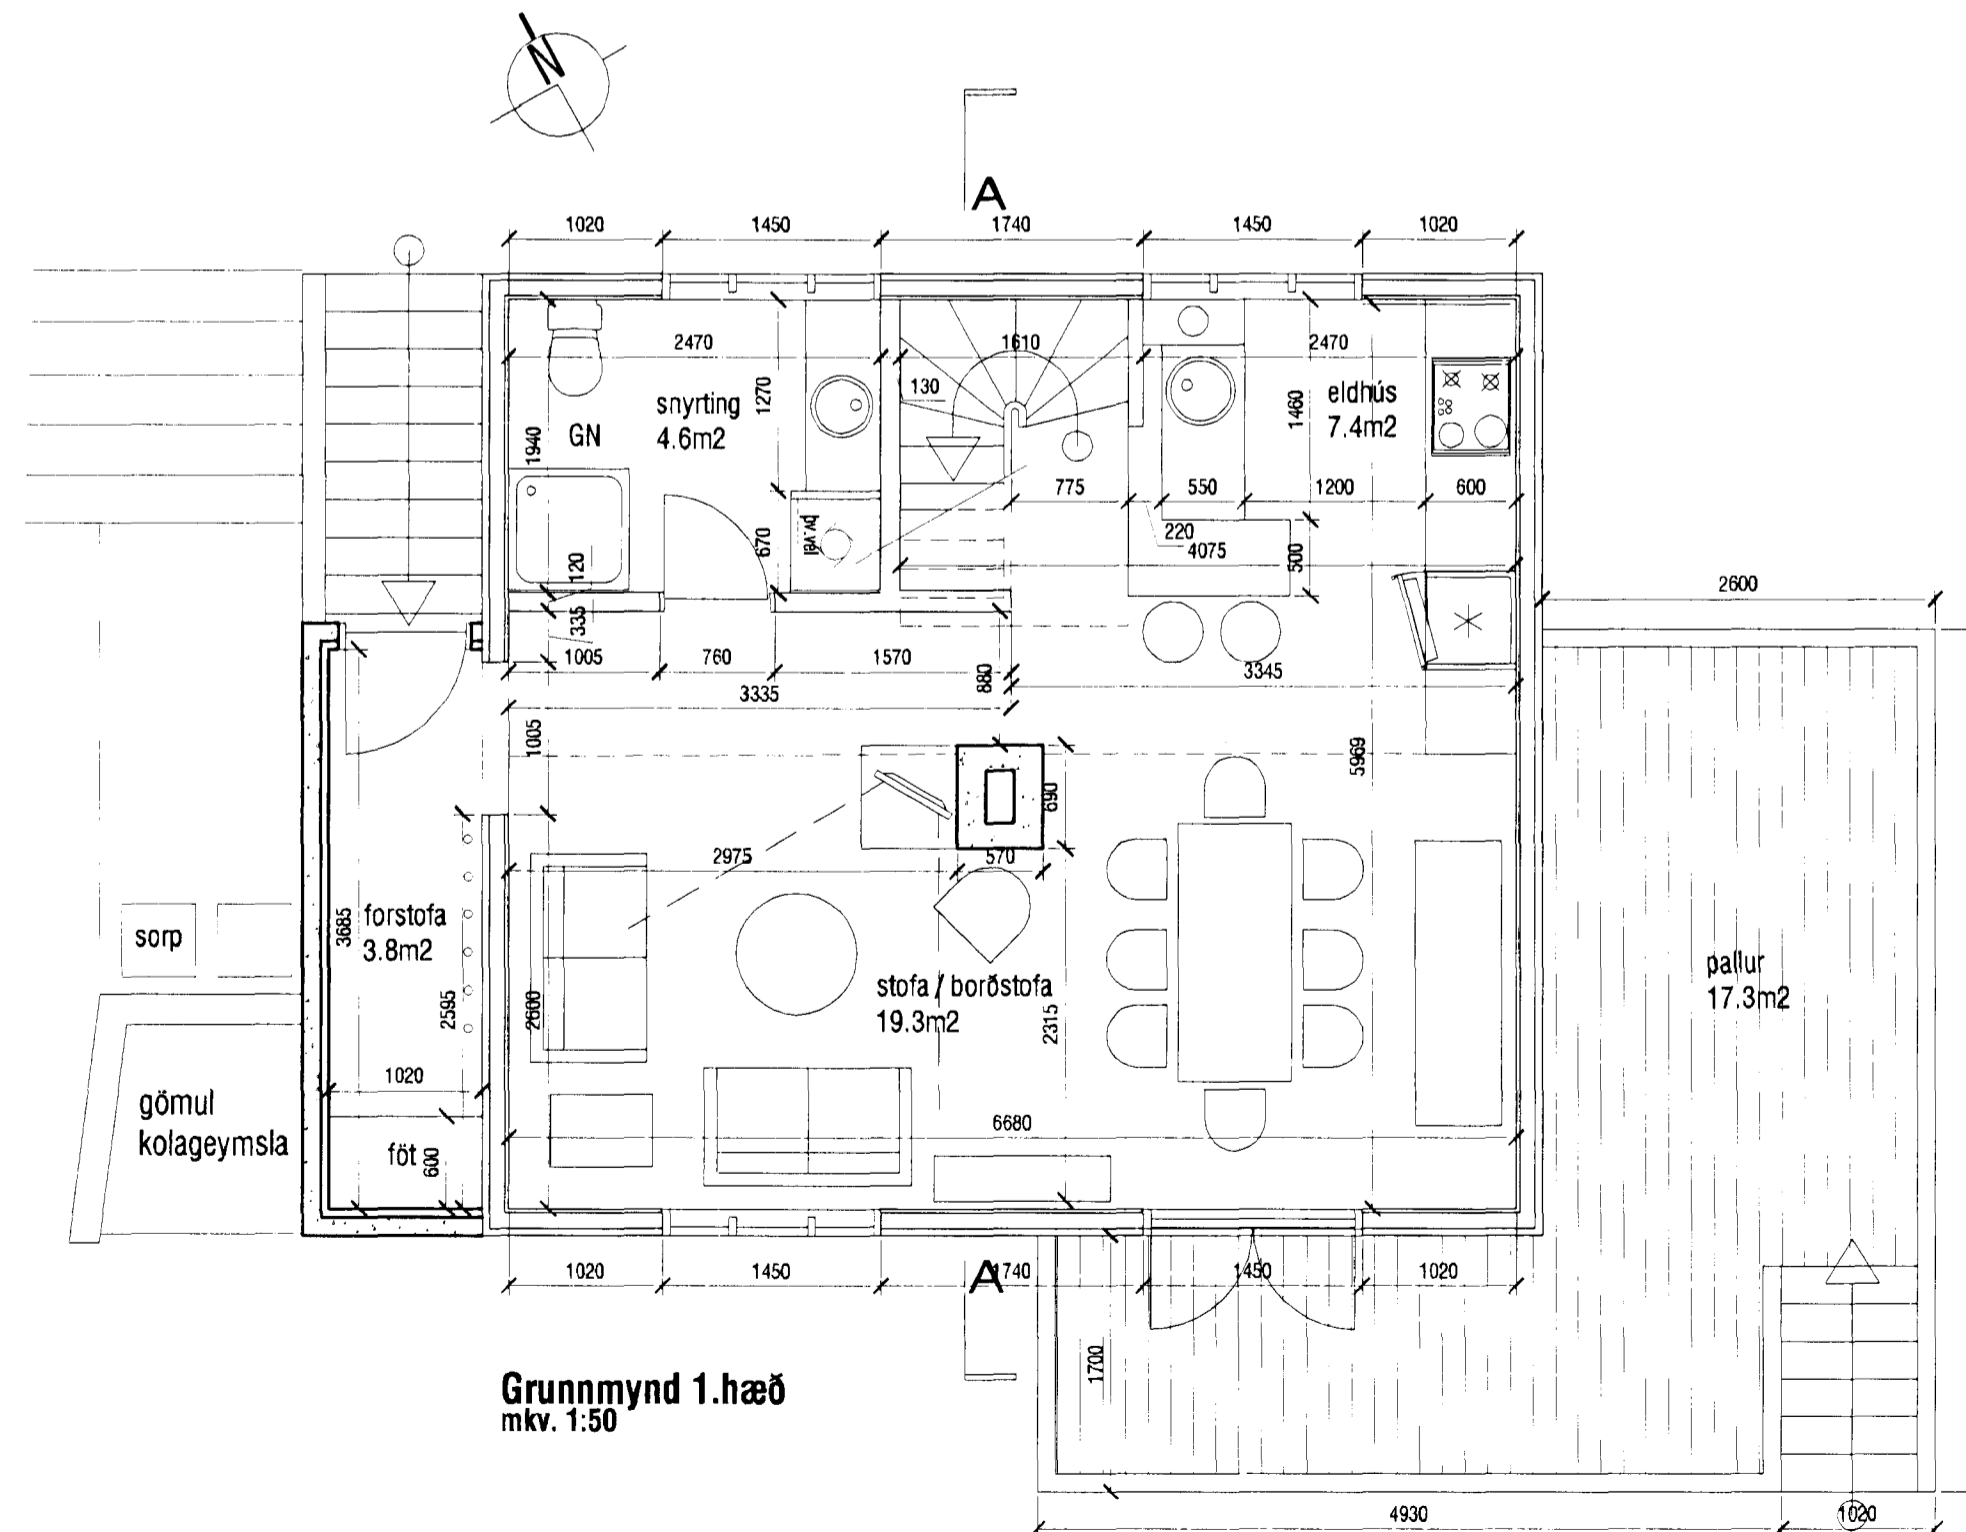

Grunnmynd 1.hæð
 mkv. 1:50

verkstæði arkitekta
 KARI EIRIKSSON arkitekt FAI - kt: 070365-4059 - VERKSTÆÐI ARKITEKTA ehf
 Guðnarssundi 5 - 220 Hfj. - sími: 565 9779 - email: aok@aok.is - www.aok.is

HVERFISGATA 52 - HAFNARFJÖRÐUR 10/09
 Reyndarteikning / breytingar

VERKTEIKNING mkv. 1:50
 grunnmyndir 0301

hannað: KE teiknað: KE dags 6.sept. 2010

breyting A:
 breyting B:
 breyting C:
 breyting D: