

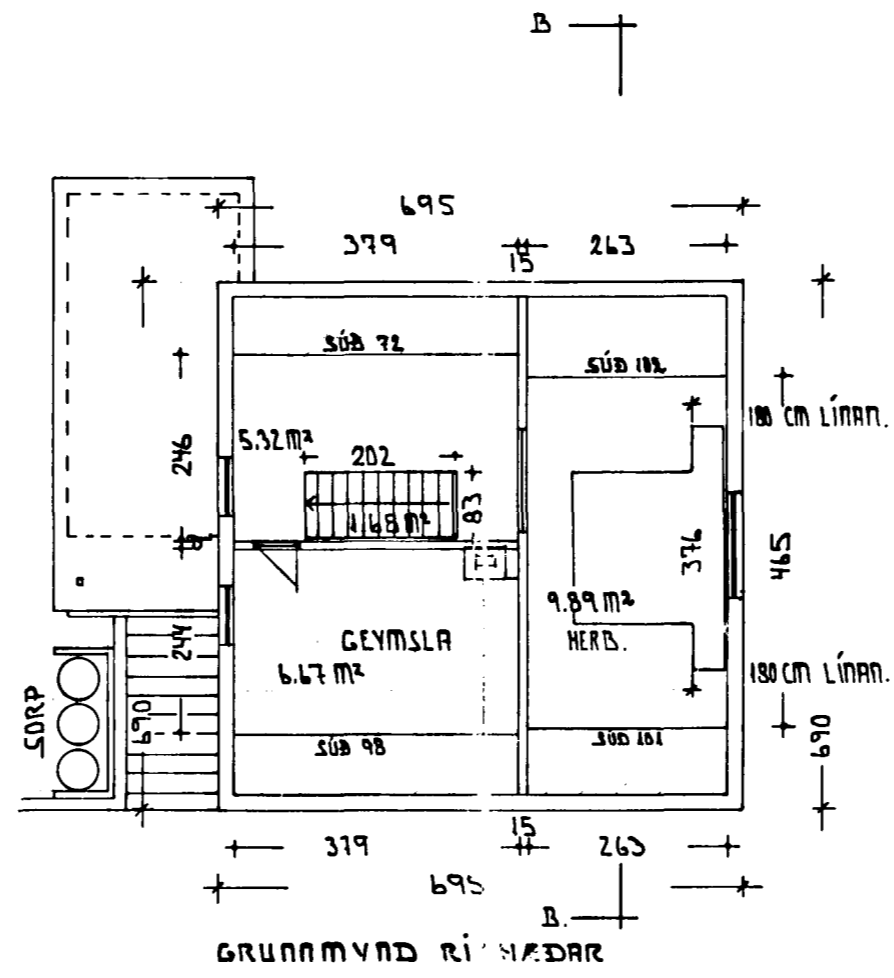
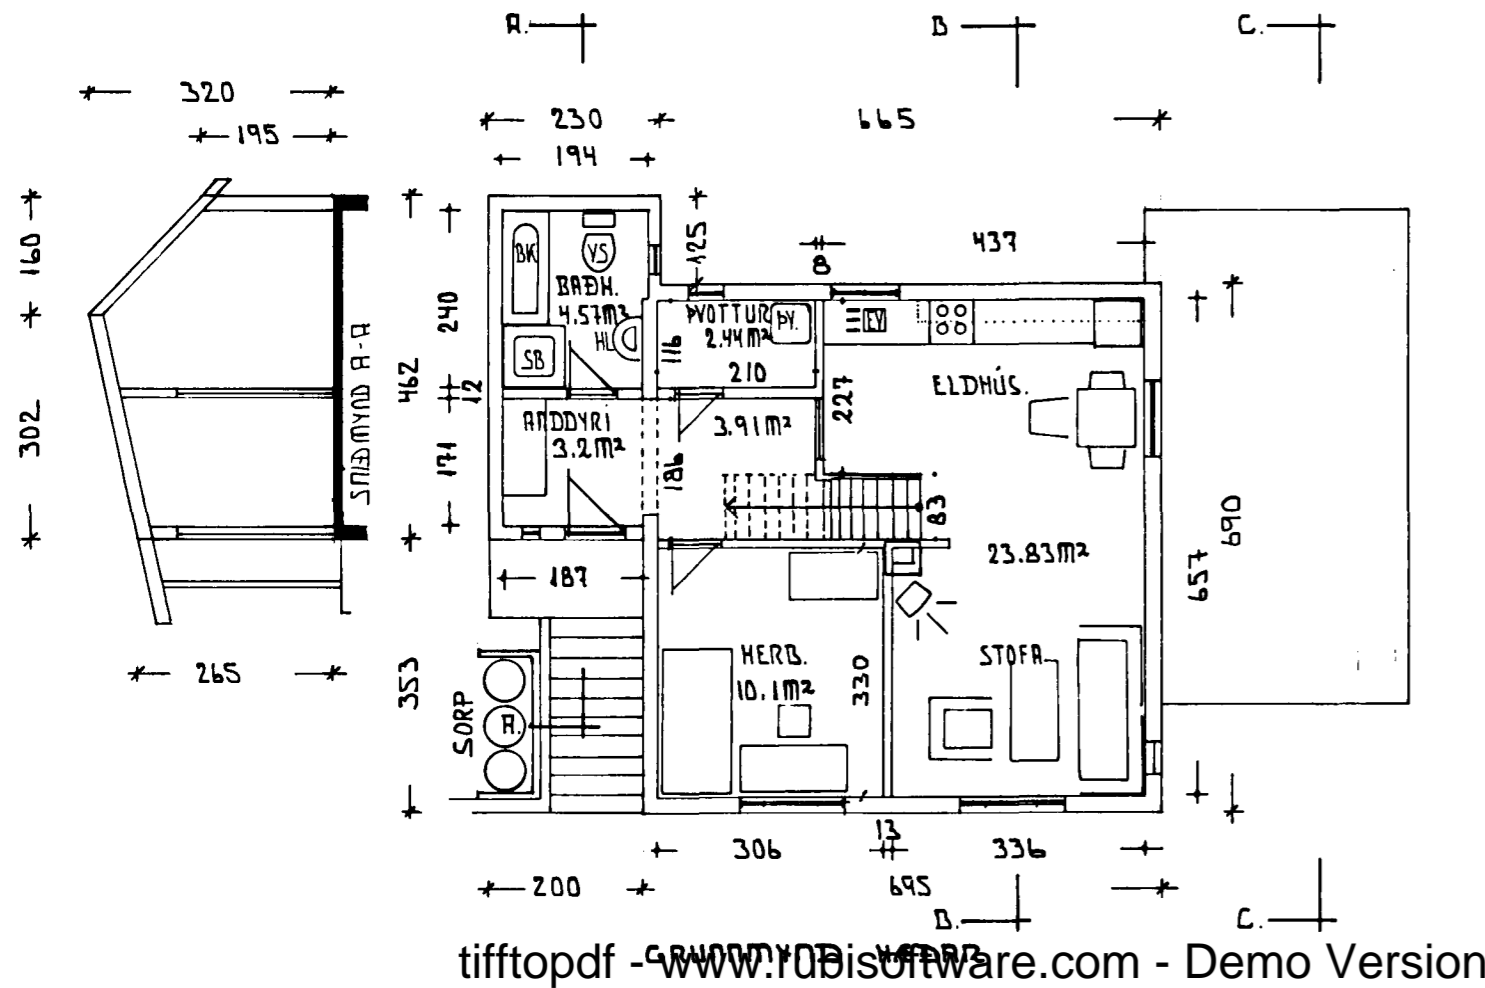


Samþykkt á fundi bygginga-  
nefndar þ. 13 / 10 1993  
BYGGINGAFULLTRÚINN  
Í HAFNARFIRDI  
*Pósthjón þórunn*

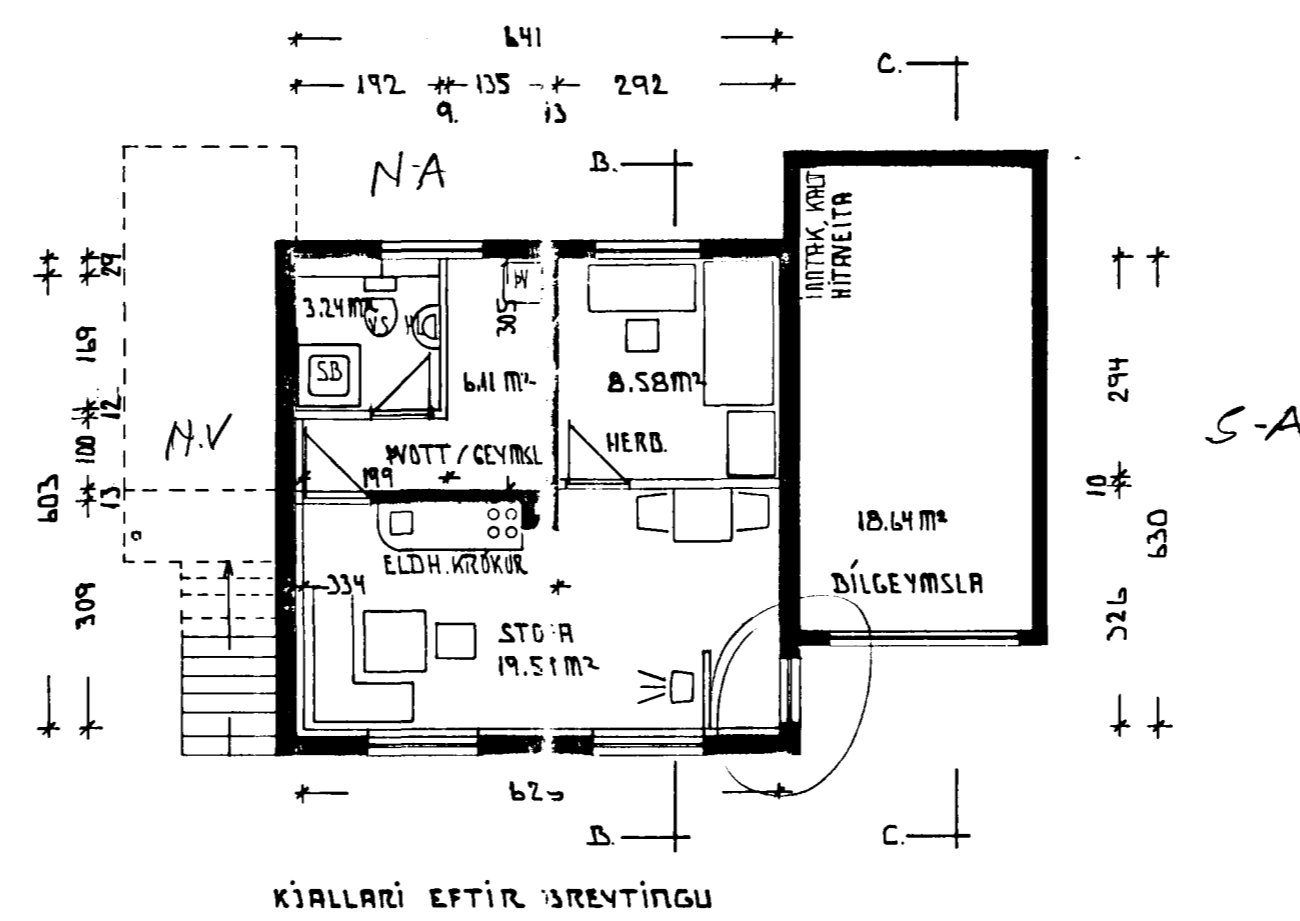

	BRÚTTO	BRÚTTO	NETTO
RIS	88.7 m <sup>3</sup>	26.1 m <sup>2</sup>	23.6 m <sup>2</sup>
HÆÐ	165.0 m <sup>3</sup>	57.6 m <sup>2</sup>	48.1 m <sup>2</sup>
Samtals:	253.7 m <sup>3</sup>	83.7 m <sup>2</sup>	71.7 m <sup>2</sup>
BILGEYMSLA	55.0 m <sup>3</sup>	21.6 m <sup>2</sup>	18.6 m <sup>2</sup>
ÍBUD OG BILGEYMSLA:	308.7 m <sup>3</sup>	105.3 m <sup>2</sup>	90.3 m <sup>2</sup>
ÍBUD KJALLARA	117.5 m <sup>3</sup>	48.0 m <sup>2</sup>	37.5 m <sup>2</sup>
ALLT HÚSID:	426.2 m <sup>3</sup>	153.3 m <sup>2</sup>	127.8 m <sup>2</sup>
NÝTINGARHLUTFALL	153.3 / 225 = 0.68		

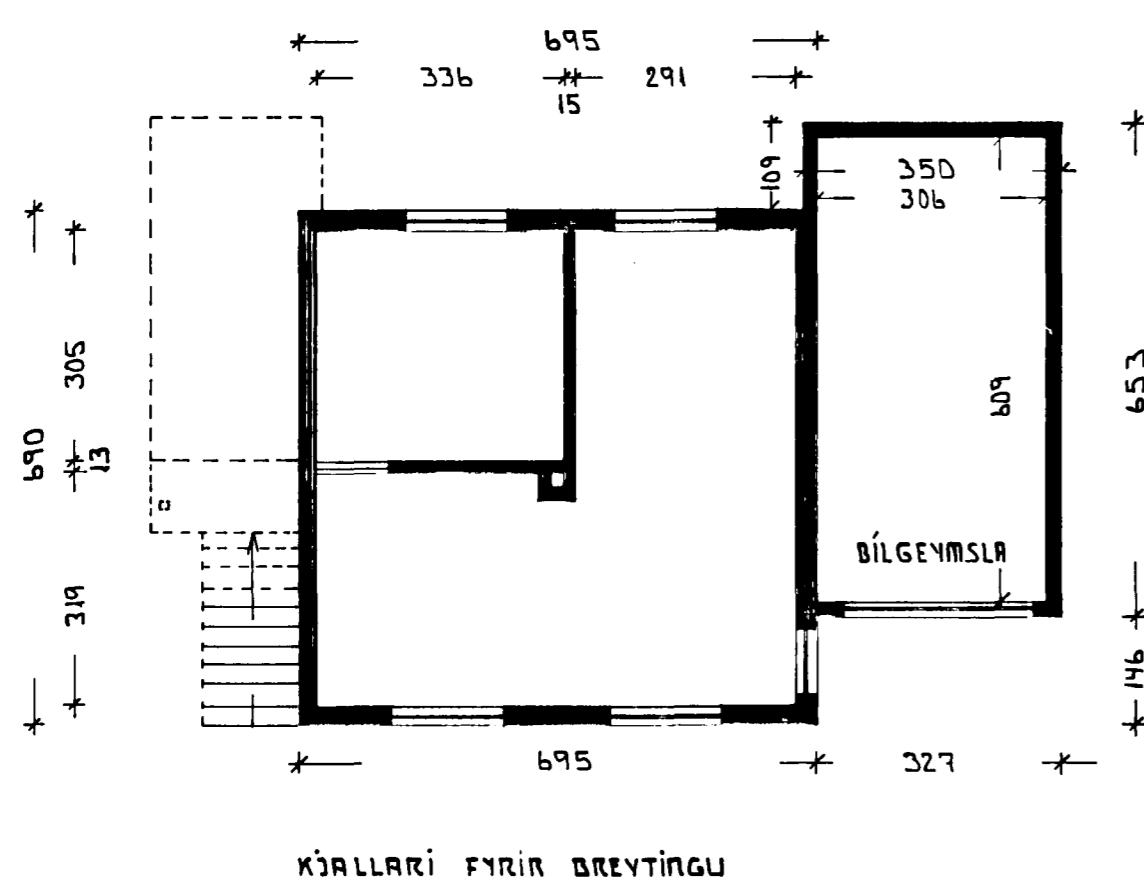

KJALLARI OG BILGEYMSLA STEINSTENPT OG MÚRHUÐAÐ AÐ UTAN.  
HÆÐ OG RIS ÚR TIMBRI OG KLÆTT MEÐ BÄRULJÁRNI.

- ① BK. 6-8.
- ② Glugg. 1.4x0.5 = 0.7 m<sup>2</sup> = 8.2 %
- ③ gólf er undir yfirborði jostvegs allan löngingunni
- ④ mynd

HVERFISGATA 57 HAFNARFIRDI 06.10.1993

GRUNNMYNDIR, KJALLARI, HÆÐ OG RIS. STERDIR. Mkv. 1:100

TEKNIÞJÓNUSTA SVEINS KARLSSONAR TFÍ BÉJARHRAUNI 2 220 HAFNARFJÖRDUR 91-653045 TEIKNING A-1

*Sveinn Karlsson*