






Samþykkt á fundi bygginga-  
nefndar þ. 27.5.1992  
BYGGINGAFLUTRÖNN  
Í HAFNARFÖRÐUR  
*[Signature]*



BREYTINGAR Á YTRA ÚTLITI HÚSSINS HVERFISGÖTU 6A HAFNARFÖRÐUR

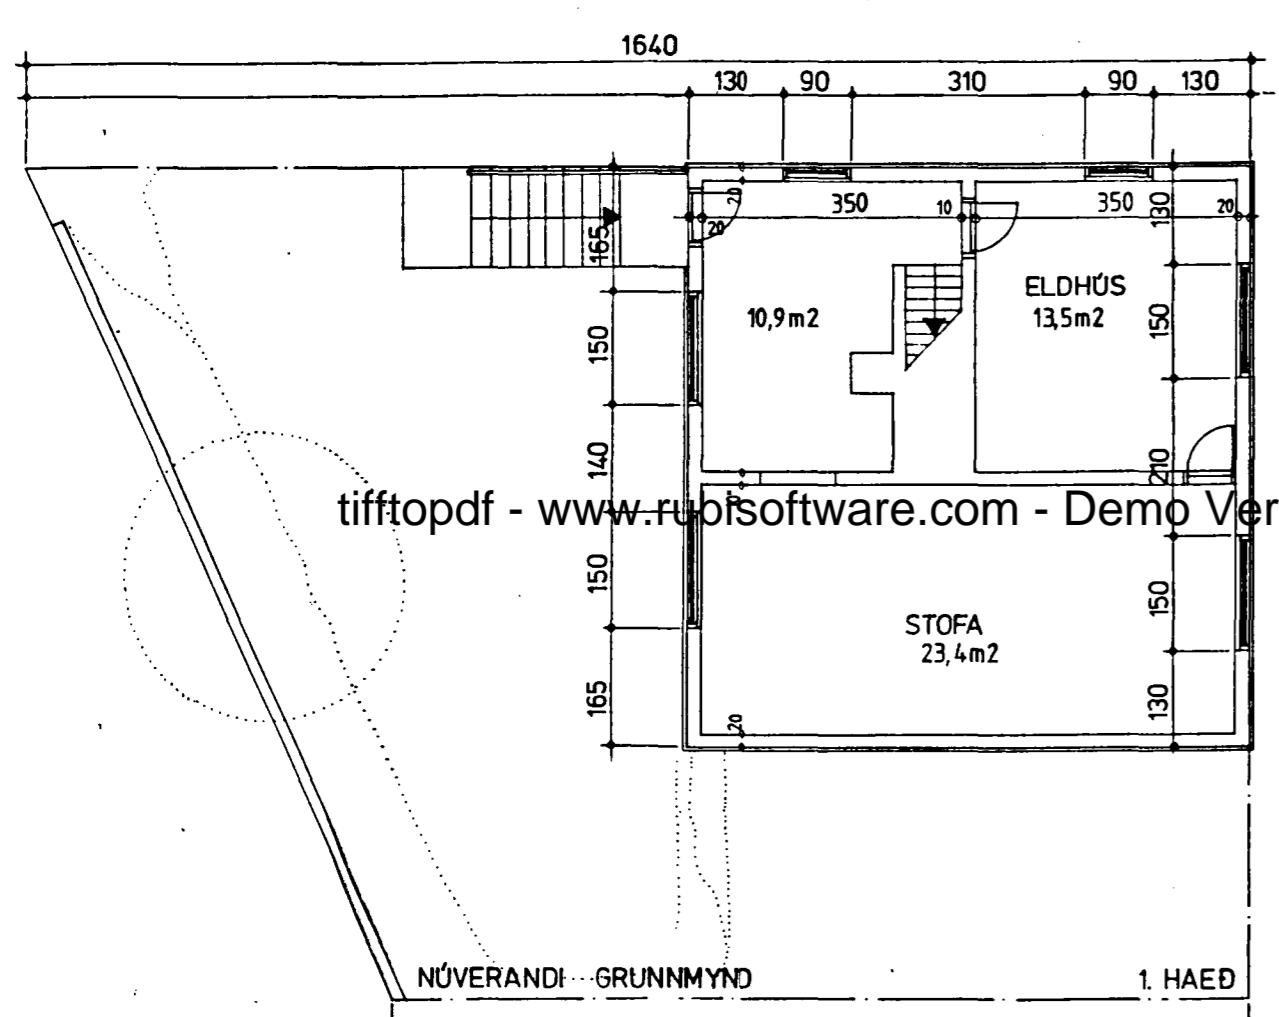

tifftopdf - www.rufissoftware.com - Demo Version

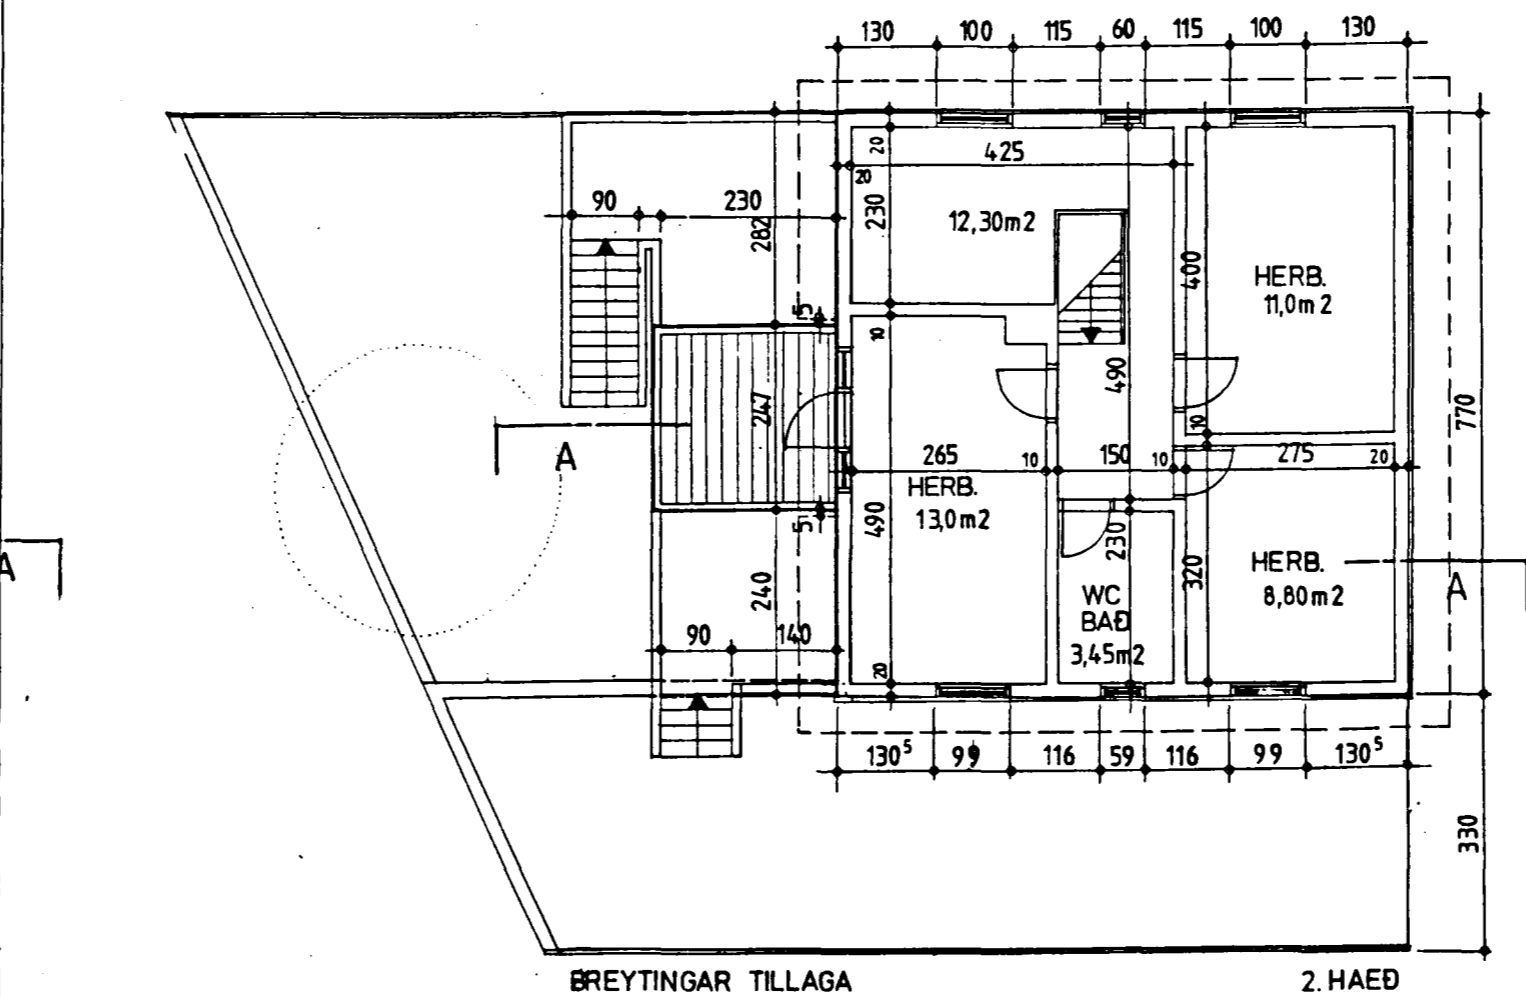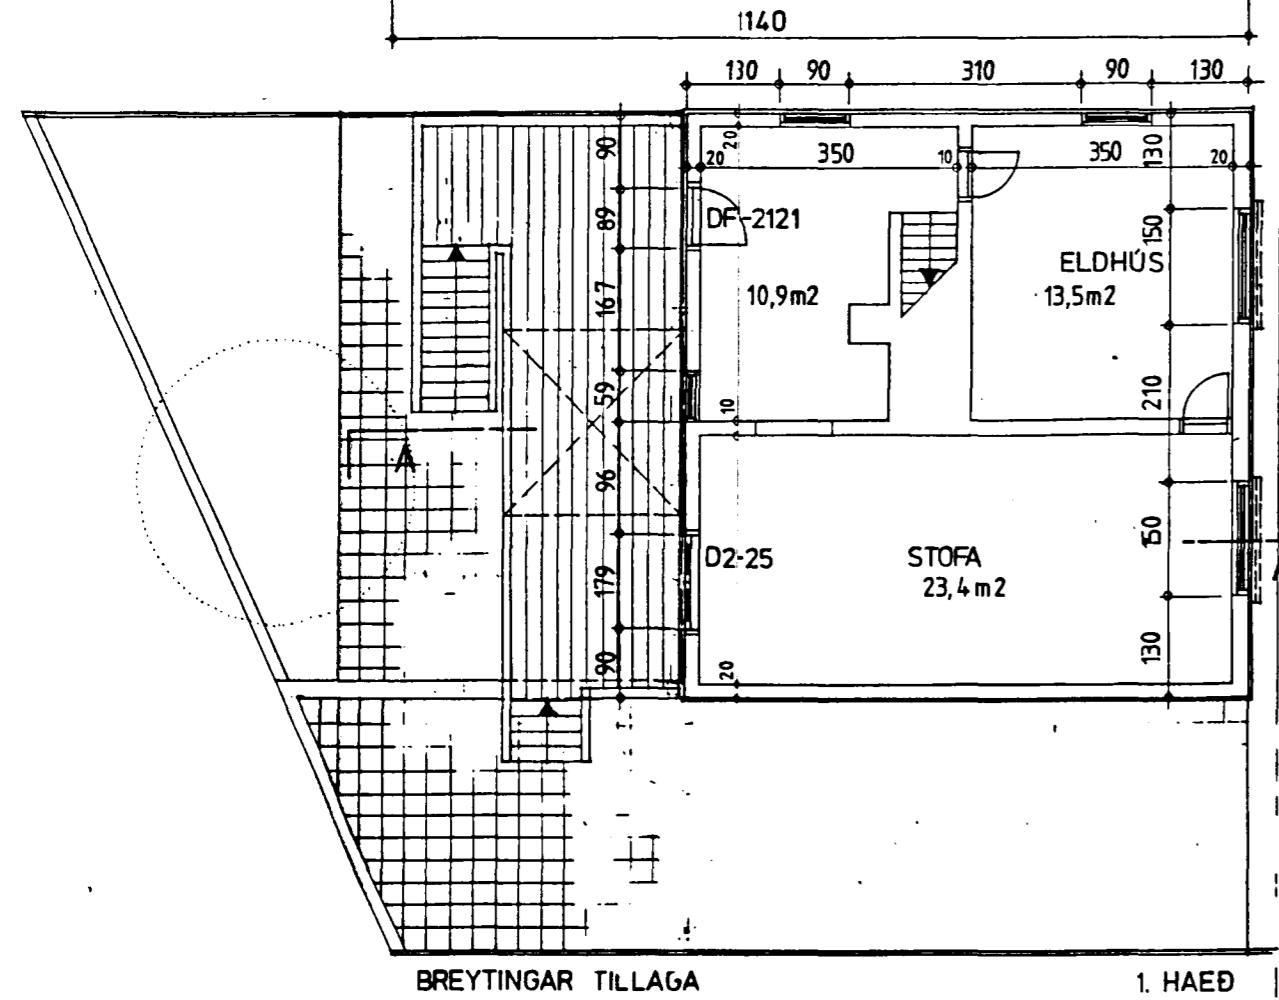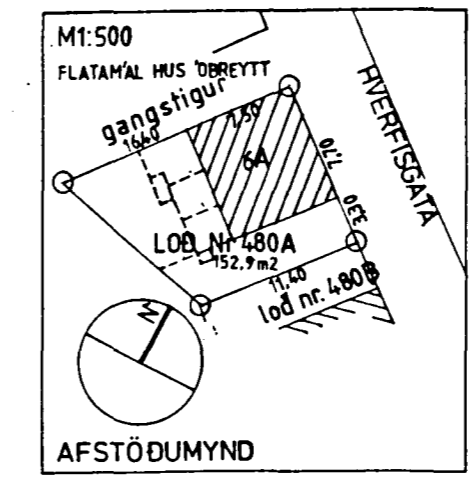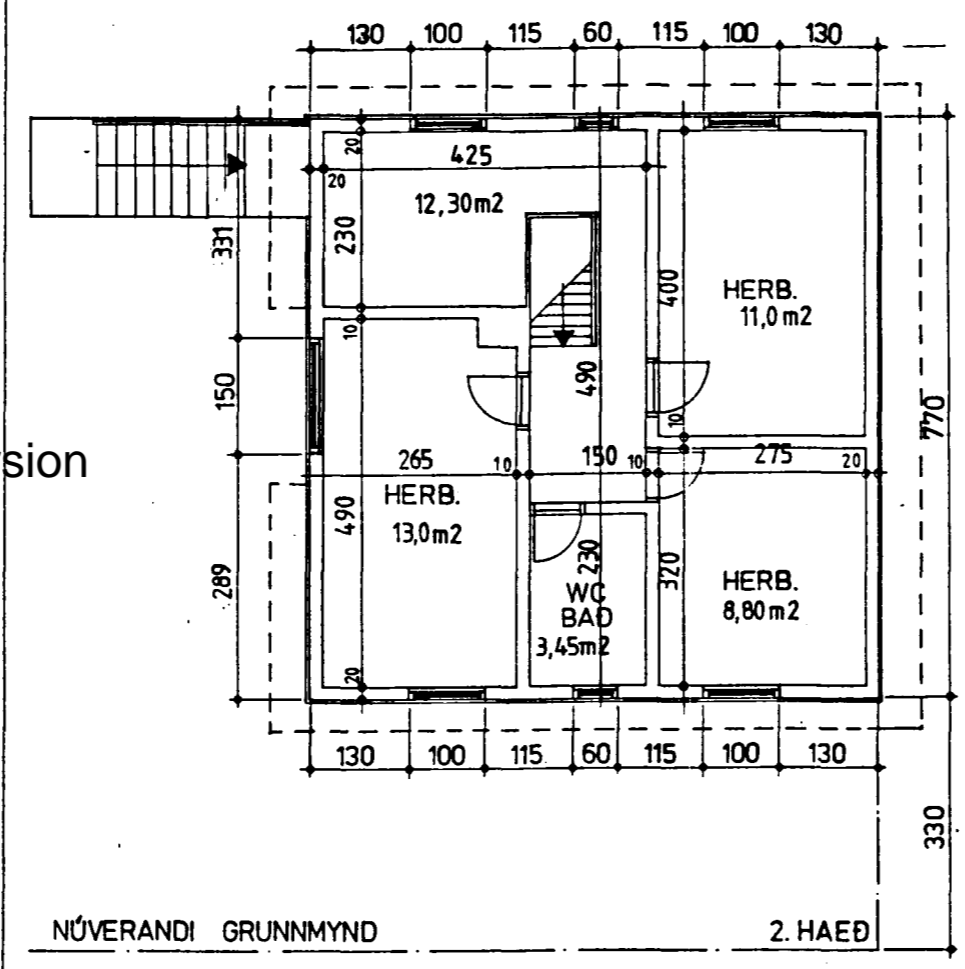

MARTIN HUNTINGDON-WILLIAMS, arkitekt; FAI  
HATUNI 27  
REYKJAVÍK  
SÍMI 91-19762  
FAX 91-19762

HS2/01/71  
22-MAI 1992

*Samb. Ellert M. Jónsson (M.V.F.I.)*