


Kaldakinn nr. 29

Breyting


1:100

Stekkjark.

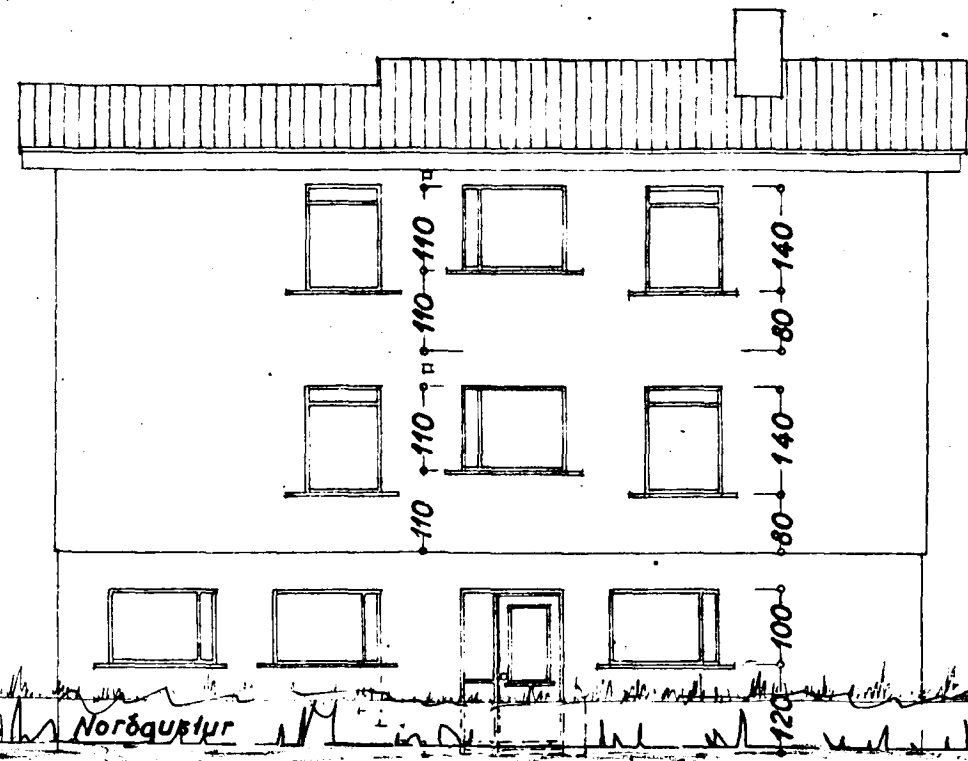

AFSTÖÐUMYND
1:500








Stærð:
hús, 117,24 m²
1020,30 m²
löð, 455,06 m²

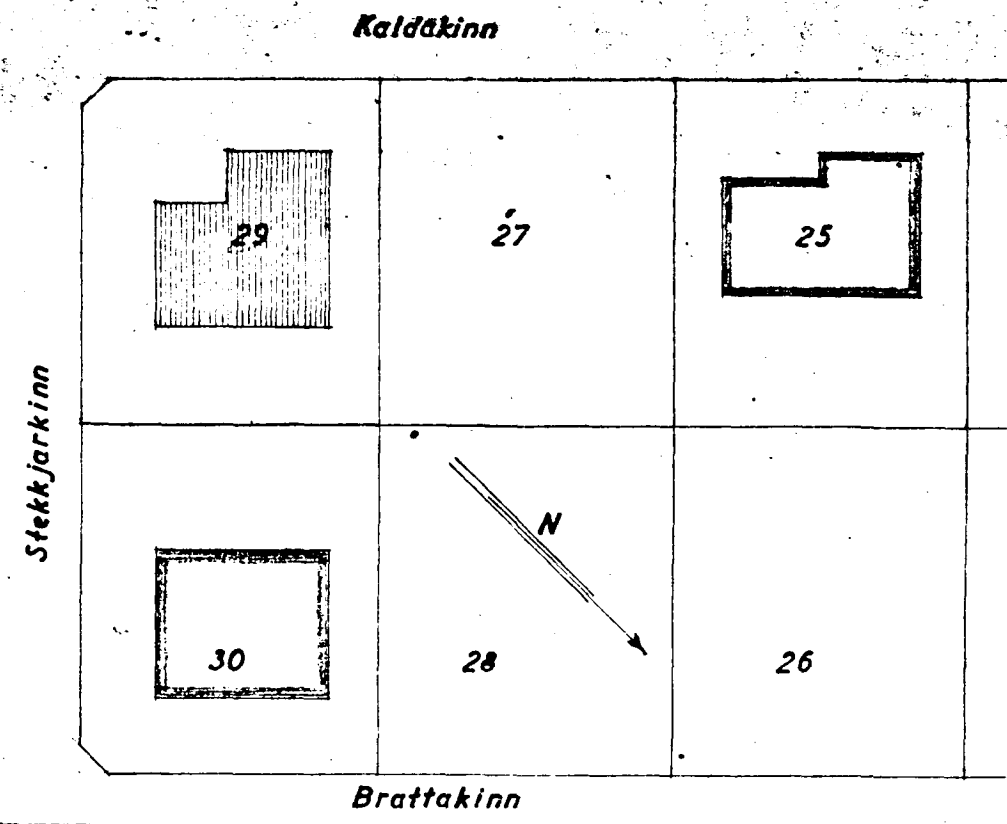

Samþykkt & fundi bygginga-
nefndar þ. 27/2 1963
4/10 1963
BYGGINGAFLUTRÚINN
I HAFNAERDI
S. Sigurðsson

Andas Þimbleysson
HÚSASMÍÐAMEISTARI:
Hafnar Þorsteinsson
MÚRAMEISTARI:
Guðmundur Halldórsson
PIPULAGNINGAMEISTARI:

1m 0 1 2 3 4 5 6 7 8 9 10 15 20 25m 1:100

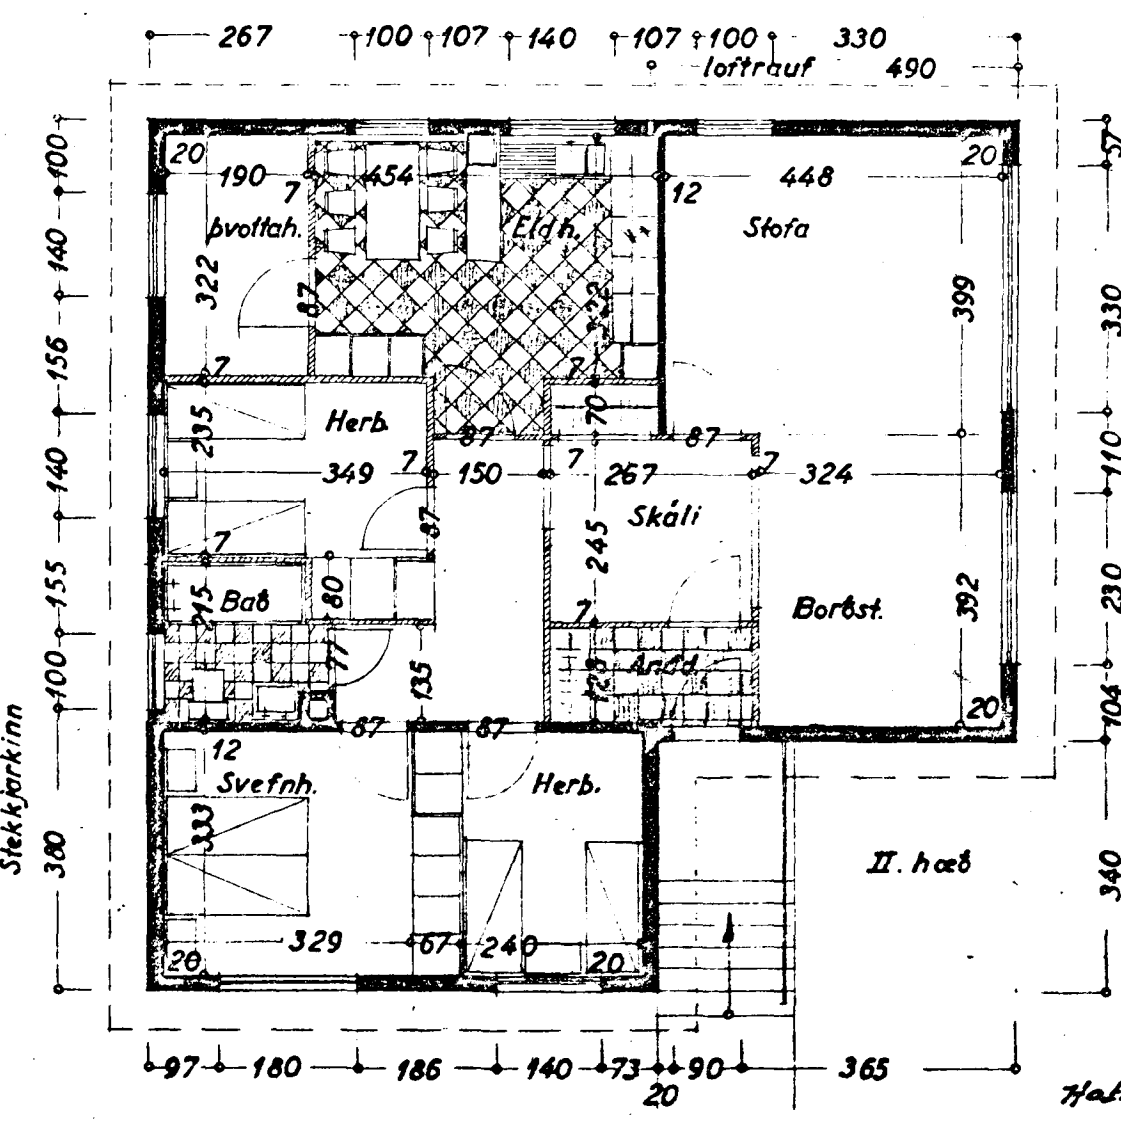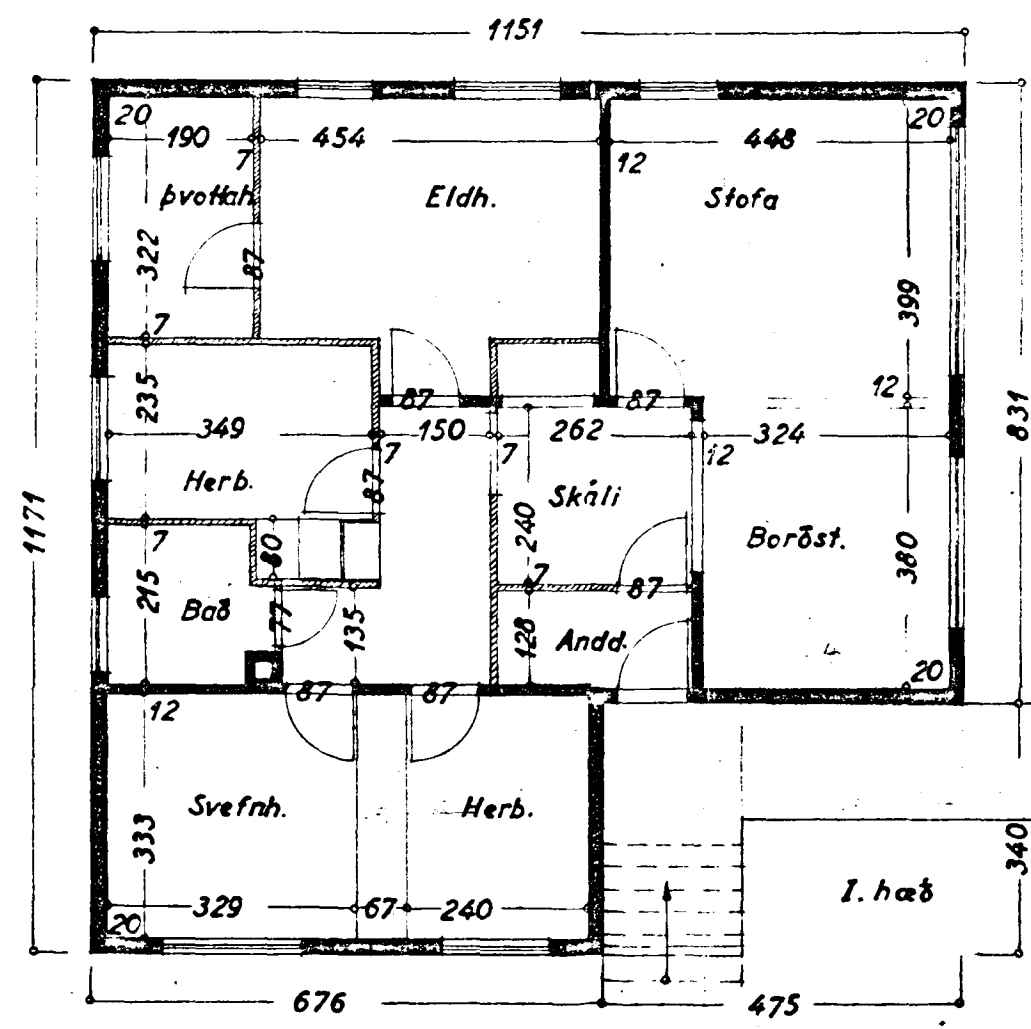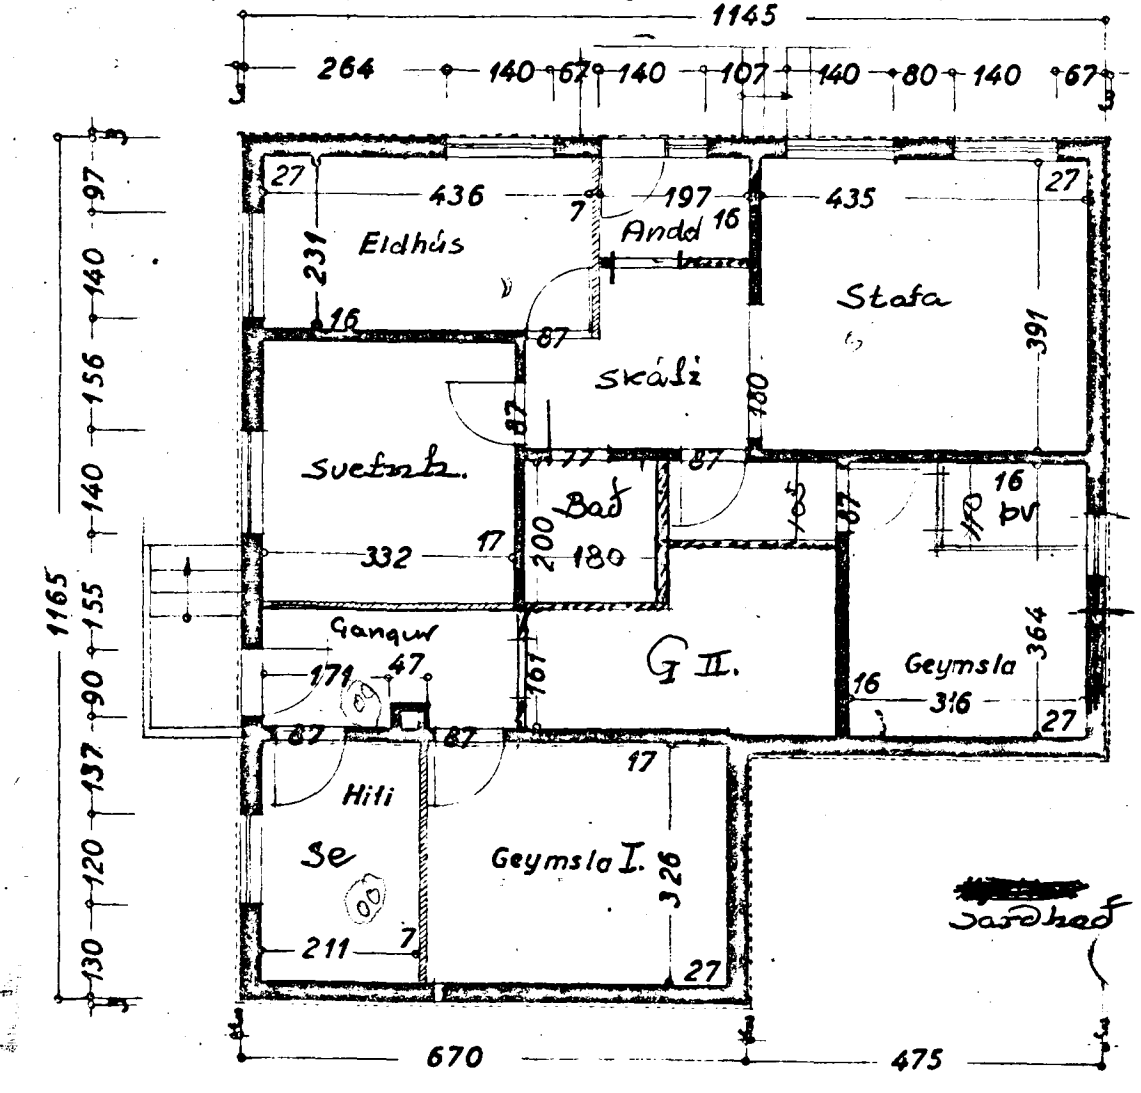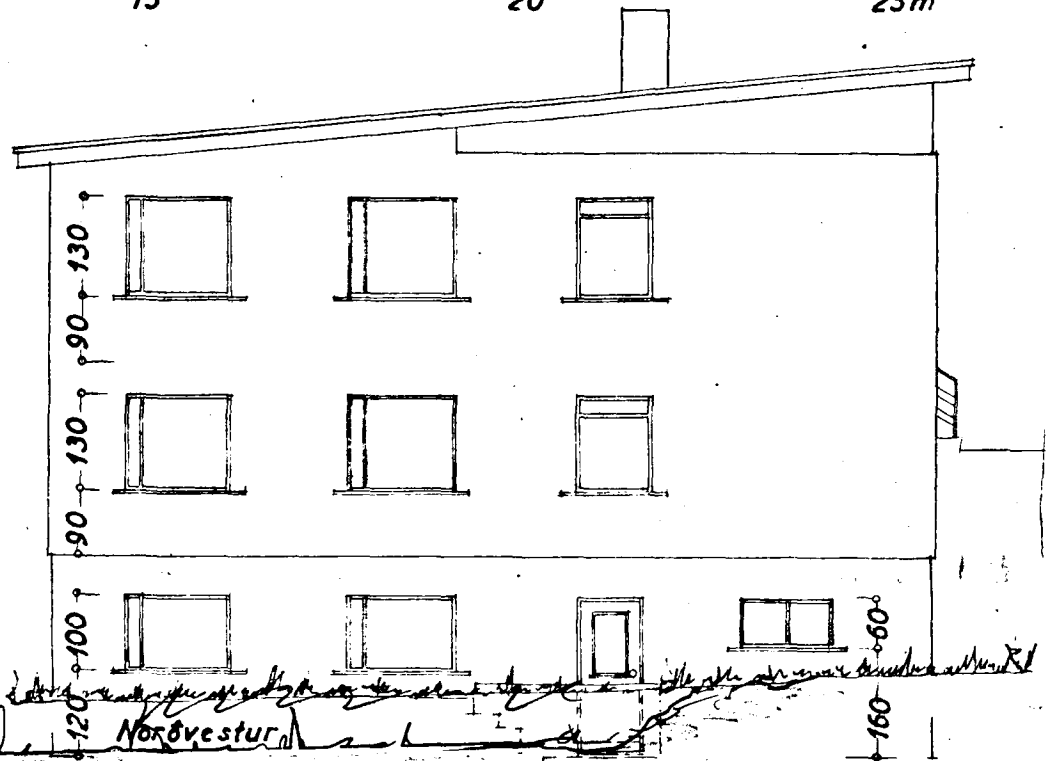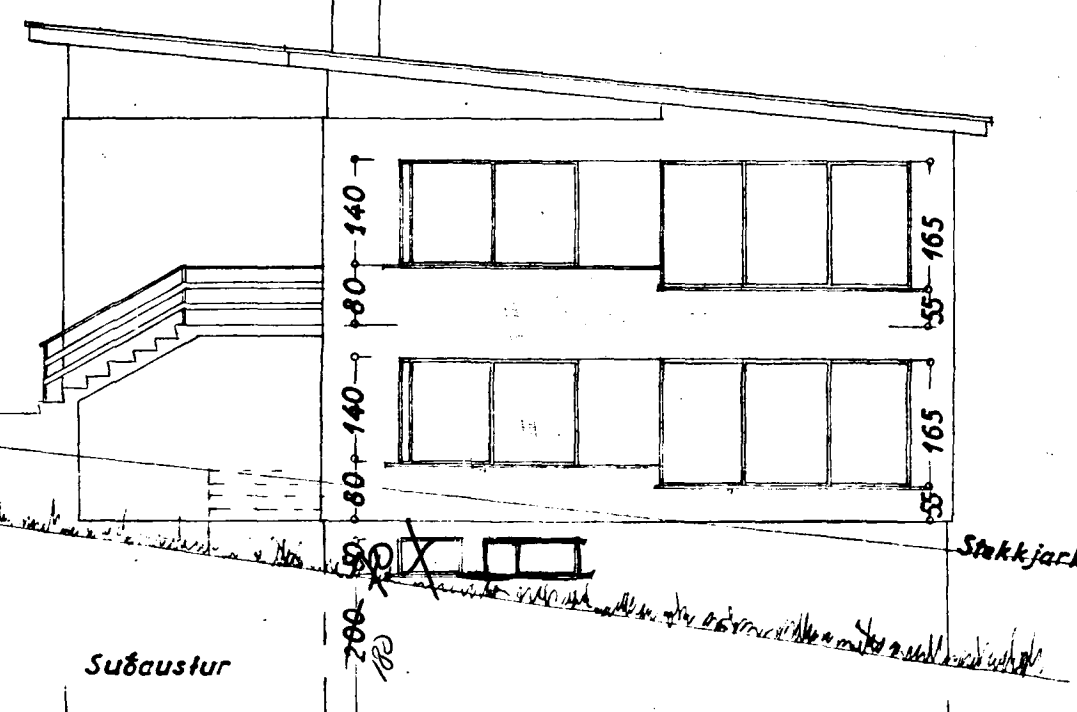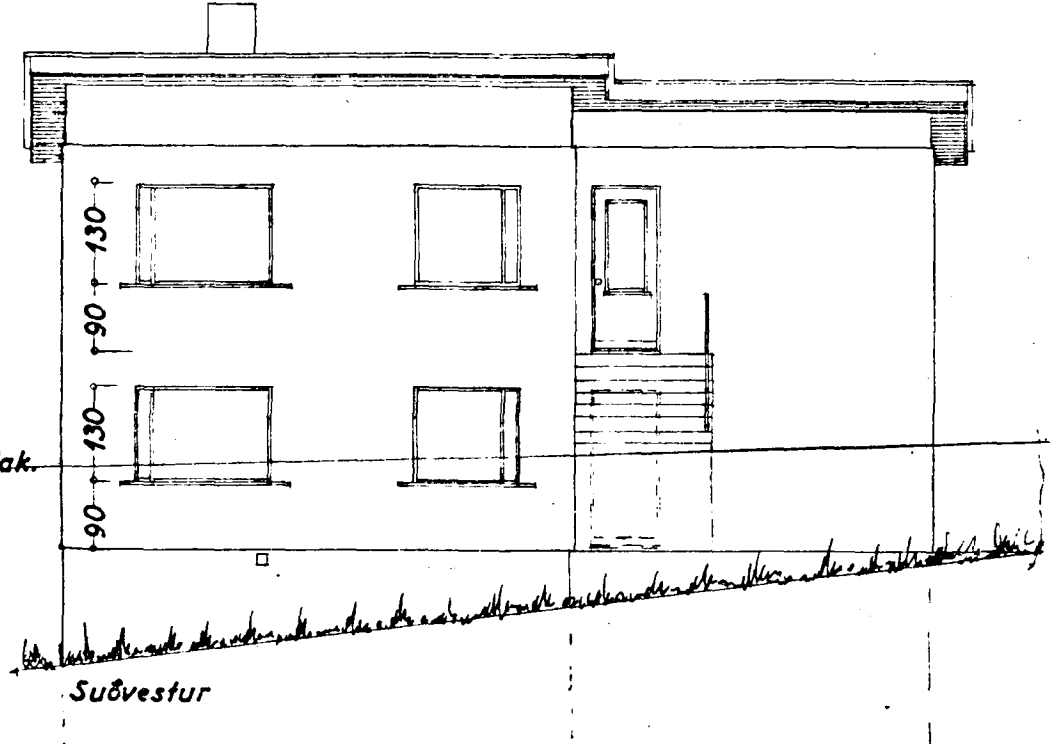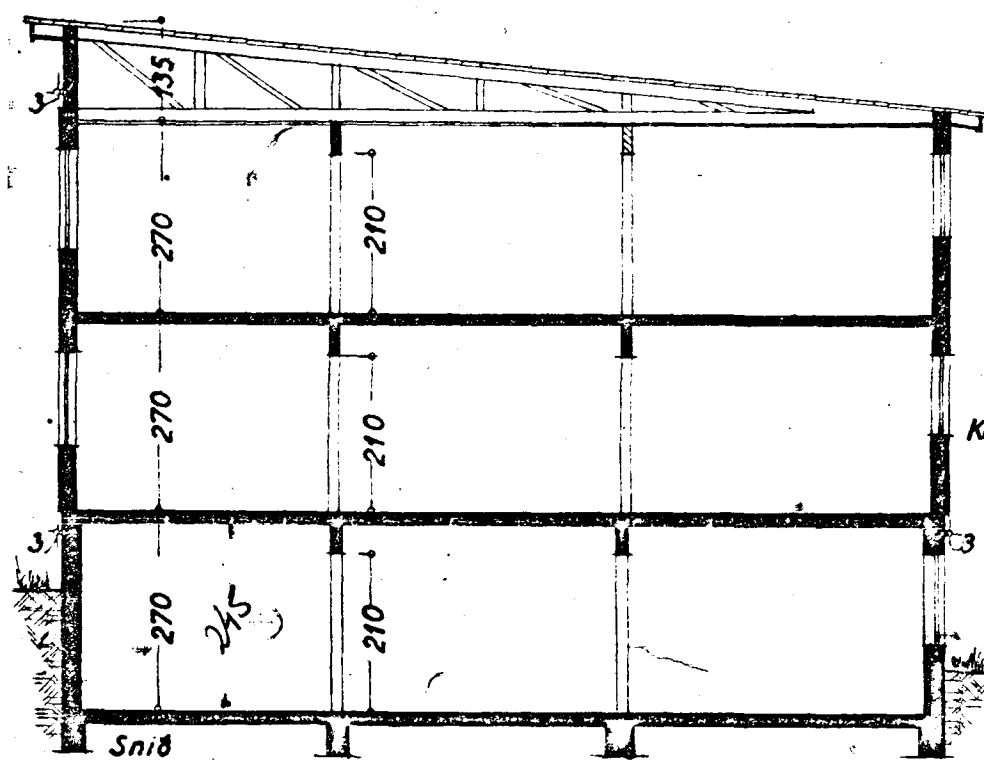

Hafnarbær 1. jan. 1963
F. Sigurðsson