
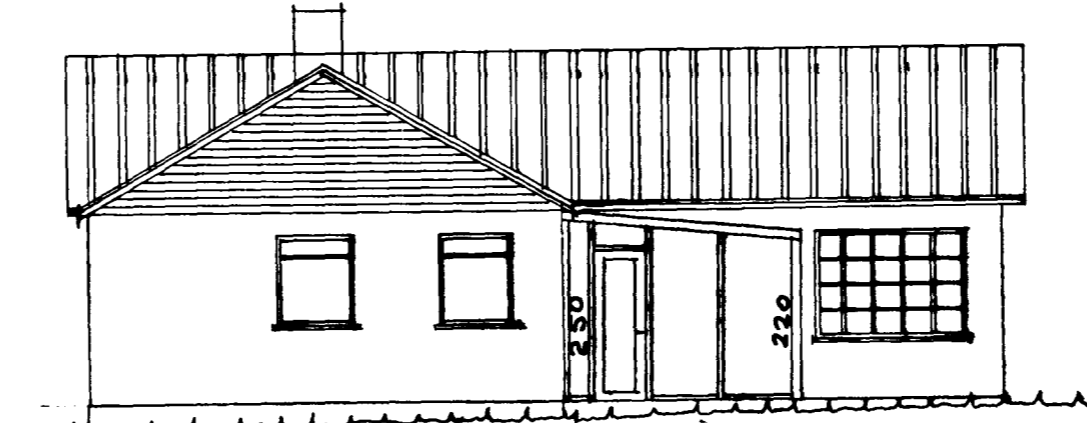



KALDAKINN 4 HAFNARFIRÐI

M = 1:100


Samþykkt á fundi bygginga-
nefndar þ. 22/5 1985
BYGGINGAUFULLTRUINGI
Í HAFNARFIRÐI
Þorbjörn Þorláksson

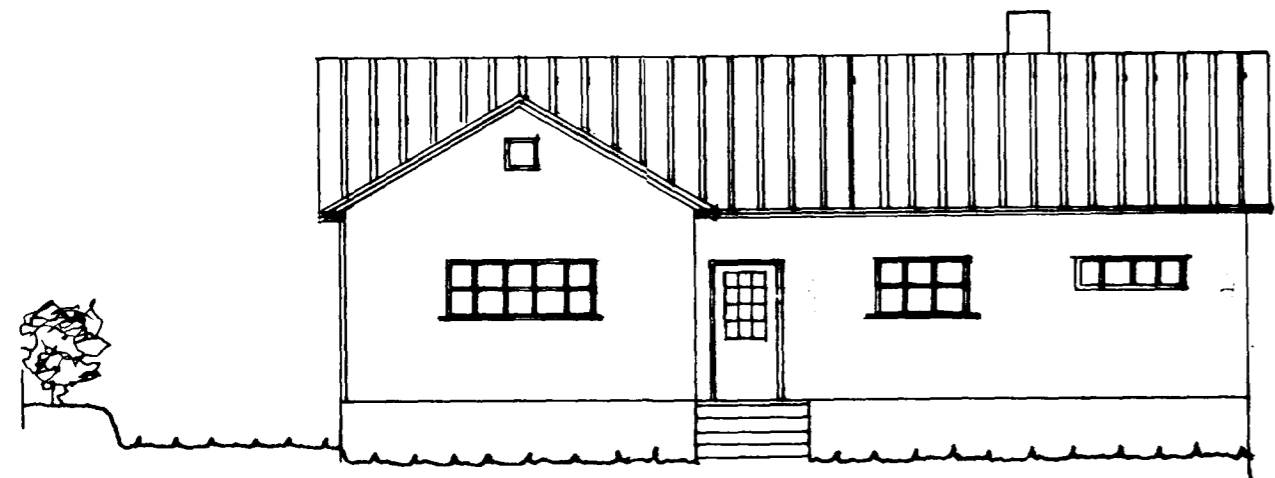


SÚÐVESTUR

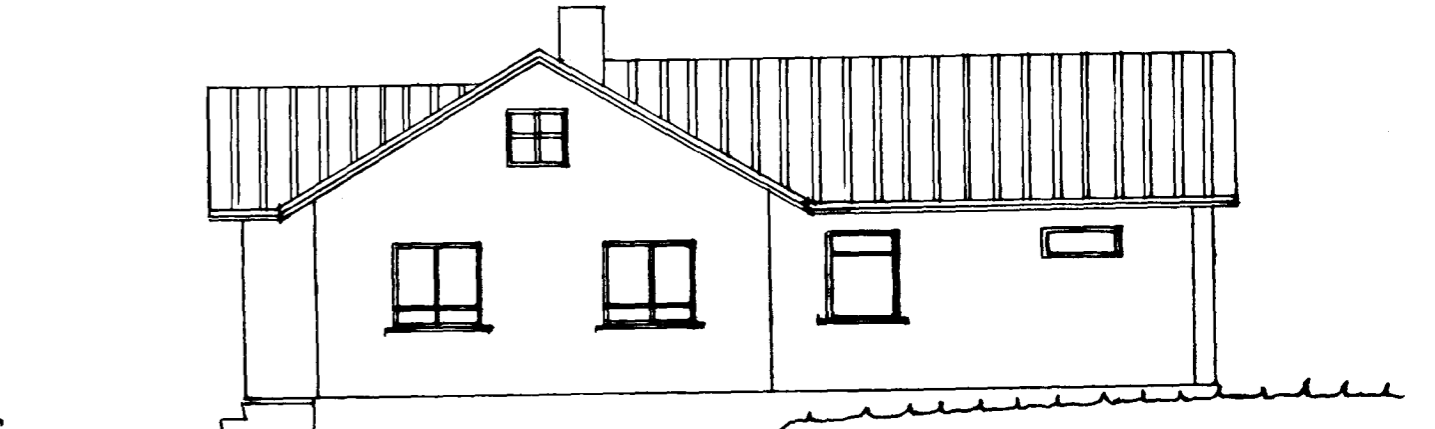

NORÐVESTUR

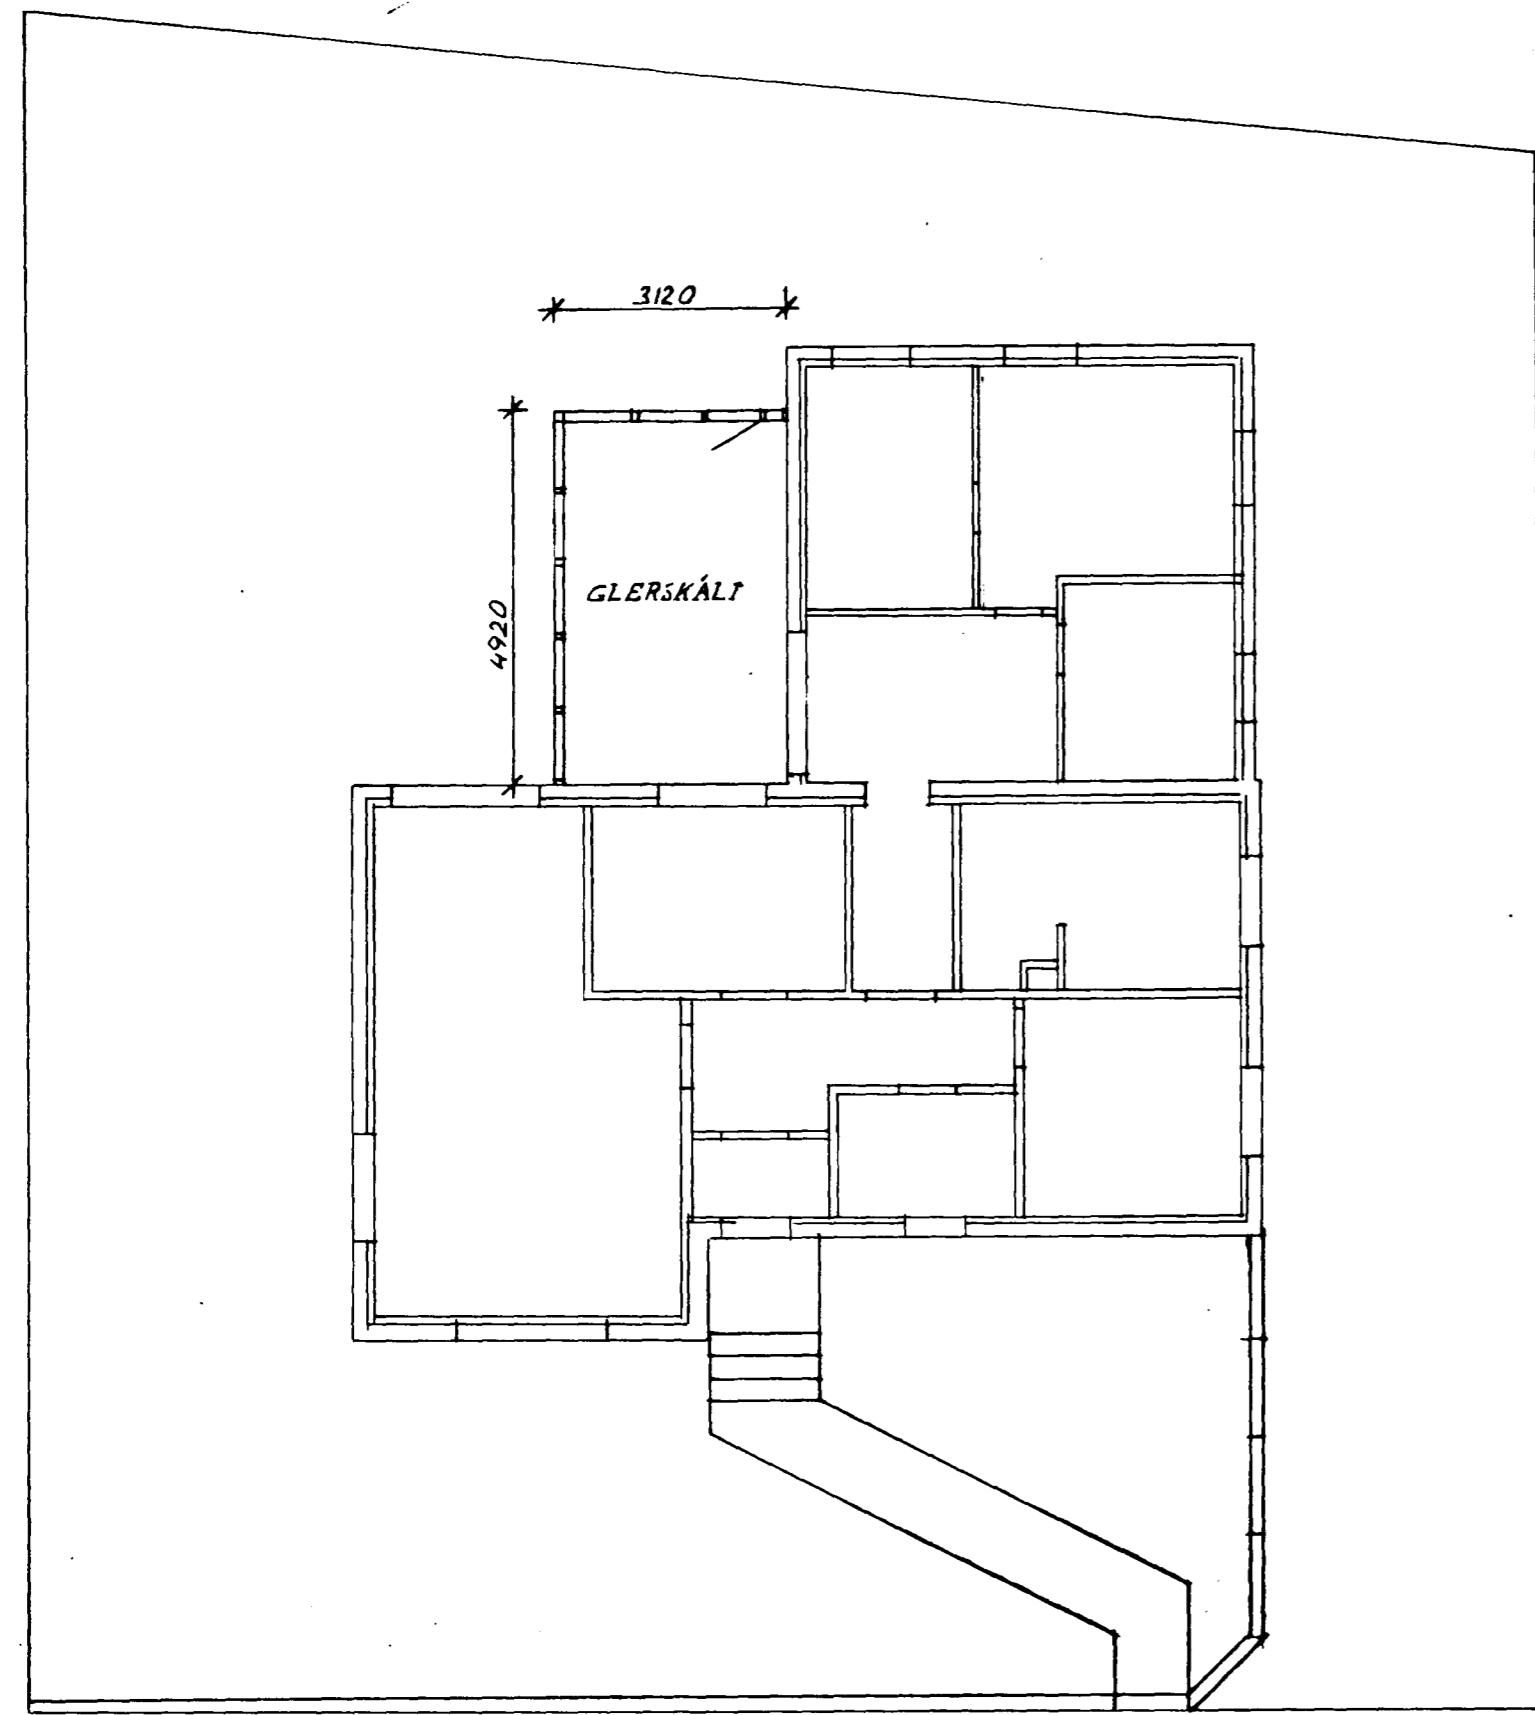

KALDAKINN

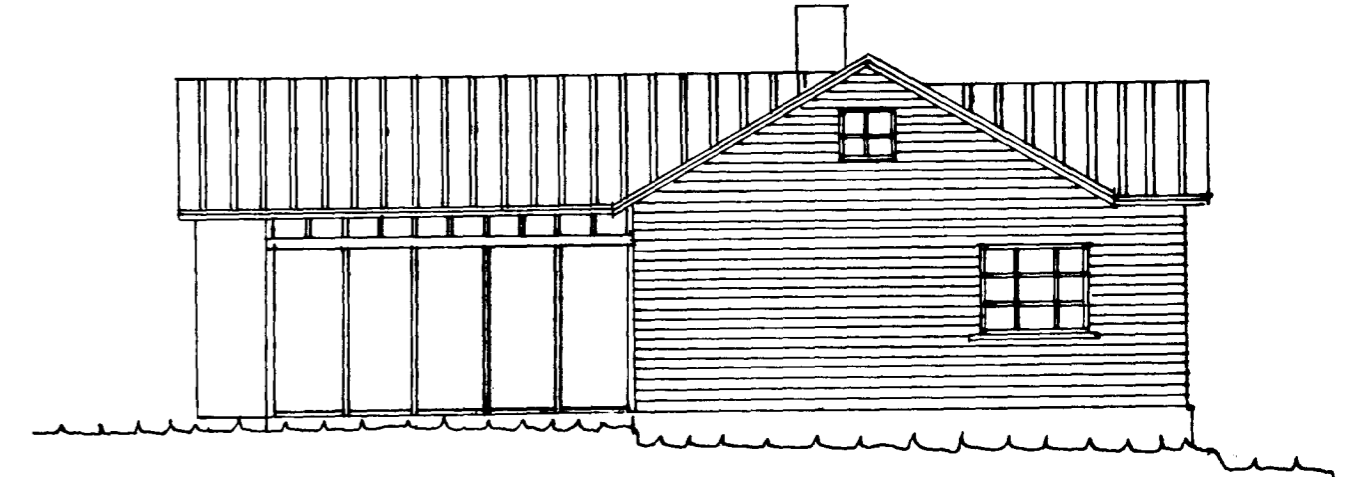

SÚÐAUSTUR

$$4,92 \times 3,12 = 15,4 \text{ m}^2$$

$$15,4 \text{ m}^2 \times 2,35 = 36 \text{ m}^3$$

Fj.	Heiti	Hl.nr.	Teikn.nr.	Efni	Aths.
	Dags	Leidrétting	Dags	Leidrétting	
Breyting	16/5/85	TILLAGA AD GLERSKALA			
JÓHANNES EINARSSON TENNIFR. HÖLSBERGI 13. HAFNARFIRÐI SÍMI 22036					Mkv. Dags MARS '78 1:100 Teikn. J.B. Yfirt. Samþ.
KALDAKINN 4. HAFNARFIRÐI TEIKNAD UPP EFTIR TEIKNINGU SIGURGENS GUDMUNDSSONAR FRA JÚNI 1960. MED ÁRABILM BREYTINGUM.					TEIKNING NR. Verkr. nr.