

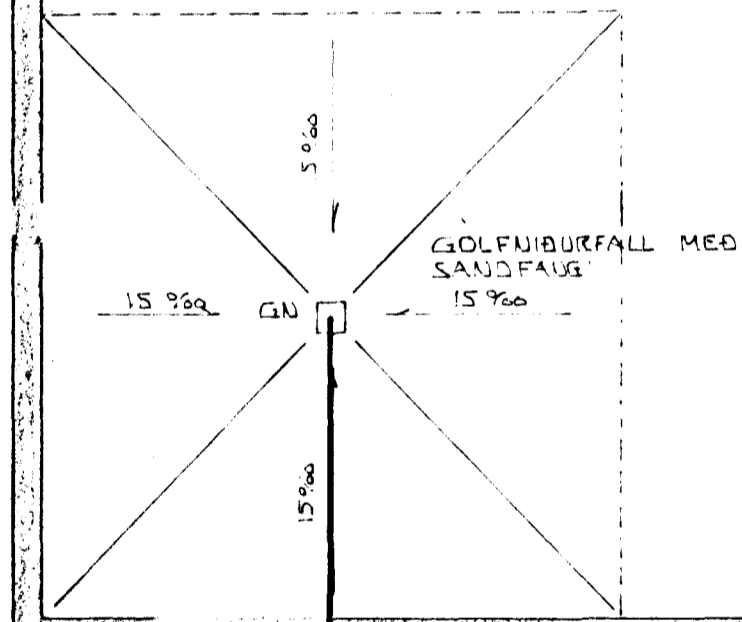
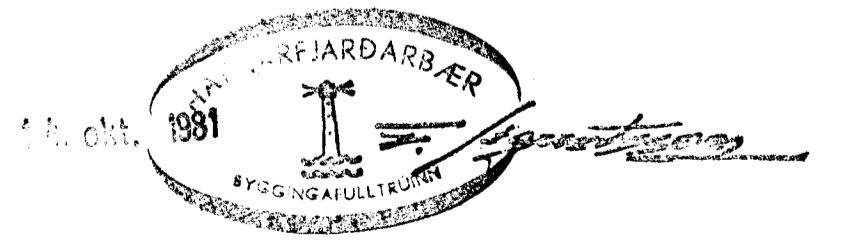


25
GK:28.00

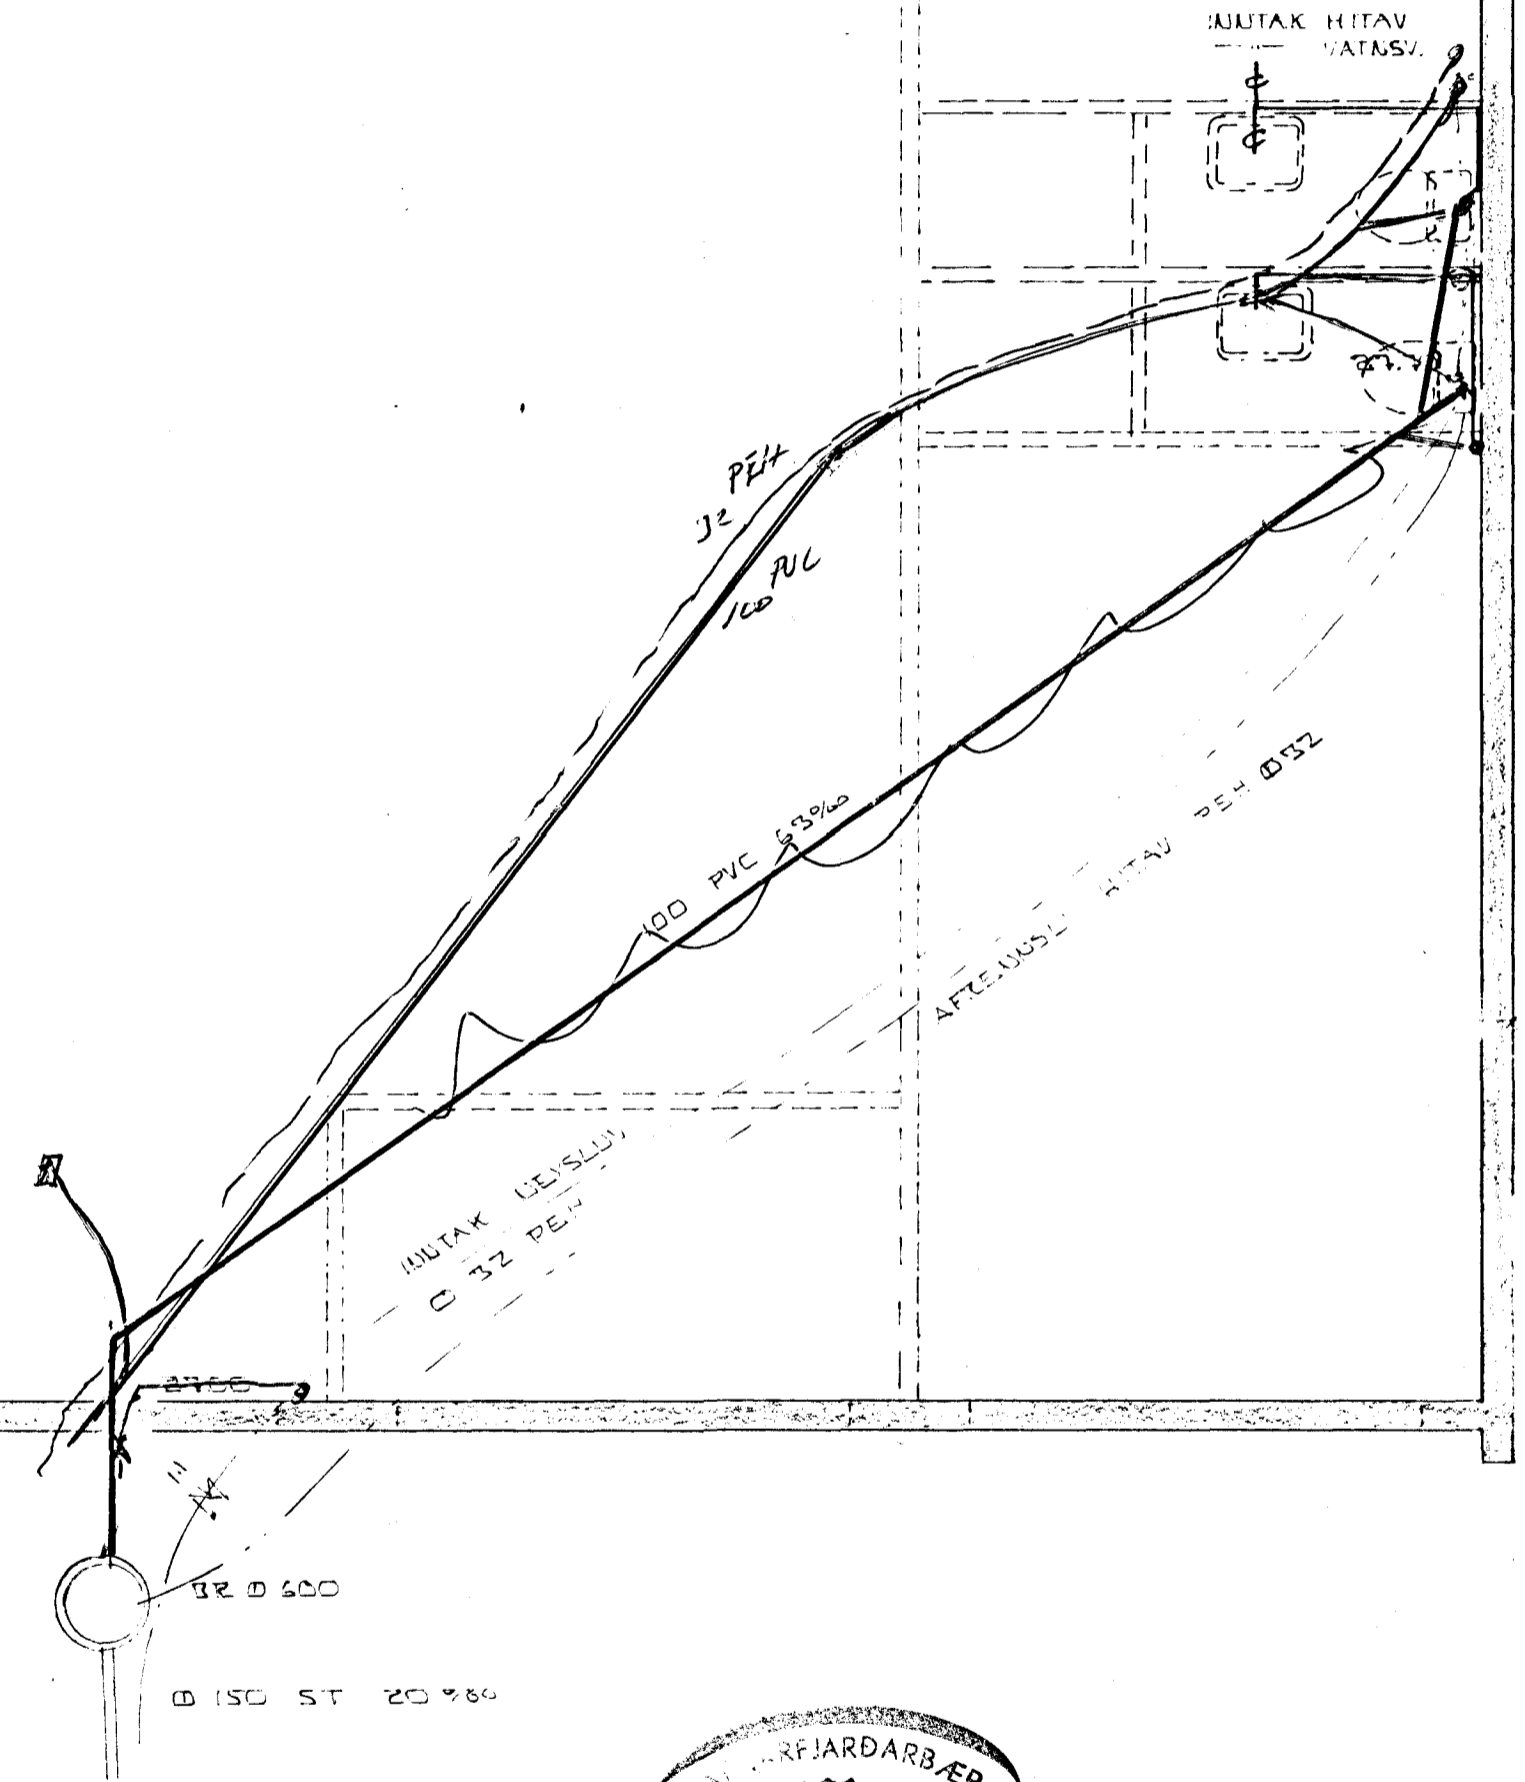

GRUNNMYND UNDIRSTÖÐUR 1:50

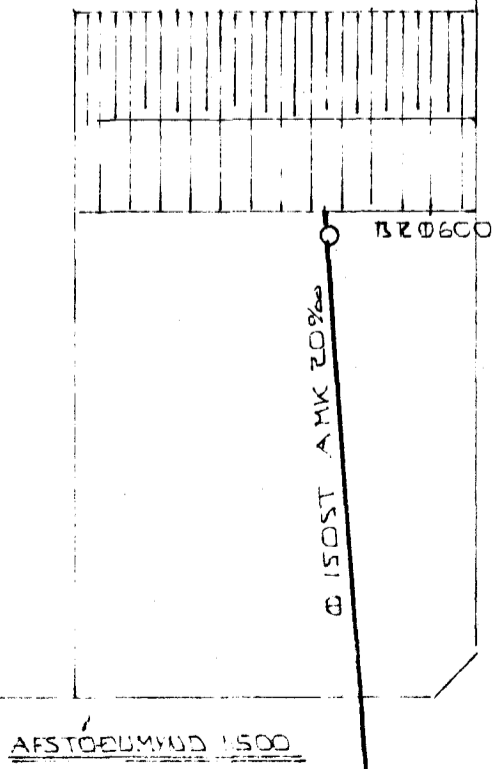

| | |
|--|-----------------|
| KAPLAHRAUN 17. HAFNARFIRÐI | DAGS. 810920 |
| GRUNNLAGNIÐ | REIKN. 20.10.81 |
| MÆLIKV. 1:50 | TEIKN. - |
| SIGURÐUR ÞORLEIFSSON TEKNIFR. F.T.F.I. | VERK. NR. 8101 |
| STRANDGÖTU 11 HAFNARFIRÐI SÍMI 54751 | BLAD NR. 05 |