


GRUNNMYND 1:50

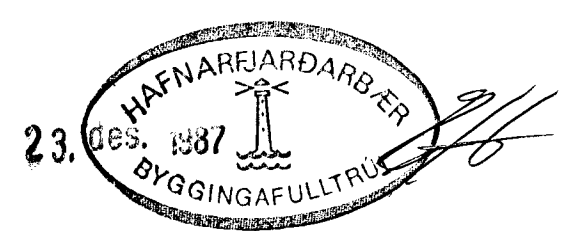

02	8.12.87	DFNAR 1 STAD BLÁSARA	
01	22.09.87	DETT VÍÐ OFN	
BR. NR.	DAGS	EDLI BREVTINGAR	SIGN.
KAPLAHRAUN 22 HAFNARFIRÐI			DAGS NÖV. 26
HITA- VATNS OG FRÆRENNISLAGNIK.			HANNAÐ
MELIKV. 1:50			TEIKNAD
SIGURÐUR ÞORLEIFSSON TEKNIFRÆÐINGUR F.T.F.I.			VERK NR. 8136
STRANDGÖTU 11 HAFNARFIRÐI SÍMI 54151			BLAD NR.