

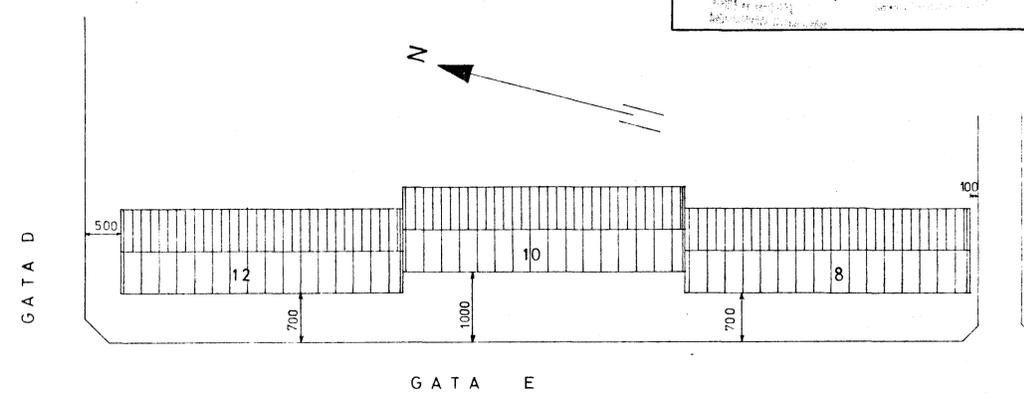



Sambýkt á fundi byggingar
 nefndar 12.5.82
 29.9.82
 BYGGINGAR
 I HAFNARFIRÐI

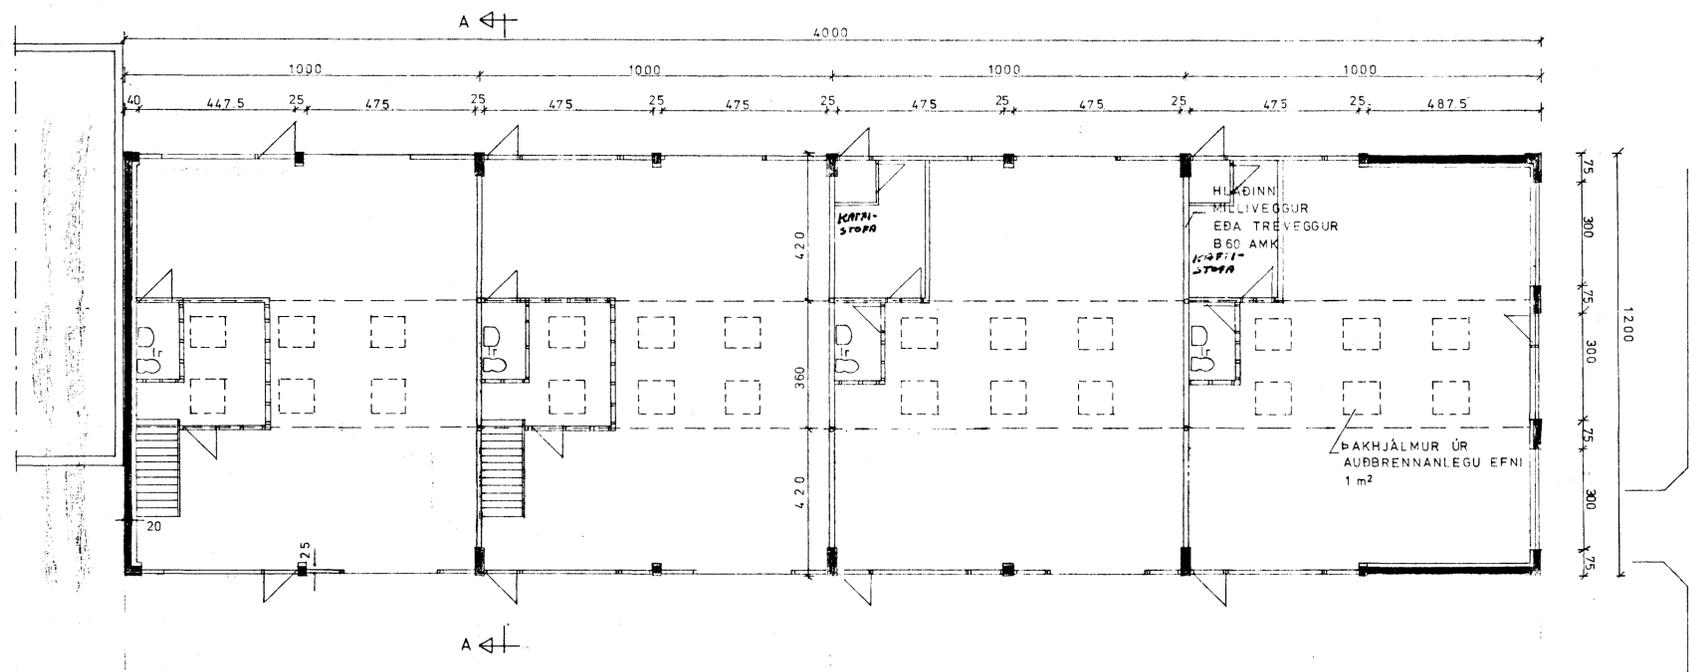



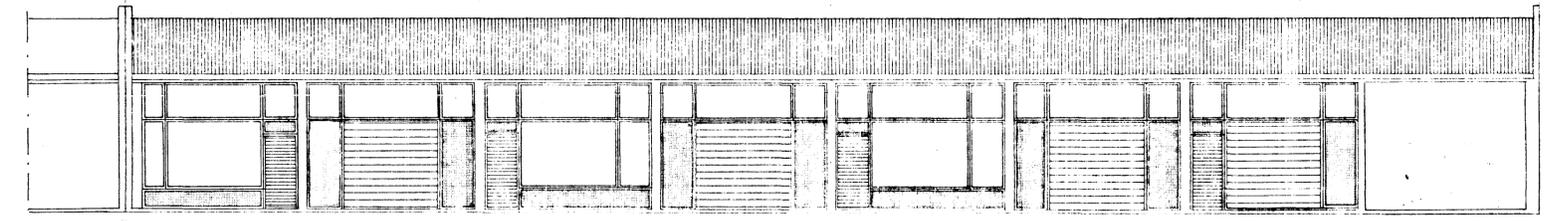


Vesturhlid

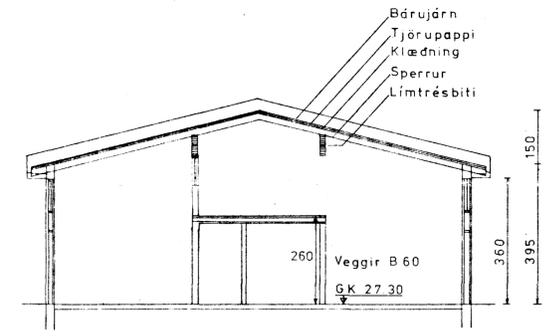

SNID A-A

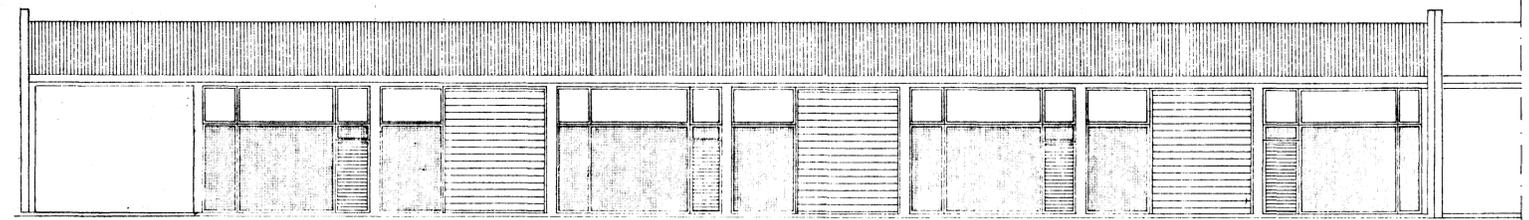

Austurhlid

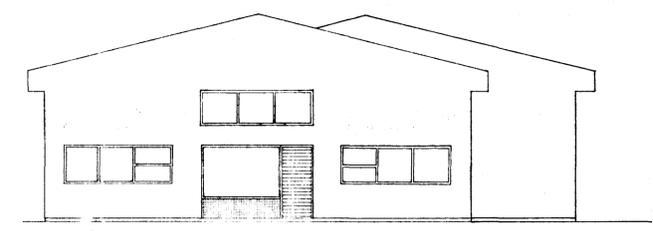

SUBURGAFL

Jón V. Hinriksson 120.0 m² 564 m³
 Jónnik J. Jónsson 120.0 m² 564 m³

FLATARMÁL, BRÚTTÓ : 480 m²
 RÚMMÁL : 2256 m³

KAPLAHREYR 8 / 1840-0020 03

E-GATA 8 HAFNARFIRÐI	Mælikv. 1:100 1:500	Dags. Sept. '79	Teikn.nr. 0.01.
ÚTLIT, GRUNNMYND SNID OG AFSTÖÐUMYND	Hannað M.G. Teiknað H.O.	Breytt 01 sept. '82	
Magnús R. Guðmannsson Verkfr. MVFÍ Holtsgötu 12, Njardvík sími 92-3176			