


Úr Gildi

Punktur	X - hnit	Y - hnit
1	22101.4305	10123.4682
2	22194.6654	10107.8100
3	22399.1444	10032.2194
4	22495.3777	9982.1234
5	22530.2677	10001.4546
6	22554.6198	10168.2714
7	22544.1739	10190.9084
8	22415.0618	10267.1632
9	22240.1620	10320.8900
10	22185.3459	10326.6854
11	22131.2811	10327.4876

VIÐSÉÐLIG
BESNIÐ
KAPLAKRIKA

Punktur	IX - hnit	Y - hnit
V1	22470.9450	10023.9185
V2	22450.8437	10038.5670
V3	22417.2911	10055.7290
V4	22411.4989	10065.6201
V5	22413.5849	10106.2111
V6	22412.1163	10116.6708
V7	22406.5776	10125.9120
V8	22369.8123	10174.2794
V9	22364.3898	10148.6941
V10	22412.7333	10263.9714
V11	22408.046	9957.605

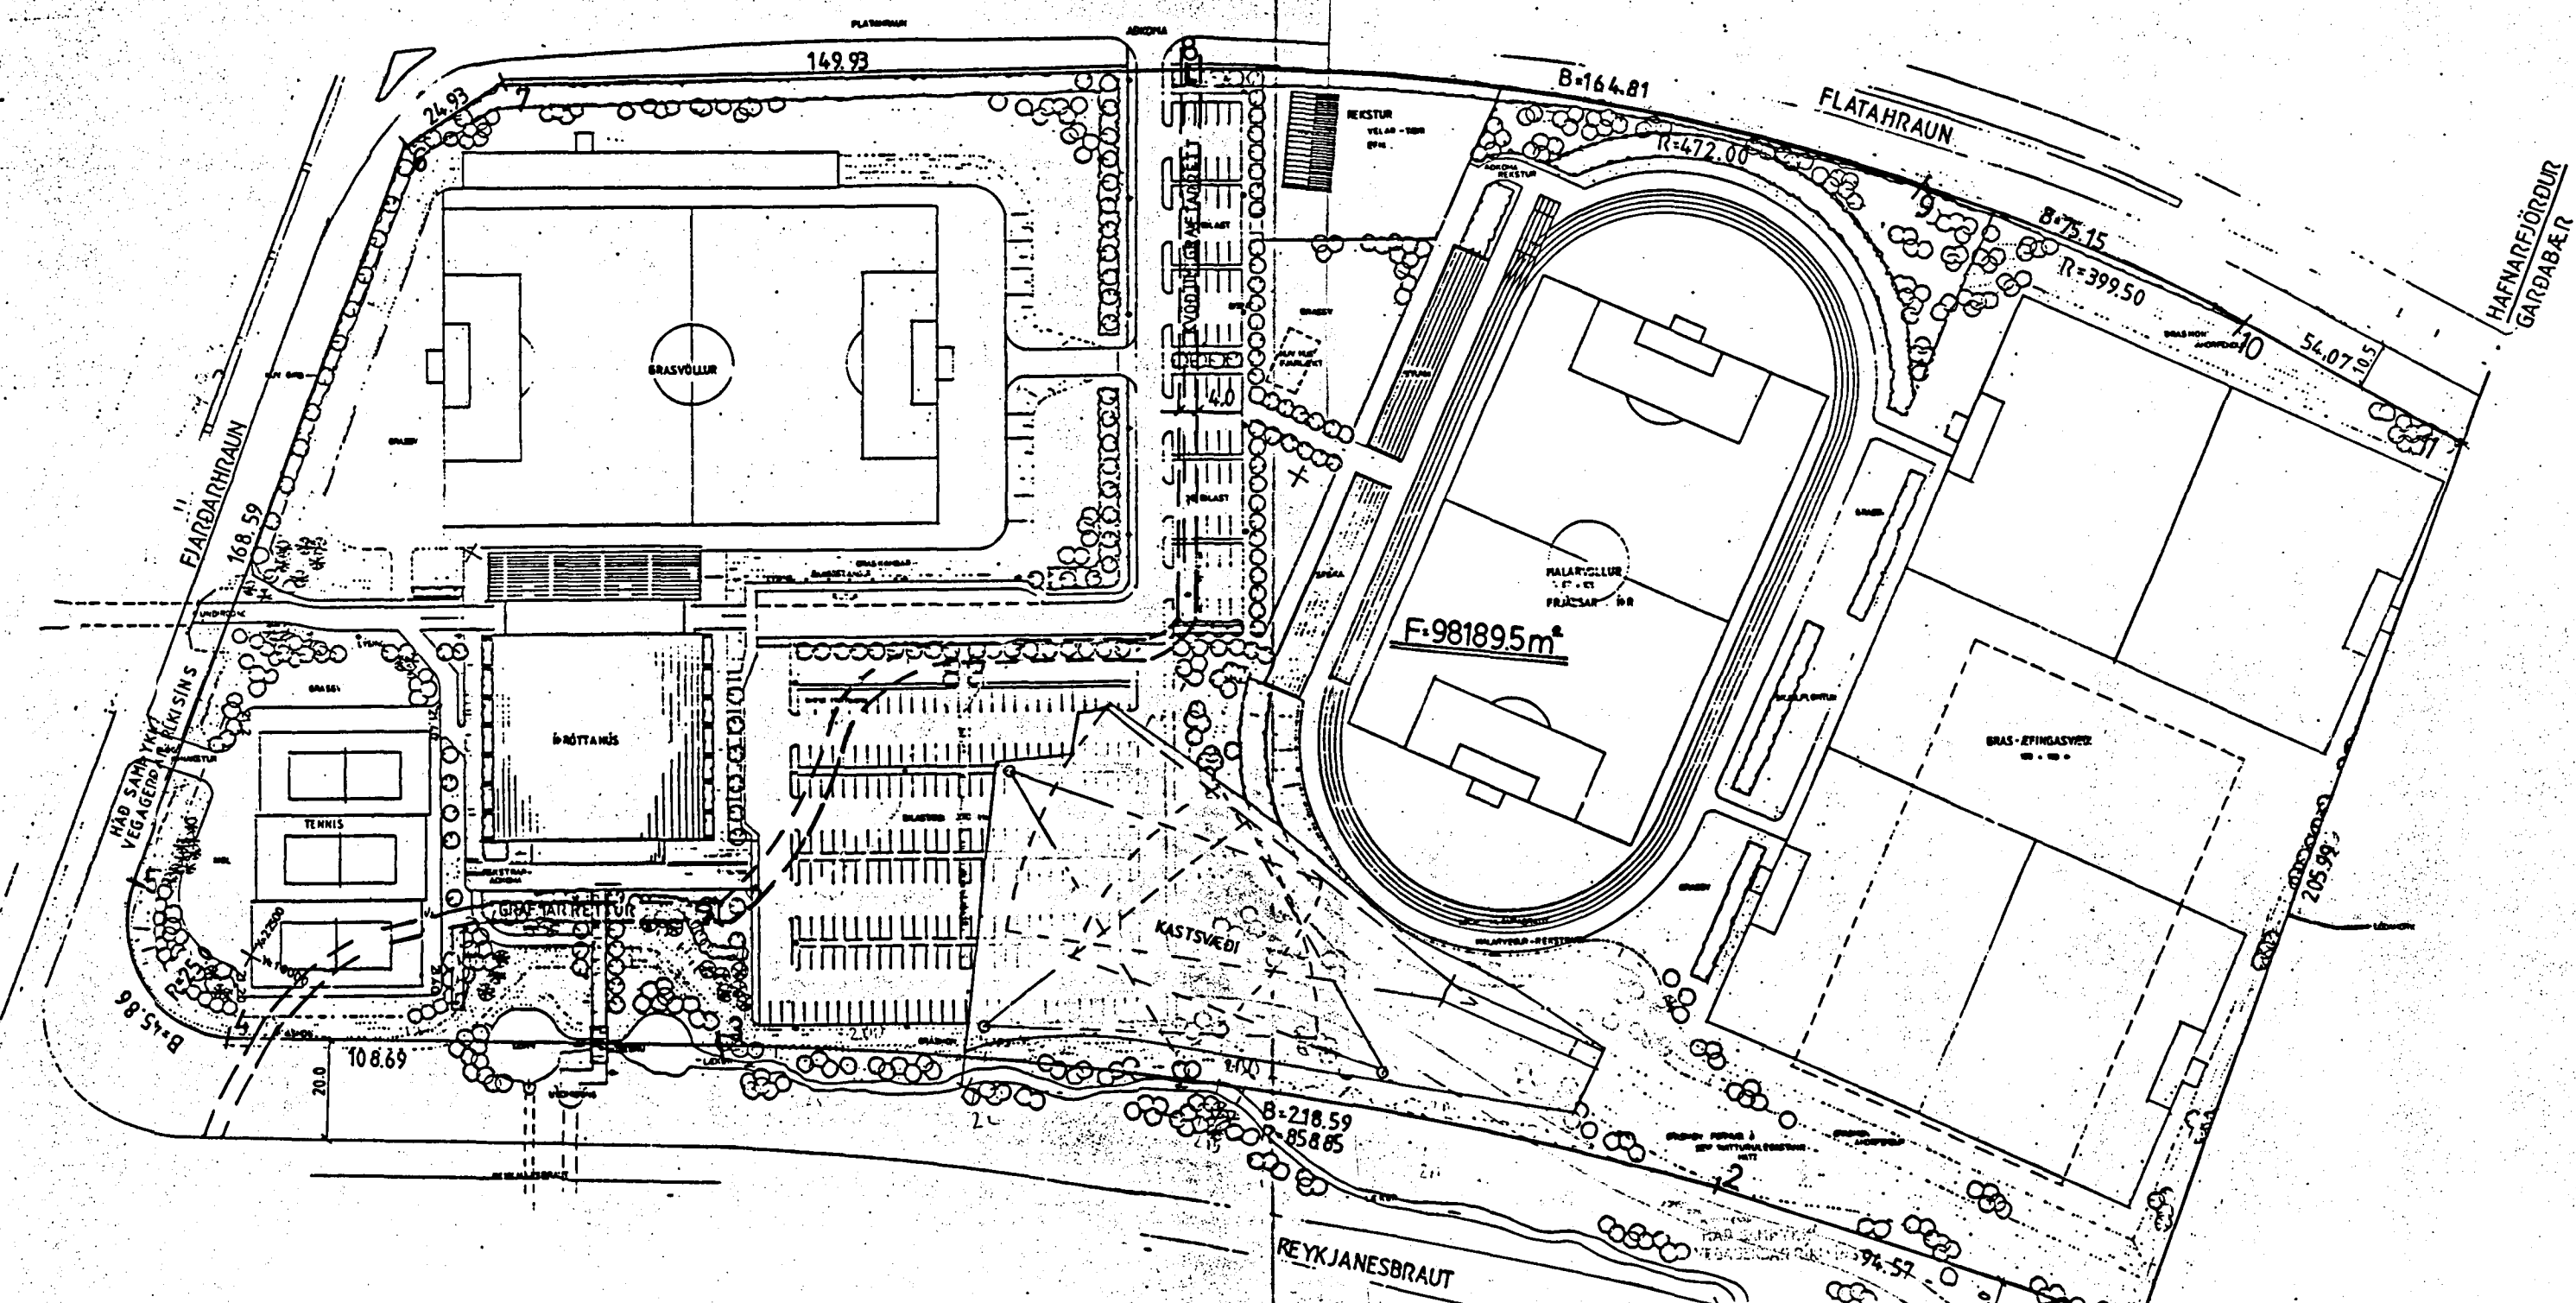

KASTSVÆÐI sig. Bl. 9/6 193

FLATARMÁL LÖÐAR sig. Sv. Hamblinn 2/7 190

ÍÞRÓTTASVÆÐI F.H. VIÐ KAPLAKRIKA
YFIRLITSMYND

PÉTUR JÓNSSON LANDSLAGSARKIT. FÍLA
TEIKNISTOFA BARÓNSSTÍG 5 s. 621725

MÁL 1:1000
DAGS MÍN 1990
T. ÁS. TR.