




D24 DEILI
109

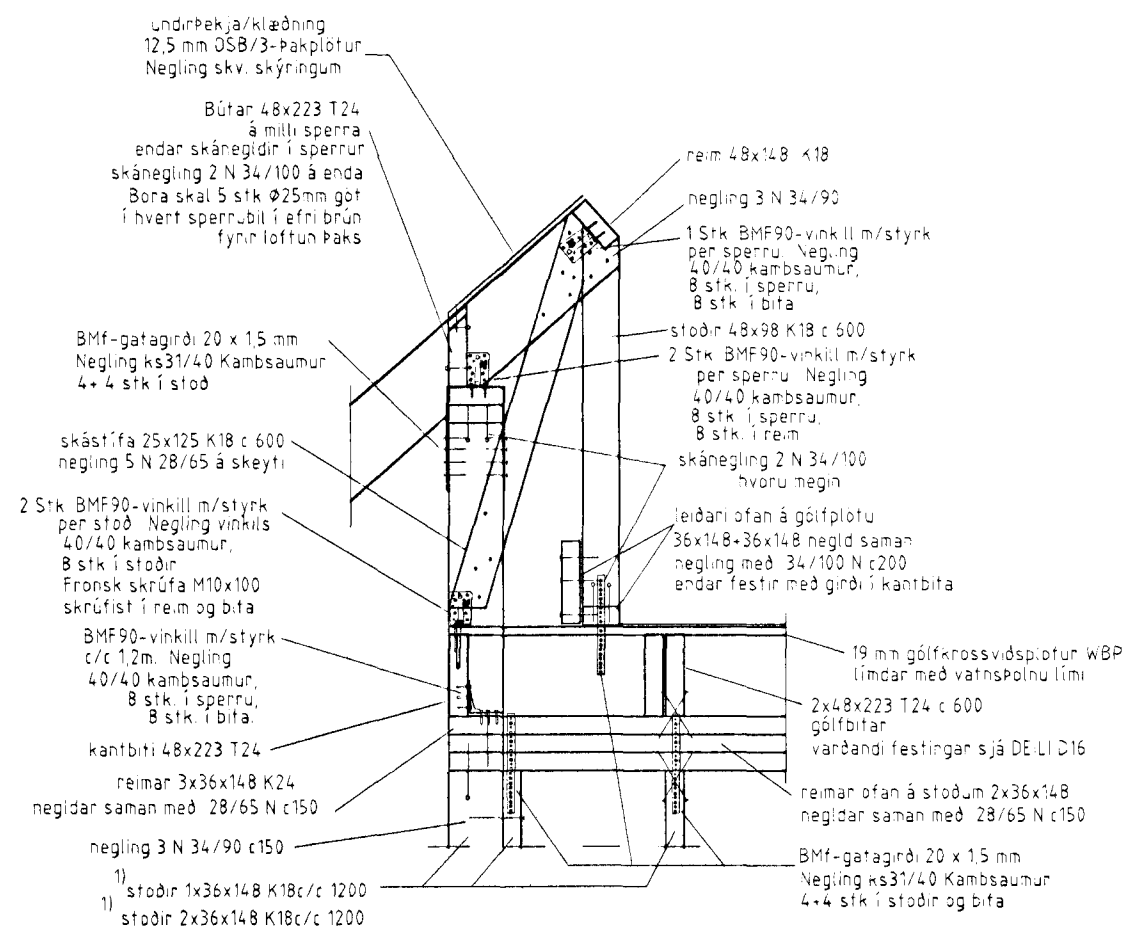


D30 DEILI
110

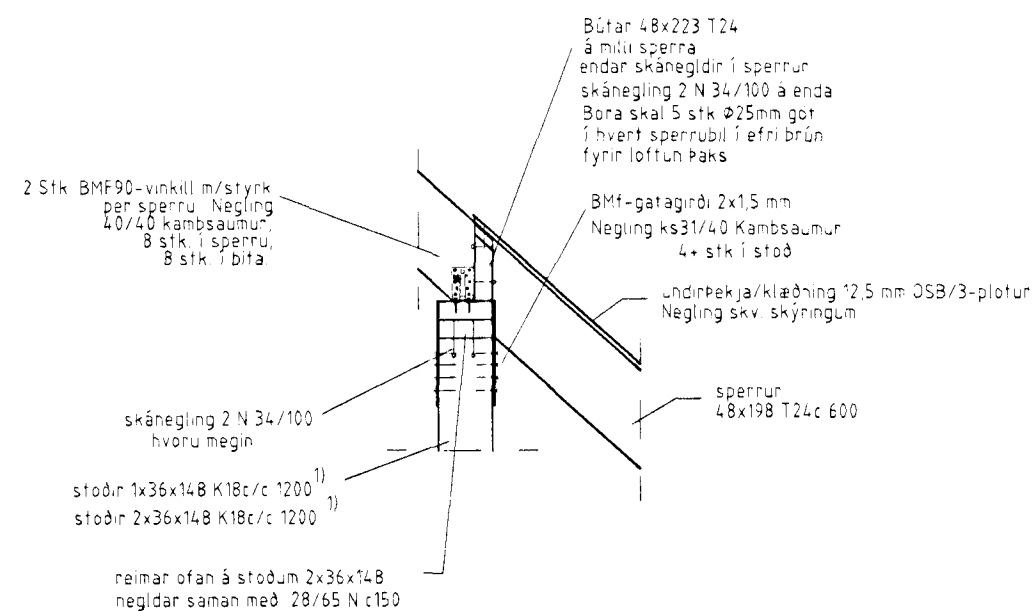


D25 DEILI
106

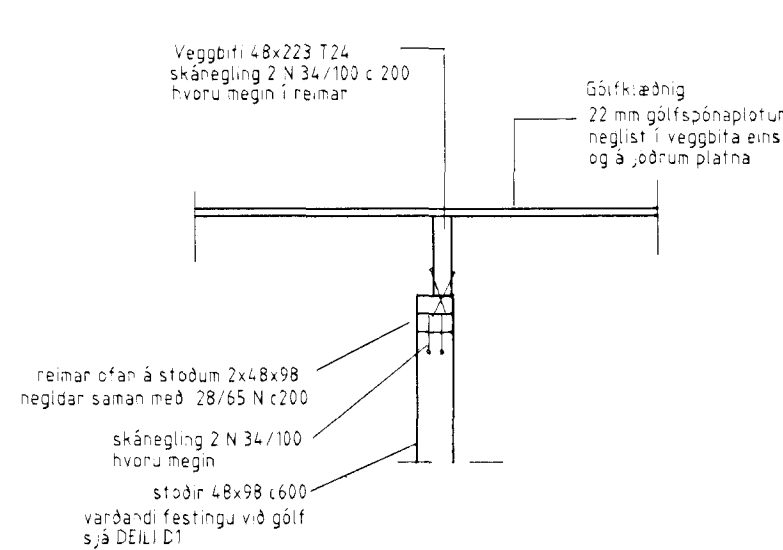


D27 DEILI
106

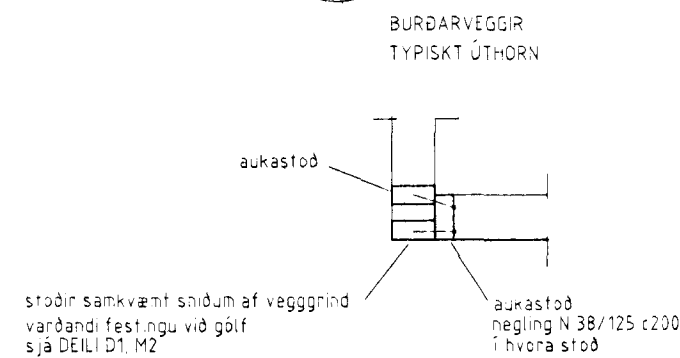

D26 DEILI
106

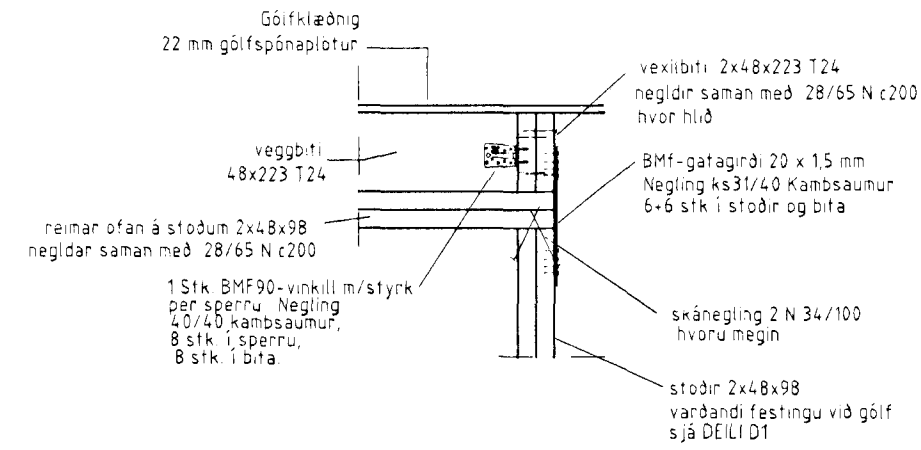

D28 DEILI
106

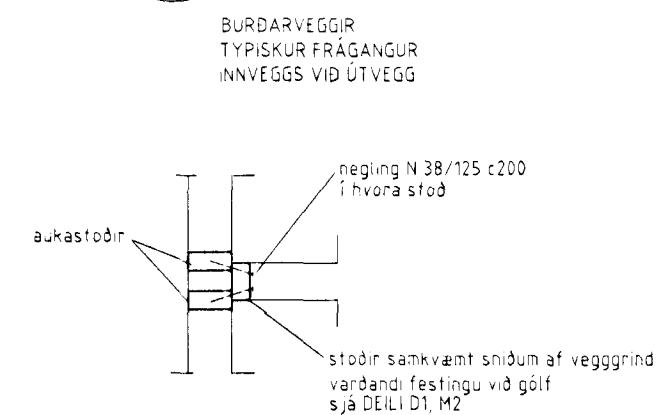

TILVÍSUN TEIKNINGAR NR. 106 TIL 113
ALMENNAR SKÝRIGAR ERU Á TEIKNINGU NR. 100

VARDANDI ALLAN FRÁGANG ER VISAÐ 01 JULI 1998
TIL SÉRTEIKNINGA ARKITEKTS

TEIKNINGARFRÁGANGUR

H					
G					
F					
E					
D					
C					
B					
A	28.6.1998	FESTINGUM BRÉYTT.	E.E.		
	DAGS.	BRÉYTING	SAMP.	MKV 1:20	DAGS. MAÍ 1998

EINAR EINARSSON TÆKNIFRÆÐINGUR, STRANDGATA 28, 3.HÆÐIN
kennitala 1510504769, sími 5650788

TEIKN NR. 113

HANNAD EE

TEIKNAD EE

YEIF.

SAMP.