


MÆLAGRIND HITAVEITU
ÍNNTAK KALDAUATNS.

29 AUG 1991

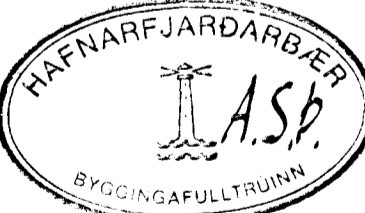

Tákn	Fj.	Breyting	Dags/u. skr.

Dags: 28.08.1991	Hann./teikn. Sigrún Káll Yfirfarid: S.H.	Samb.: S.H.	M.kv.: 1:50	Heiti: Rúmmynd. Neysluvatnslagna.
Tilvisun: Teikn: L05			Útreikn.: Sigrún Káll	
Heiti: Rúmmynd. Neysluvatnslagna.				Vetur fyrir: Sigrún Káll