



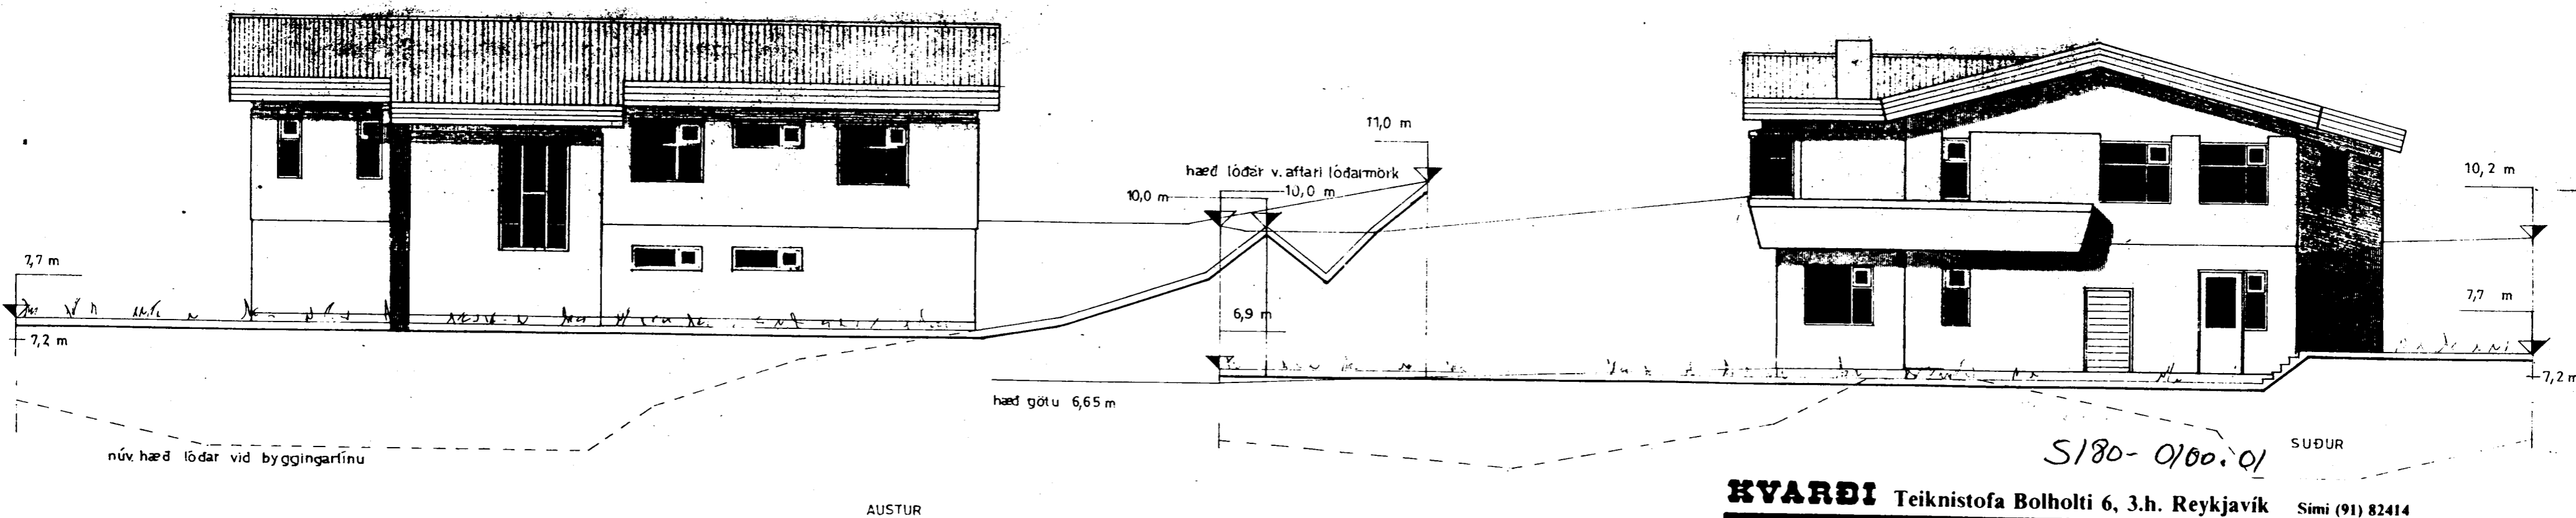

Samþykkt þann

15. DES. 2004

Byggingafulltrúinn í Hafnarfirði  
F.h. Kristján Þórarinnsson

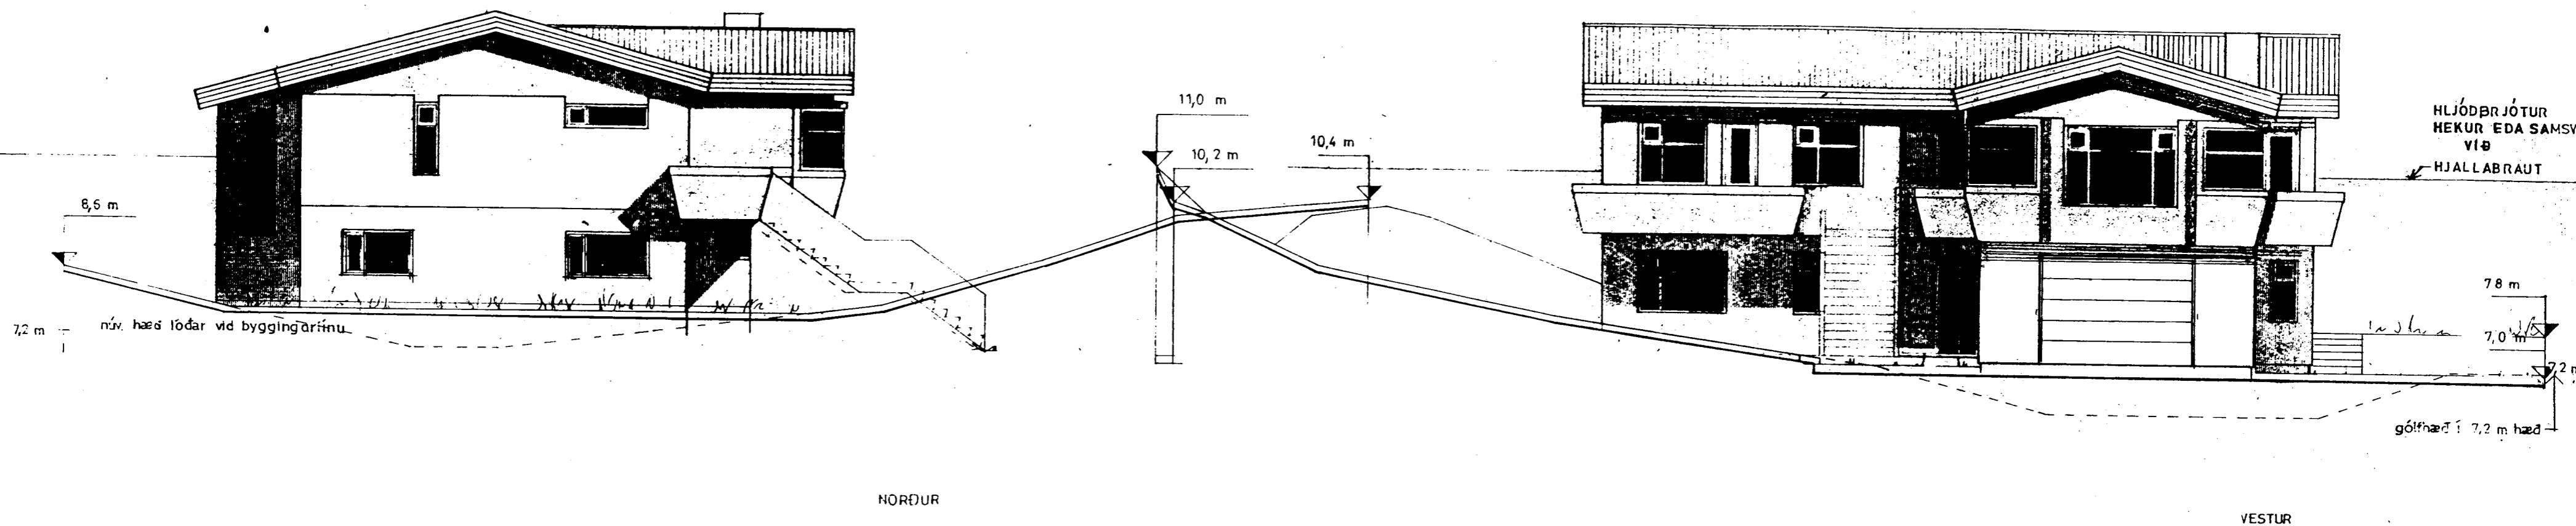

**KVARDI** Teiknistofa Bolholti 6, 3.h. Reykjavík Sími (91) 82414

VERKEFNI	KVARDI 1:100	VERK NR.
KLETTA GATA 10, HAFNARFIRÐI	DAGS. JÚLÍ 1983	6345
HEITI	HÖNNUN 6.6	TÝPA NR.
ÚTLITSMYNDIR	TEIKN. REIKN.	TEIKN. NR. A-1

28. NOV 2004  
 GLIUGUM NORÐUR HÍÐ OG BÍLÉ HÚSD. BREITT  
 ERLENDUR KRNI HJÁLMARSSON BFI  
 KEBERGIL & HAF KT 100355-5239 s 555 3860

*Gisti Gunnarsson*

