


GRUNNMÝND 1:50

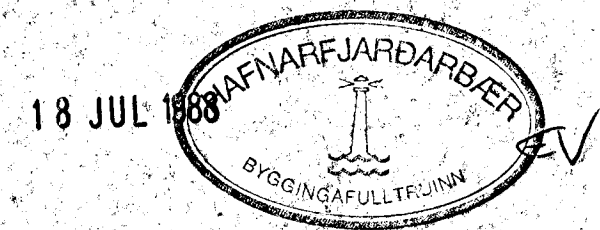

	1	JULI 88	LEGA LÖGNA. GOLFHI.
BR. NR.	DAGS	EDLI	GREYTINGAR
			SIGN.
KLETTAGATA 15 HAFNARFIRÐI			DAGS
HITA- VATNS OG FRÆNNISLAGNIR			11.03.88
MELKY. 1:1:50			MANNA
SIGURÐUR ÞORLEIFSSON TEKNIFRÆÐINGUR F.T.T.I.			FEKNAÐ
STRANDGÖTU 11 HAFNARFIRÐI - SÍMI 94751			9.21
			VERK NR.
			8431
			BLAD NR.
			2-05