



AFRENNSLI BILUPLAN?

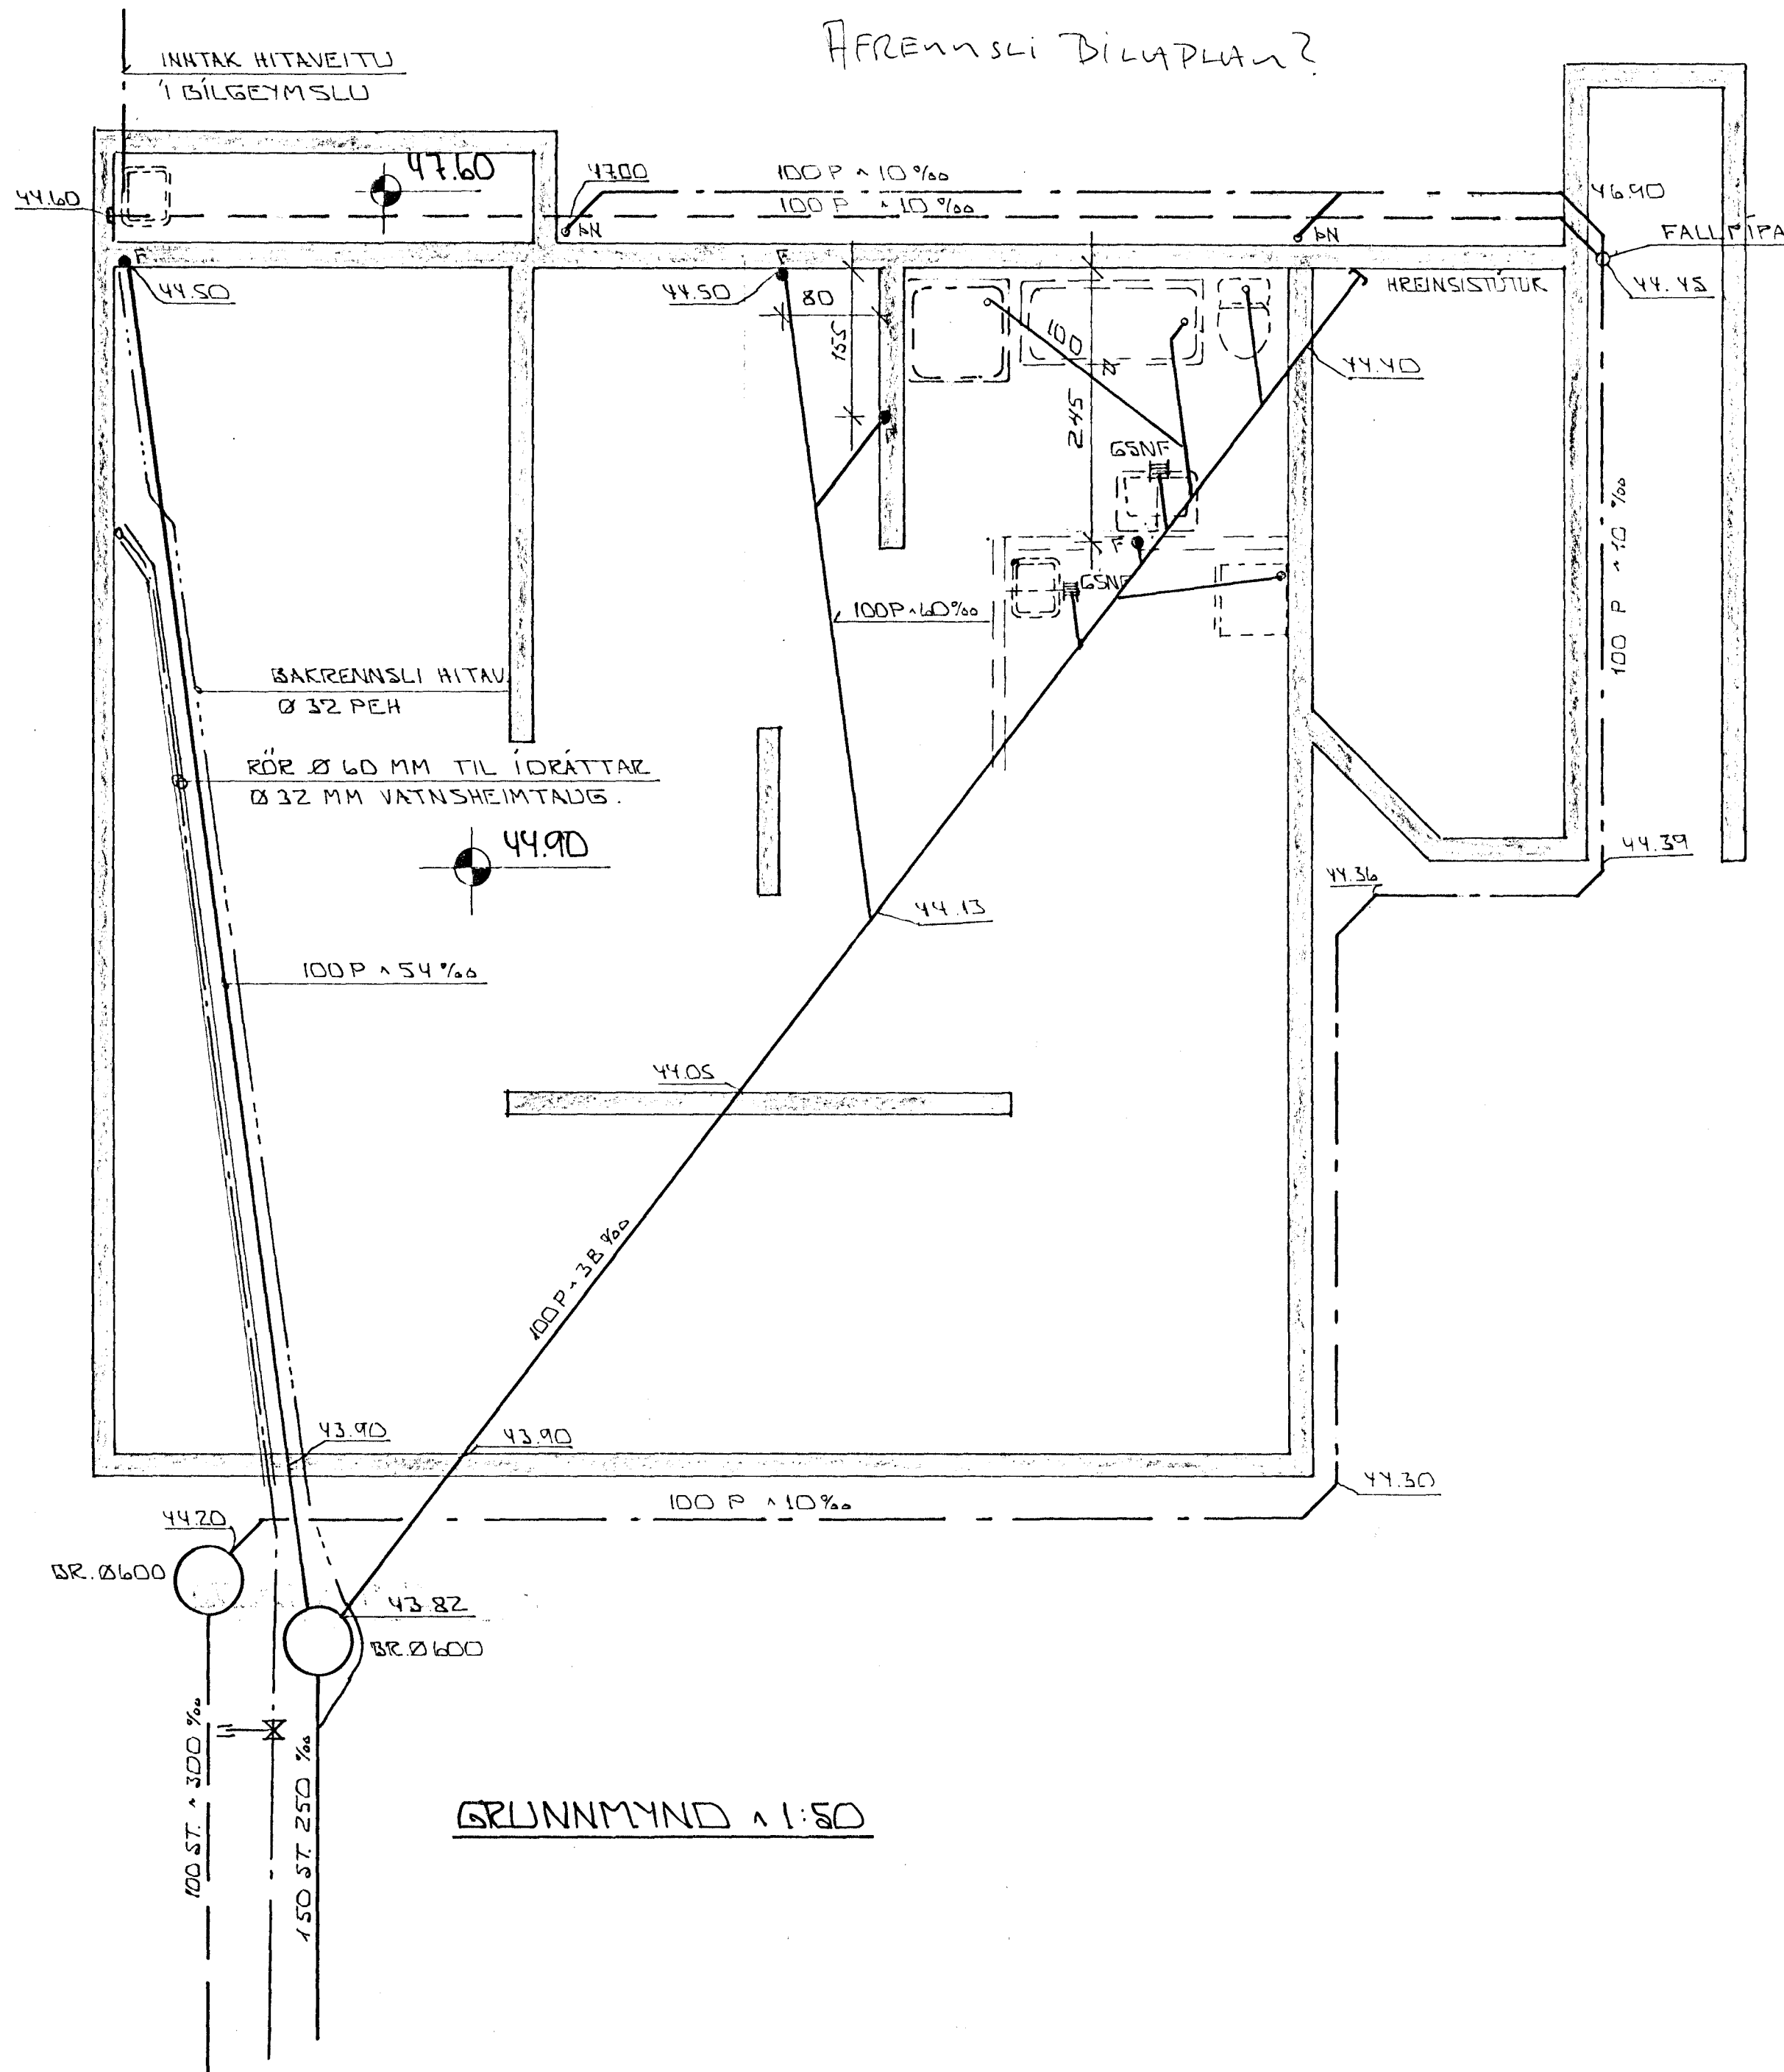

GRUNNMÝND 1:50

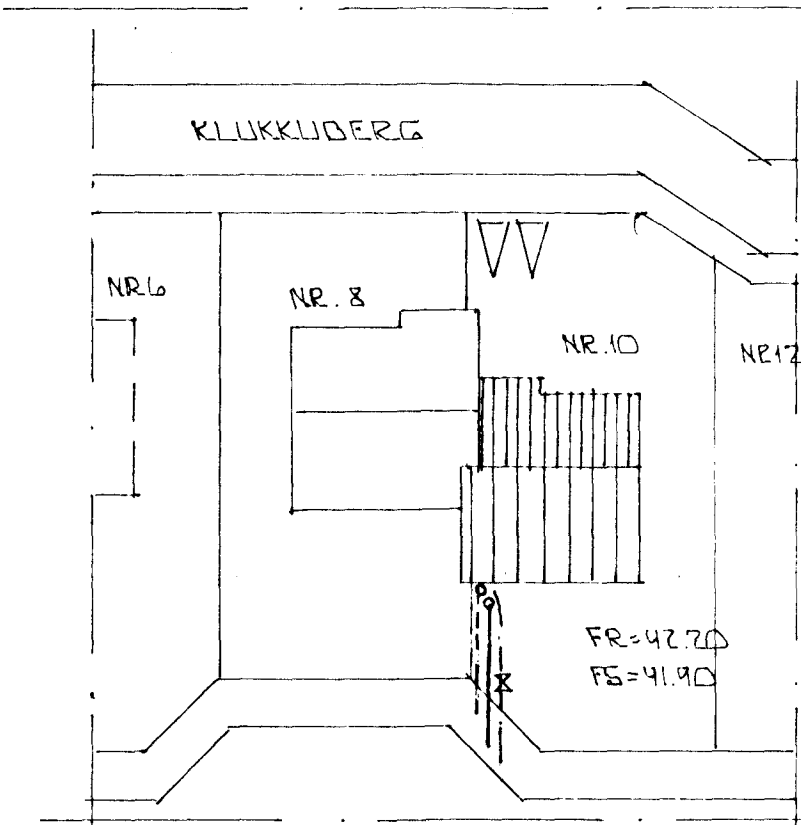

AFSTÖÐUMÝND 1:500



BR.NR.	DAGS	EDLI BREVTINGAR	SIGN.
		KLUKKUBERG IO HAFNARFIREI	DAGS MAI '90
		GRUNNMÝND GRUNNLAGNA	HANNAÐ 4/21
		MELIKV. 1:50 1:500	TEIKNAD 1/20
		SIGURÐUR ÞORLEIFSSON TEKNIFRÆÐINGUR F.T.F.I.	VERK NR. 9004
		STRANDGÖTU 11 HAFNARFIREI SÍMI 54751	BLAD NR. 2-02