
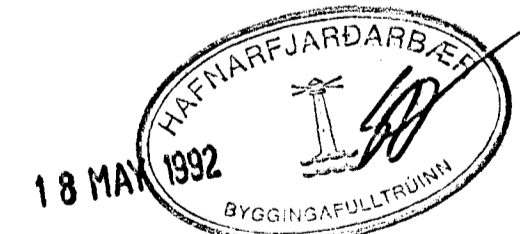



1.HÆÐ. GRUNNMYND 1:50

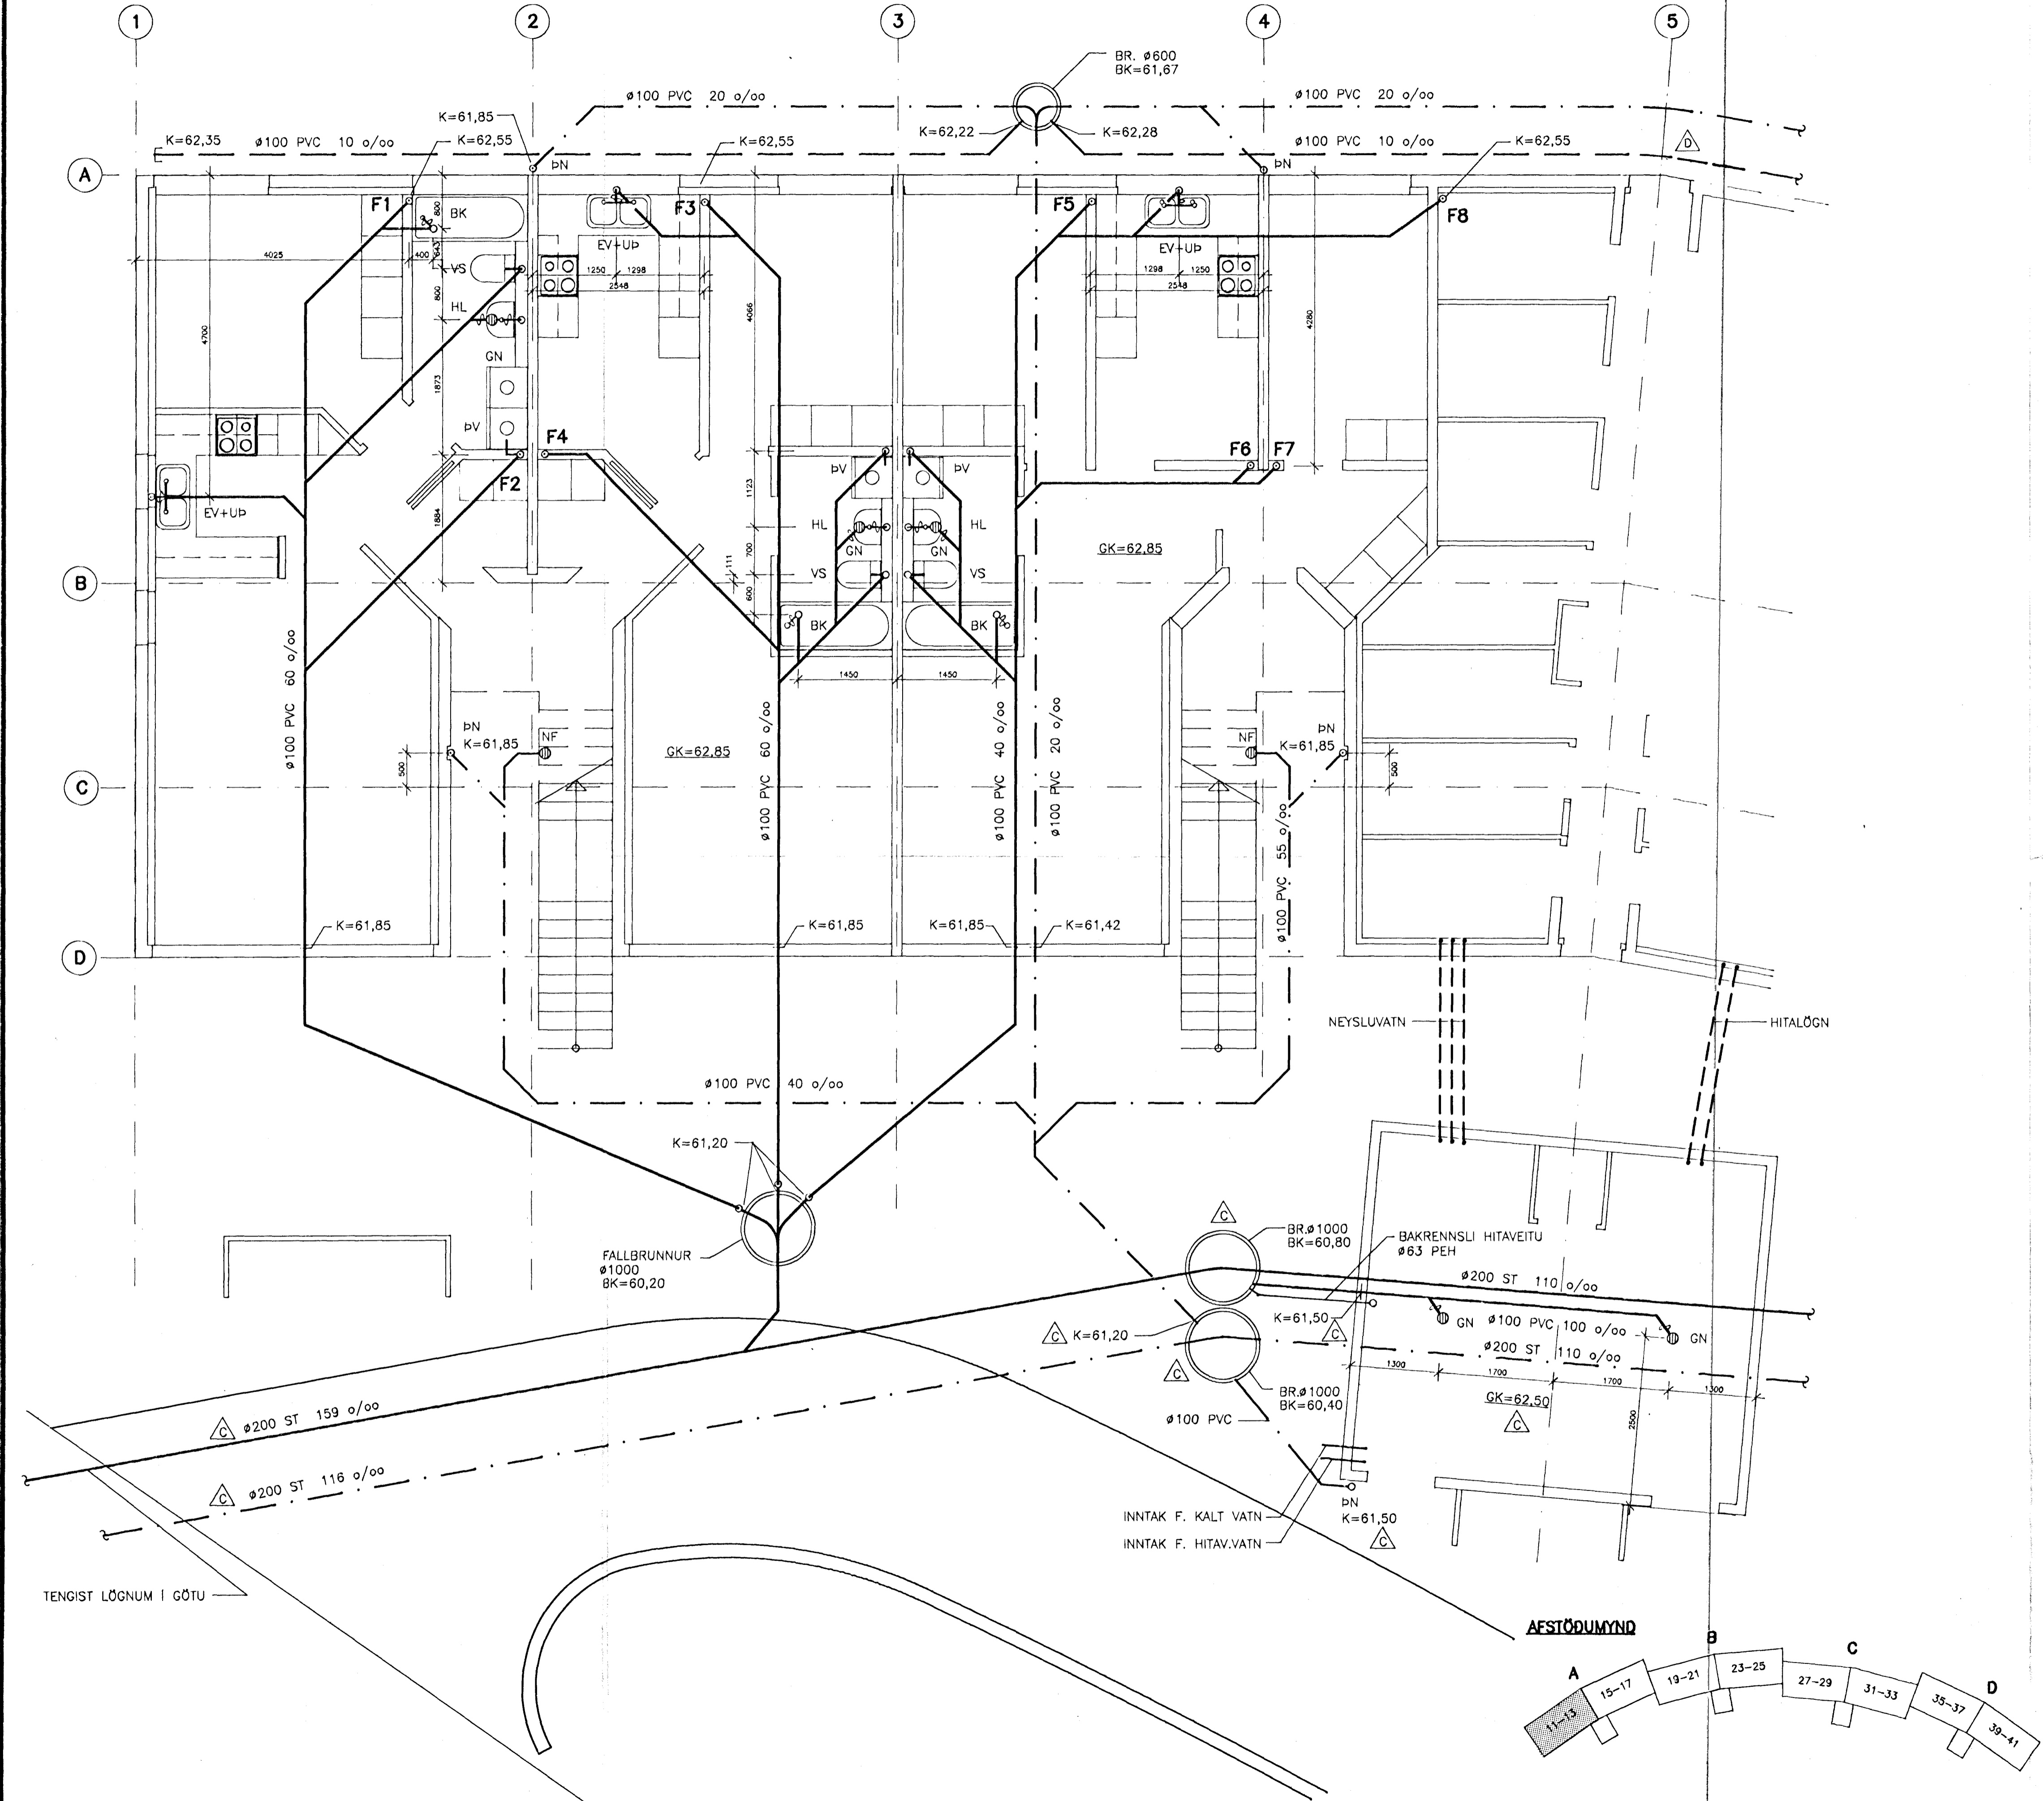

**A**

SKÝRINGAR OG SÉRMYNDIR: SJÁ TEIKN. NR. -200

**hönnun hf** Ráðgjafarverkefningar FRV · Síðumúla 1 · 108 Reykjavík  
Sími (91)84311 · Utbúi: Reyðarfjarður · Hvolsvöllur

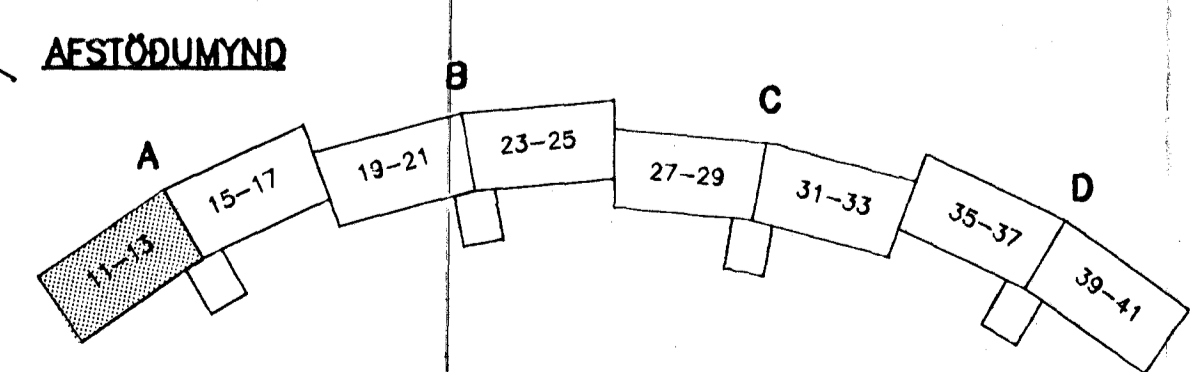

M.	KLUKKUBERG 11-17, HFJ.	E
H. GGH		D 10.1.92/RGS
T. KaPa	FRÁVEITULÖGN;	C 14.3.90/RGS
Y. RGS	GRUNNLÖGN, GRUNNMYND.	B 20.12.90/RGS
G. 19/-/5		A 16.1.90/RGS
DAGS	5.11.90	SKVP 1:50
		90329-201A