

HITALAGNIR. TÚMMYND . 1: 50

OFN NR	STAÐS	HITAT KKAL	LENGD MM	HÆÐ MM	TENGI
101	BÍLG	1.010	1800	600	
102	ÞVOTTUR	400	800	600	
103	ANDD	450	800	600	
104	HERB	910	1800	600	
105	BAD	550	700	600	
106	HERB	890	1800	600	
107	STIGI	1120	1900	400	
108	GEYMSLA	750	2000	600	
201	HERB	1.200	2100	600	
203	BORÐST	1.570	2000	400	
204	STOFA	1.310	1800	400	
205	STOFA	2.140	3000	400	
206	HJÓN	1.120	2000	600	
207	VS	400	800	600	
SAMTALS		14810			

ÁÐUR EN GENGID ER FRÁ OFNAPÖNTUN SKULU BYGGINGAFR. OG TÆKNIFRÆÐINGUR SANNREYNA STÆRÐIR OG AFKÖST OFNA

01	JAN '99	OFN 202 BURT. OFN	
BR:	DAGS.	201 STEKKADUR	GH
		EDLI BR.	SIGN.

KLUKKUBERG 1A

HAFNARFIRÐI

HITALAGNIR. TÚMMYND

DAGS. FEB. 97


VERK NR. 9830

TEIKN NR. 2-04

HANNAÐ 4.11.

TEIKNAD 4.11.

YFIRFARIÐ

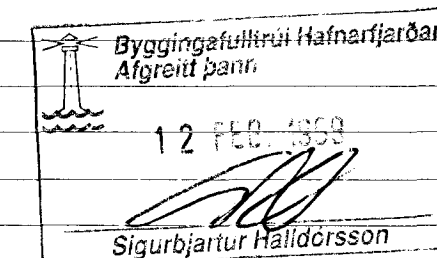

TÆKNIÞJÓNUSTA
SIGURÐAR ÞORLEIFSSONAR ehf

STRANDGÖTU 11 - 220 HAFNARFJÖRDUR - Sími 555 4255 - FAX 565 2875