

GRUNNMYND • 1 : 50



DI 29.06.97 MILLIVEGGUR FJALLABUR 9.V.  
BR: DAGS. EDLI BR. SIGN


KLUKKUBERG 5  
HAFNARFJÖRÐI

UNDIRSTÖÐUR - MÁLTEKNI

MKV • 1 : 50  
DAGS. JÚNÍ '97  
VERK NR. 9727  
TEIKN NR. 1-02  
HANNAD K.F. 27.7.  
TEIKNAD G.H.  
YFIRFARIÐ

SKÝRINGAR

ALMENNAR SKÝRINGAR SJÁ BL. NR. 1-01.  
SNIÐ SJÁ BL. NR. 1-03.

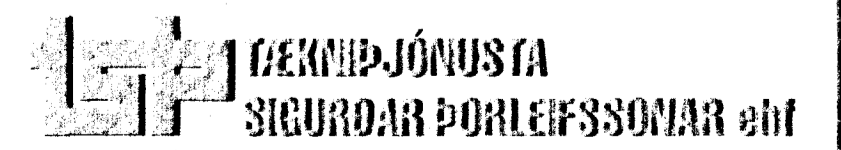

STRANDGÖTU 11 • 220 HAFNARFJÖRÐUR • Sími 565 4255 • FAX 565 2675