


ÚTLIT AUSTUR. SUÐURENDI. M. 1:100

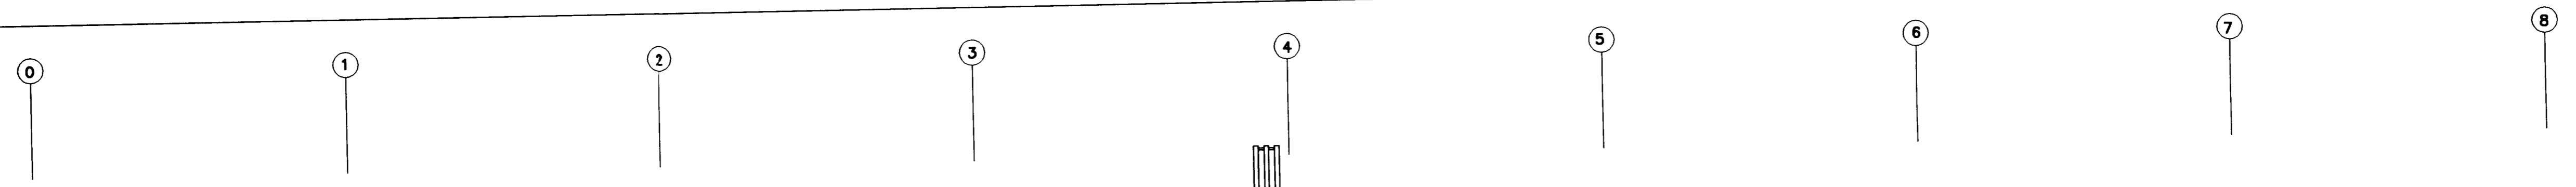

ÚTLIT VESTUR. NORÐURENDI M. 1:100

L: 83,450

TEIKNISTOFAN EHF
 ÁRMOLA &
 108 REYKJAVÍK • Sími 553 8780

GÍSLI HALLDÓRSSON ARKITEKT FAI
 JÓSEF REYNIS ARKITEKT FAI
 LEIFUR GÍSLASON BYGGINGAFLÆNGINGUR BFI
 IVON STEFÁN CILJA ARKITEKT FAI
 BJARNI SNEBARNSSON ARKITEKT FAI
 ASGER ÁSGERSSON BYGGINGAFLÆNGINGUR BFI

VERKEFNI
 GRUNNSKÓLI Í ÁSLANDI
 KRÍUÁS 1
 HAFNARFIRÐI

VERK
 ÚTLIT AUSTUR OG VESTUR

MÁL: 1:100 NR: 408-02
 DAGS: 24.11.2000 1.06B
 HANNAÐ: BJ.SNÆ TEIKNAD: .bb
 ATHS: 02.07.01 Reyndarteikning - aj
 B: 02.01.02. loftnet tilfært.bb

SAMB.
 0202 524081