


2. HÆÐ

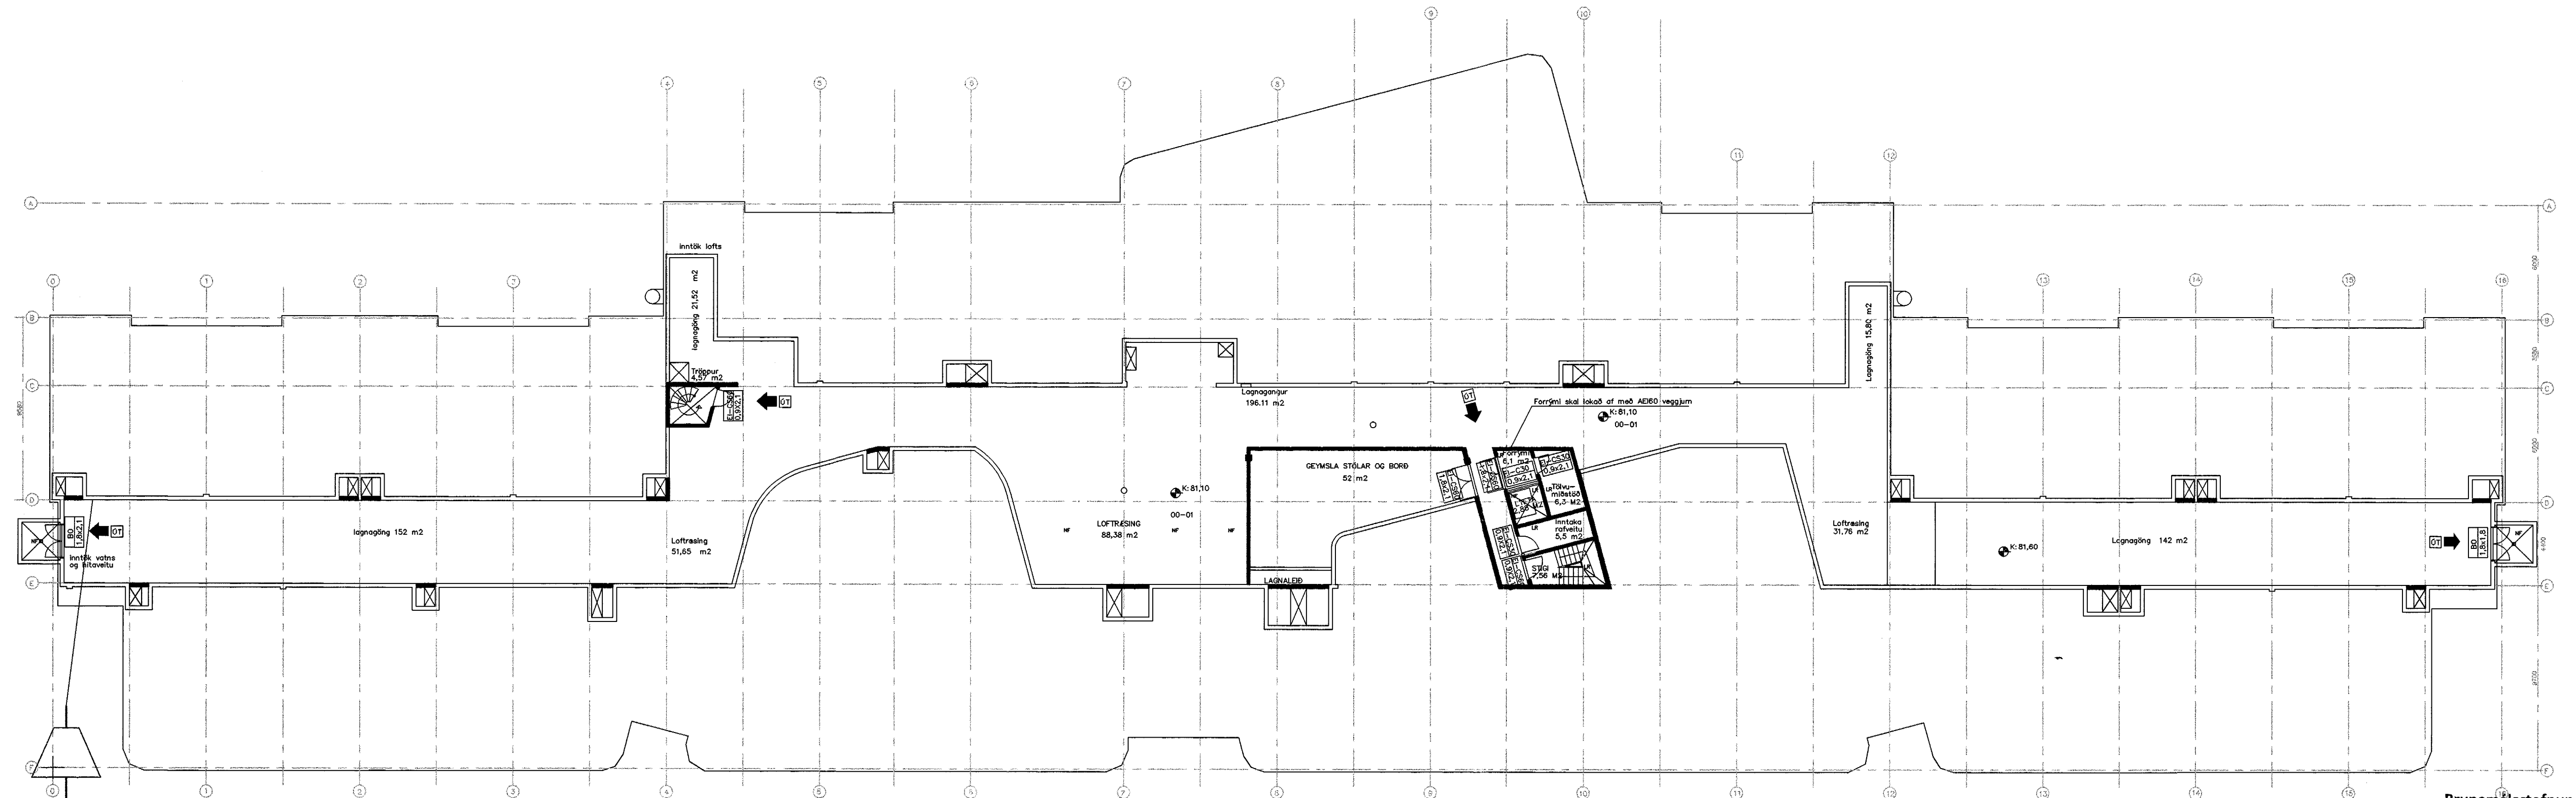

KJALLARI

Brunamálstofnun
ríkisins
YFIRFARID

17 JULI 2000

Sbr. bréf 17. júlí 2000.
Baldur Friðriksson B.F.

Skýringar, sjá teikningu nr. 5138-402

- Brunasamstæðuskil E190/RE190
- Brunahólfun E160/RE160

A	12.07.2000	GA		
Ýmsar breytingar				
ÓTÁFA	DAÐSETNING	TEIKNAD	YFIRFARID	SAMÞYKKT
EDLI BREYTINGAR				
HANNAD:	GA	DAGS.:	29.05.'00	
TEIKNAD:	SI	KVARDI:	1:200	
YFIRF.:		VERK NR.:	5138	
SKRÁ:	5138-403	TEIKN.NR.:	403	

SAMB.:

FRUMSTÆRD BLADS A1 - BLADSTÆRD A3, MINNKUN 1:2

GRUNNSKÓLI Í ÁSLANDI
KRIUÁS 1, HAFNARFIRDI

Brunavarnaruppdráttur
2. hæð og kjallari



BORGARTÚNI 17 - 105 REYKJAVÍK NETFANG: fjarhitun@fjarhitun.is
SÍMI 562 8955 - FAX 562 8950 VEFSDA: www.fjarhitun.is
KENNITALA: 700186-1649