




ÚTLIT SUÐUR MKV. 1 : 100

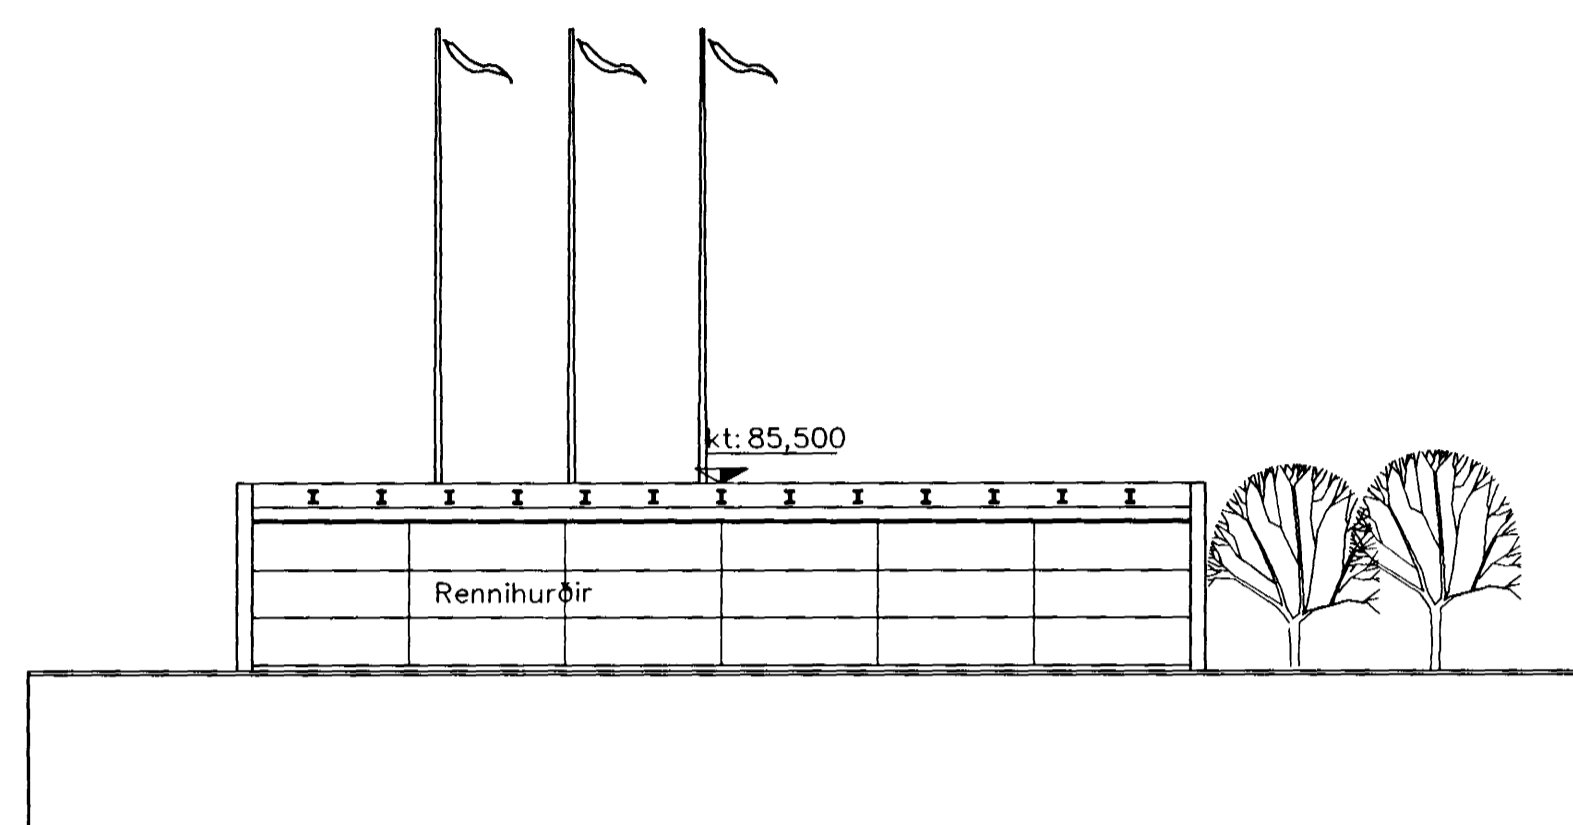

SNEIÐING B-B MKV. 1 : 100

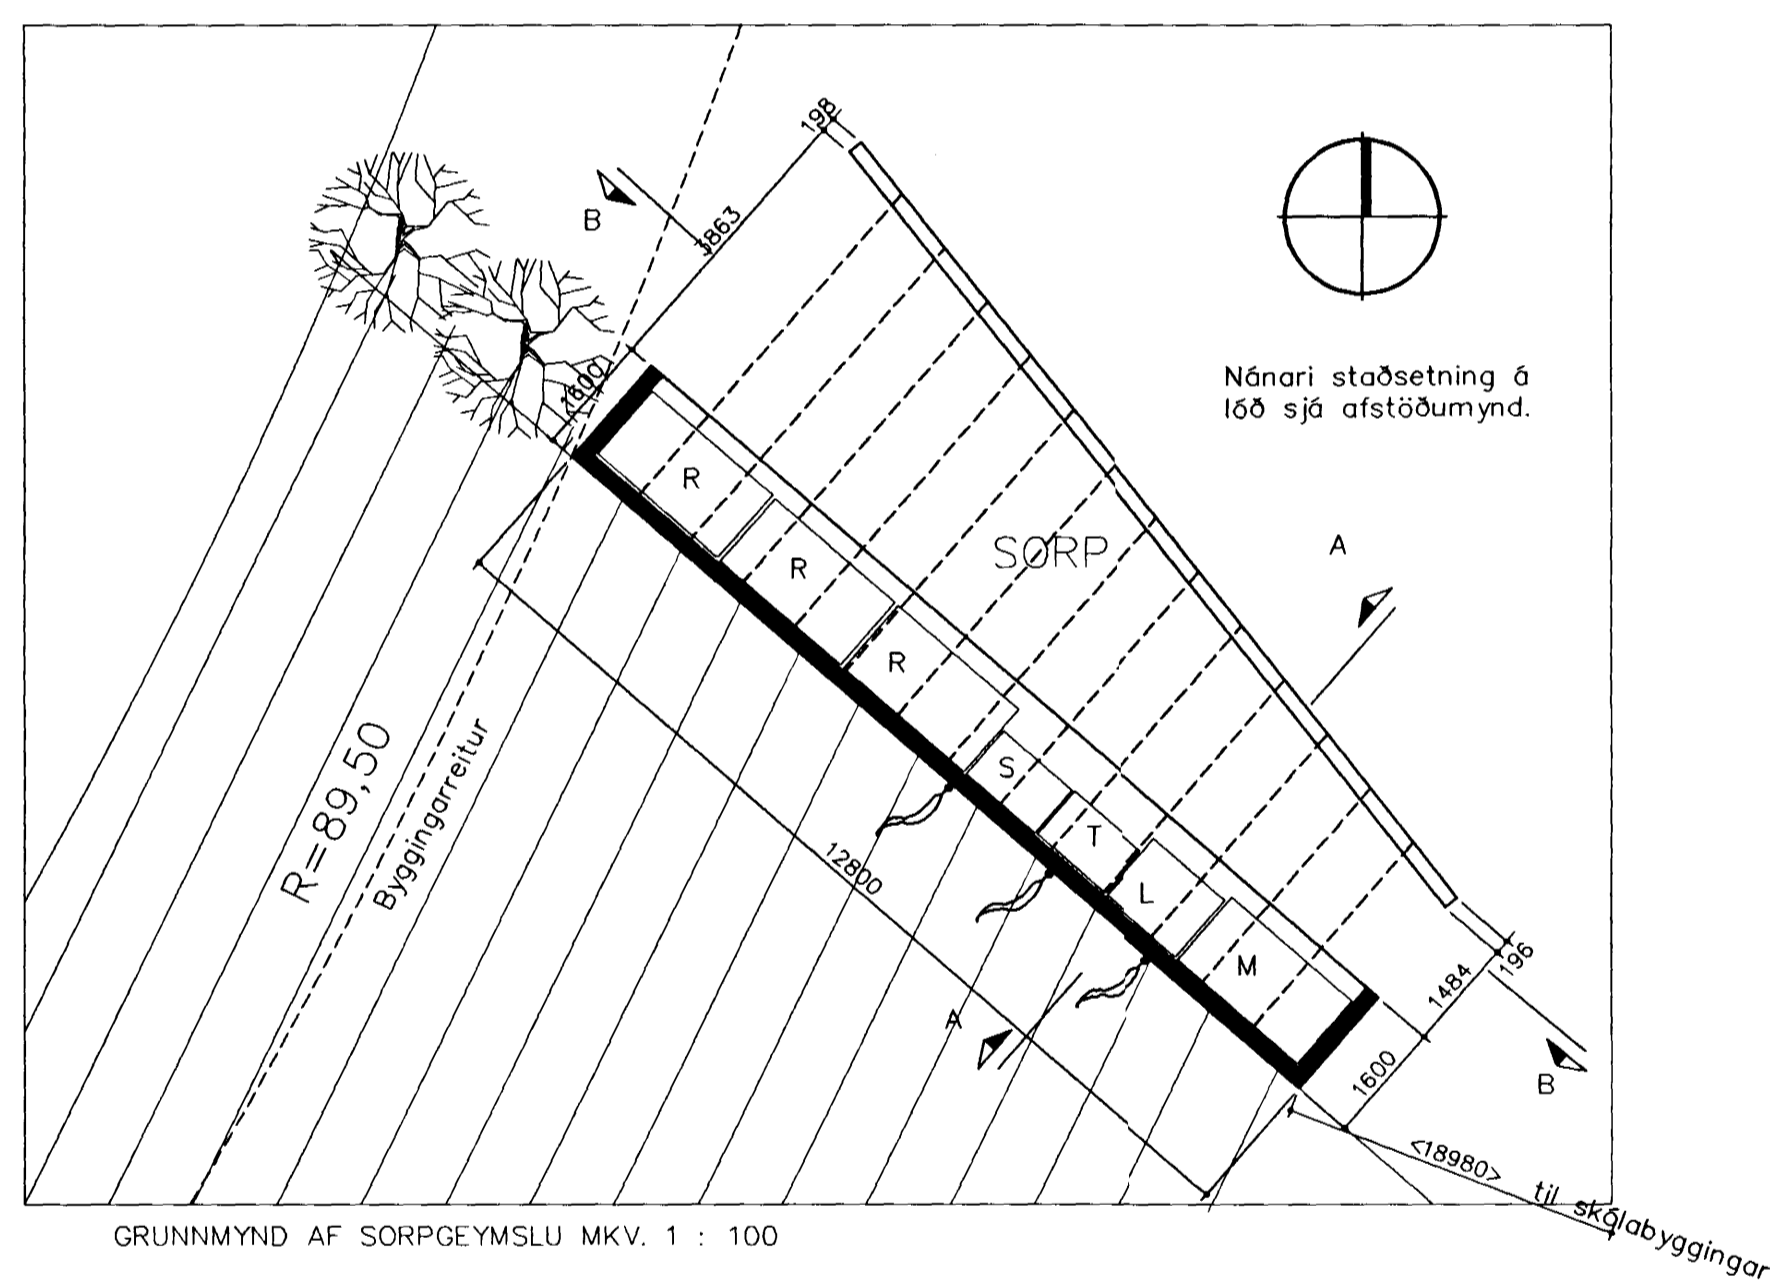

GRUNNMÝND AF SORPGEYMSLU MKV. 1 : 100

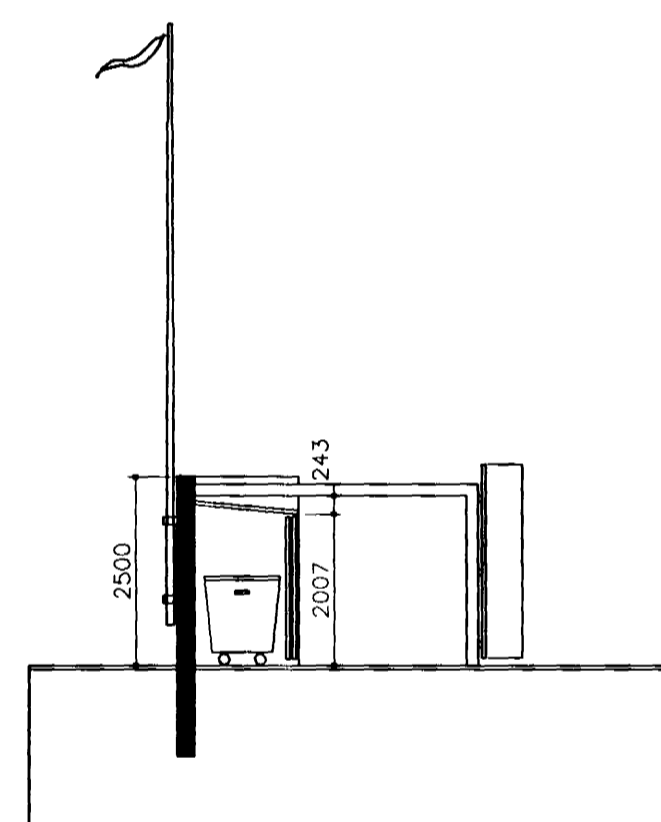

SNEIÐING A-A MKV. 1 : 100

SORP

Blandað frákast

R 3.stk plastgámar 110 x 210 cm samtals 4,6 m³

Pappír til endurvinnslu


M 1.stk plastgámur 110 x 210 cm fyrir alm. pappír. Samtals 1,5 m³

L 1.stk plastgámur 100 x 125 cm fyrir gæðapappír. Samtals 1,1 m³

Lífrænt frákast

S 1.stk plastgámur 75 x 120 cm fyrir kjötmeti. 0,66 m³

T 1.stk plastgámur 75 x 120 cm fyrir grænmeti. 0,66 m³

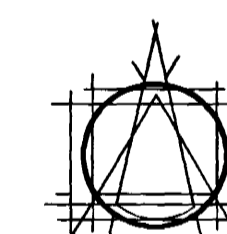

TEIKNISTOFAN EHF
ARMOLAS
108 REYKJAVÍK • Sími 865 6700

GISLI HALLDÓRSSON ARKITEKT FAI
JÓSEF REYNIS ARKITEKT FAI
LEIFUR GÍSLASON BYGGINGAFRÉÐINGUR BFI
IVON STEFÁN GÍLLA ARKITEKT FAI
BJARNI SNAEBJÖRNSSON ARKITEKT FAI
ASGEIR ASGEIRSSON BYGGINGAFRÉÐINGUR BFI

VERKEFNI
GRUNNSKÓLI Í ÁSLANDI
KRIUÁS 1
HAFNARFIRÐI

VERK
SORPGEYMSLA Á LÖÐ

MÁL 1:100 NR. 408-02

DAGS. 22.05.2000 1.11

HANNAÐ B.J.SNÆ TEIKNAD .bb

ÁTH. 02.07.01 Reyndarteikning - aj

SAMB.