
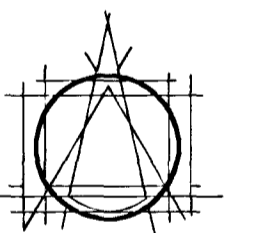


Byggingufulltrúi Havnarfélags
Alfreitt Þann
16 JULI 2001
VG

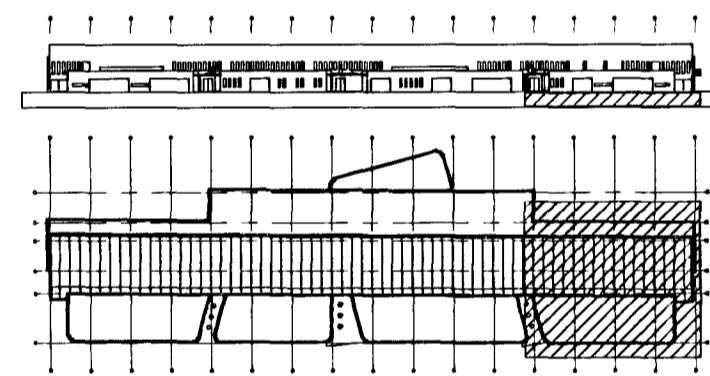

TEIKNISTOFAN EHF
ARMÓLÓB
108 REYKJAVÍK • SMÍ 053 8790
GÍSLI HALDÓRSSON ARKITEKT FAI
JÓSEF REYNIS ARKITEKT FAI
LEIFUR GÍSLASON BYGGINGAFRÉÐINGUR BFI
IVON STEFAN GÍLA ARKITEKT FAI
BJARNI SNEBJORNSSON ARKITEKT FAI
ASGEIR ASGEIRSSON BYGGINGAFRÉÐINGUR BFI

VERKEFNI
GRUNNSKÓLI Í ÁSLANDI
KRIUÁS 1
HAFNARFIRÐI

VERK
GRUNNMYND KJALLARA
SUBURENDI

MÁL 1:50
DAGS. 01.08.2000
HANNAD B.J.SNÆ
ATHS. A: 02.07.01 Reyndarteikning -oj

NR. 408-02
2.1.14
TEIKNAD .bb

SAND
Dan: [Signature] 02023488

GRUNNMYND KJALLARA SUBURENDI MKV. 1:50