



Plan 1:100

Gambvirk & fundi bygginga-
heindar þ. 1. 11. 1972
BYGGINGA-
I HAFNARHÍÐI
S. Jónsson


11/12 '74 Samþ. v/ Valters Sigu. Frann Hólab. b.
30/2 '75 - v/ Þorkelju Finnsson Krok. b. b.
20/2 '80 - v/ Stefens Þeistare. - 4

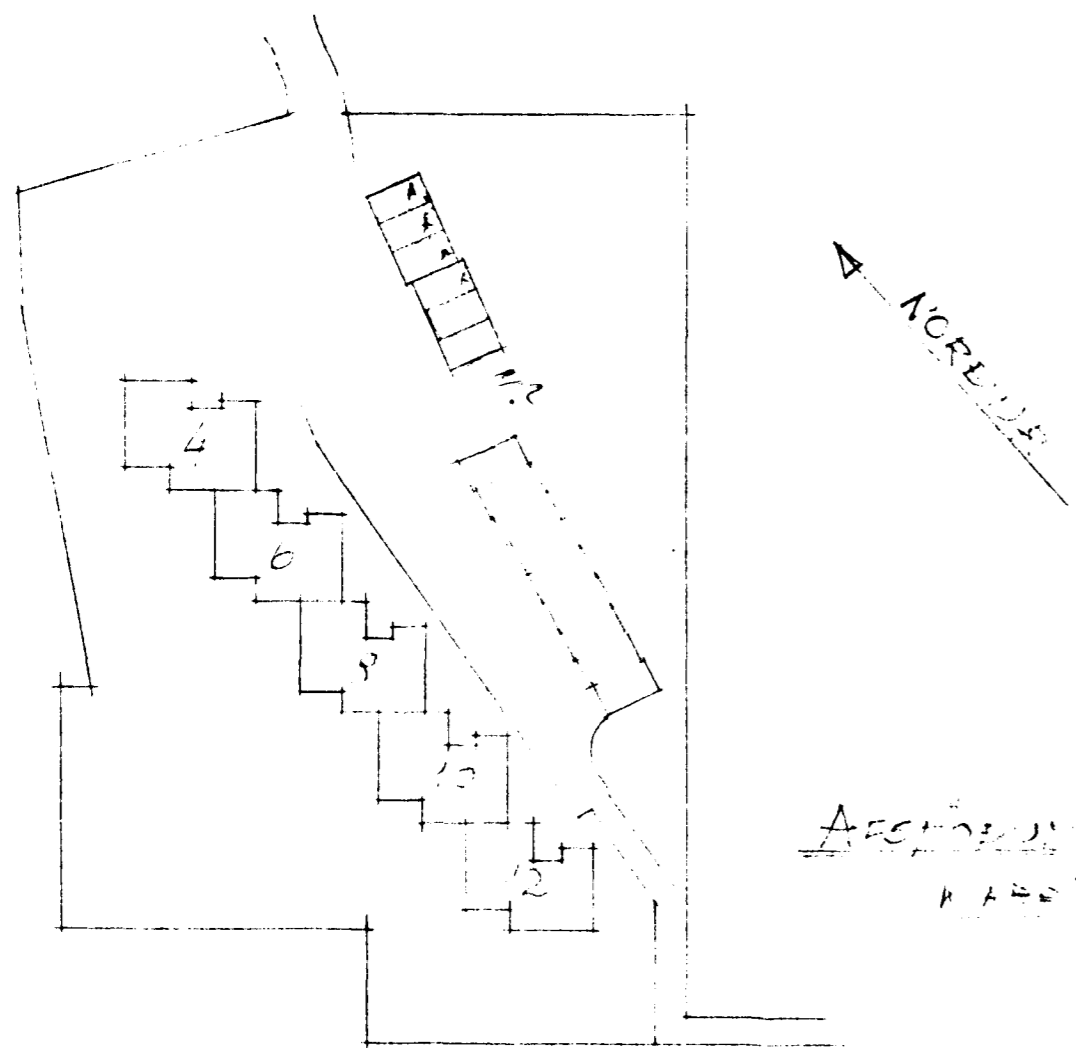


ÁRCHITECTUR
K. J. JÓNSSON

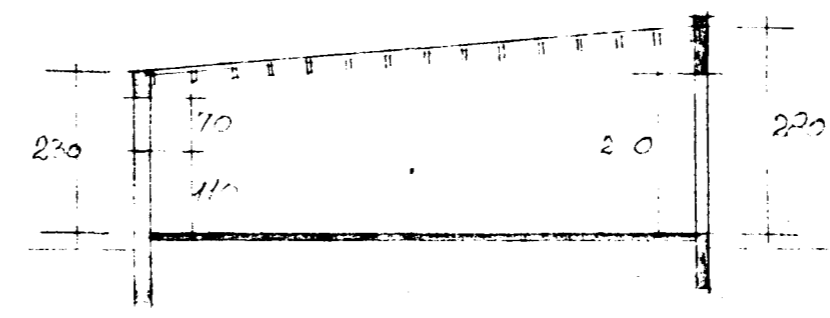

6. 1. 1. 1.

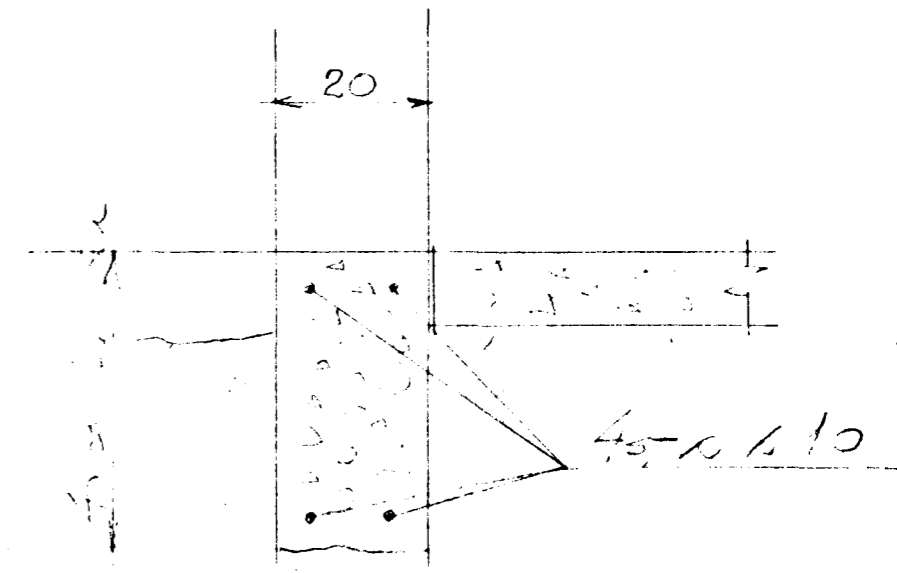

SUND
KVARN
1.1.10

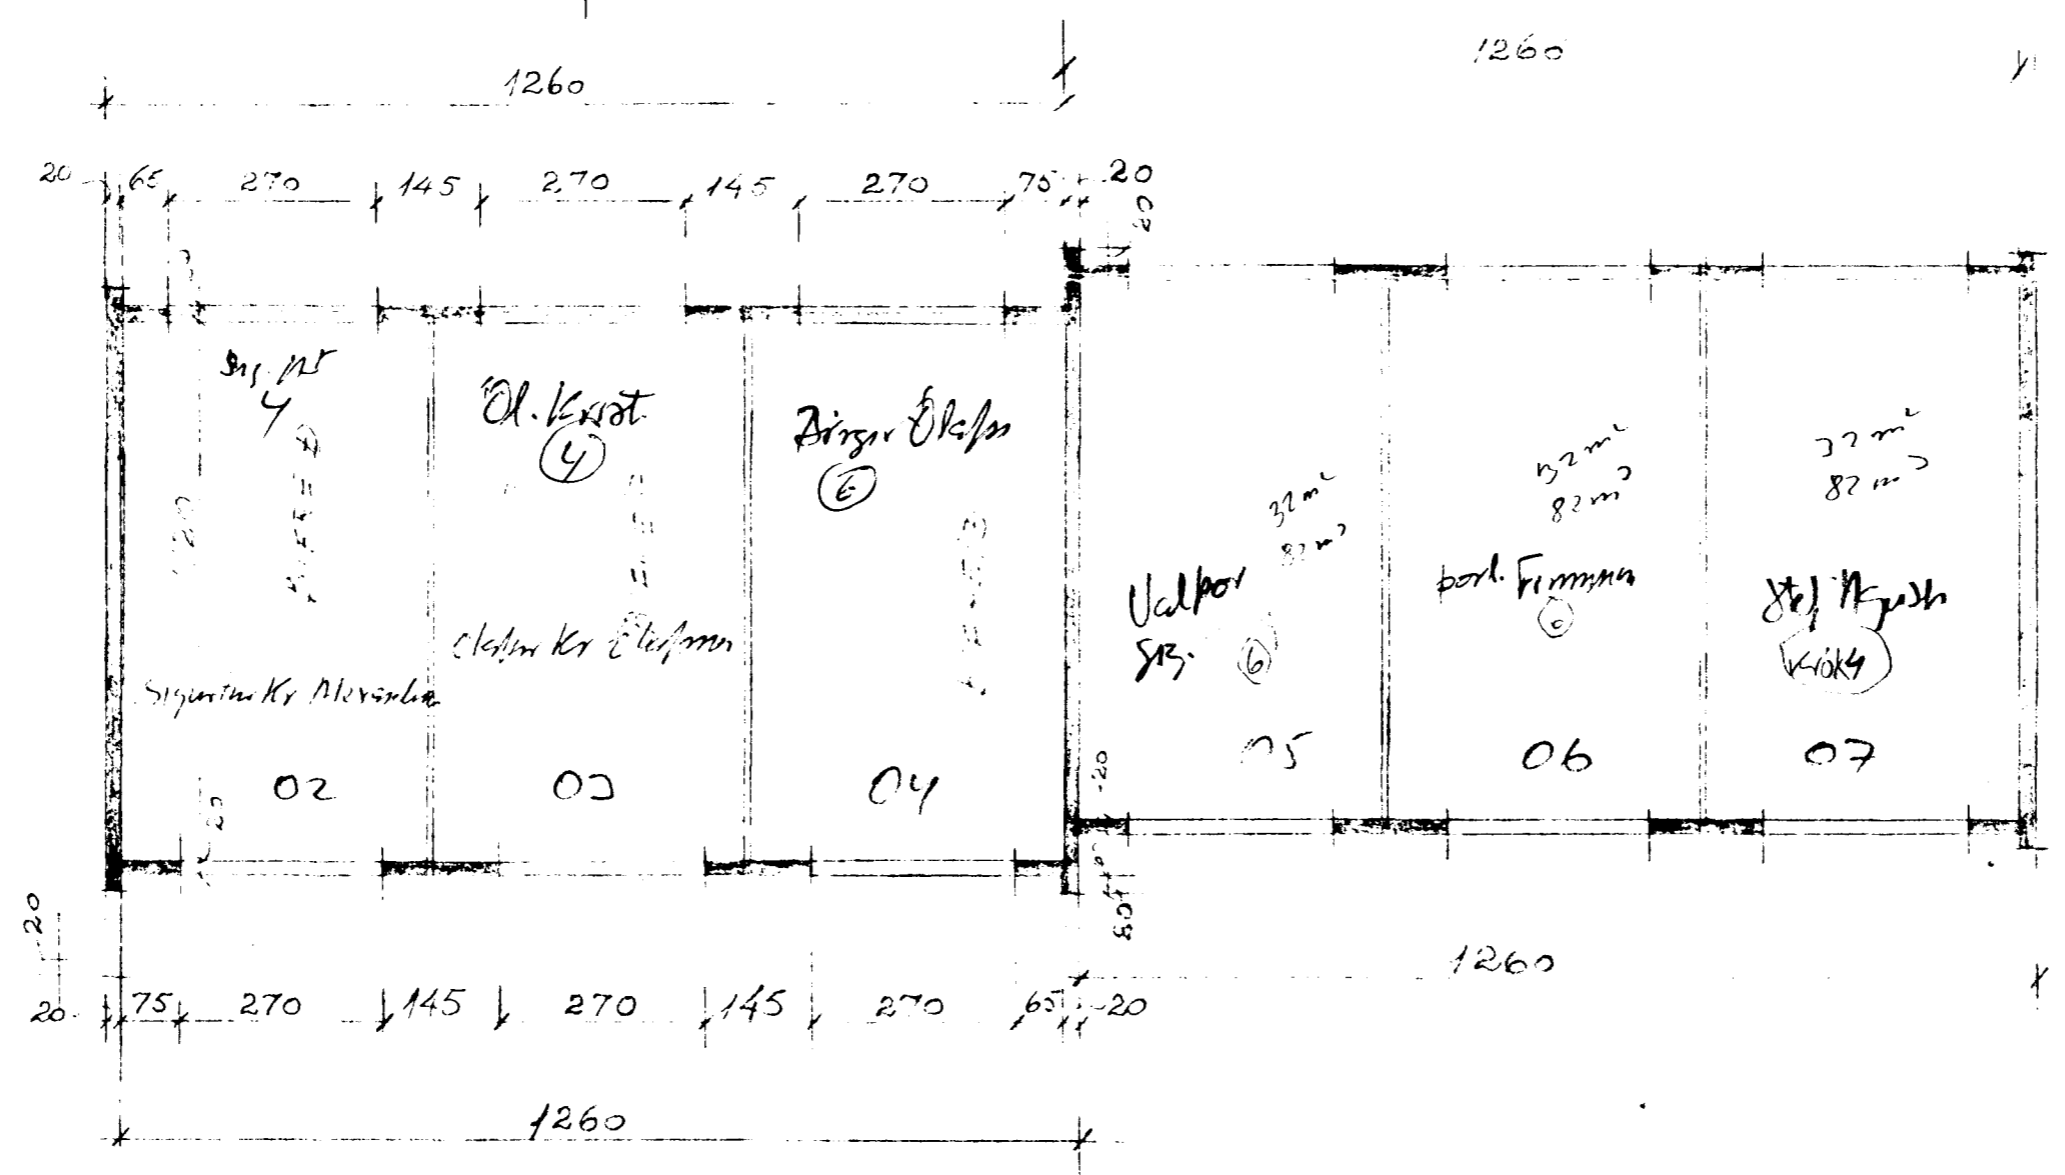

GEOMETRÍ
K. J. JÓNSSON

KRÖNN
B. JÓNSSON

BREYTT 1 NOVEMBER 1972

H. Jónsson
1. 11. 1972