
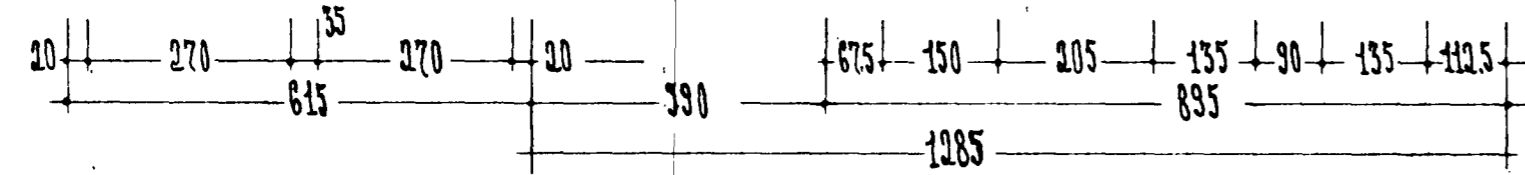
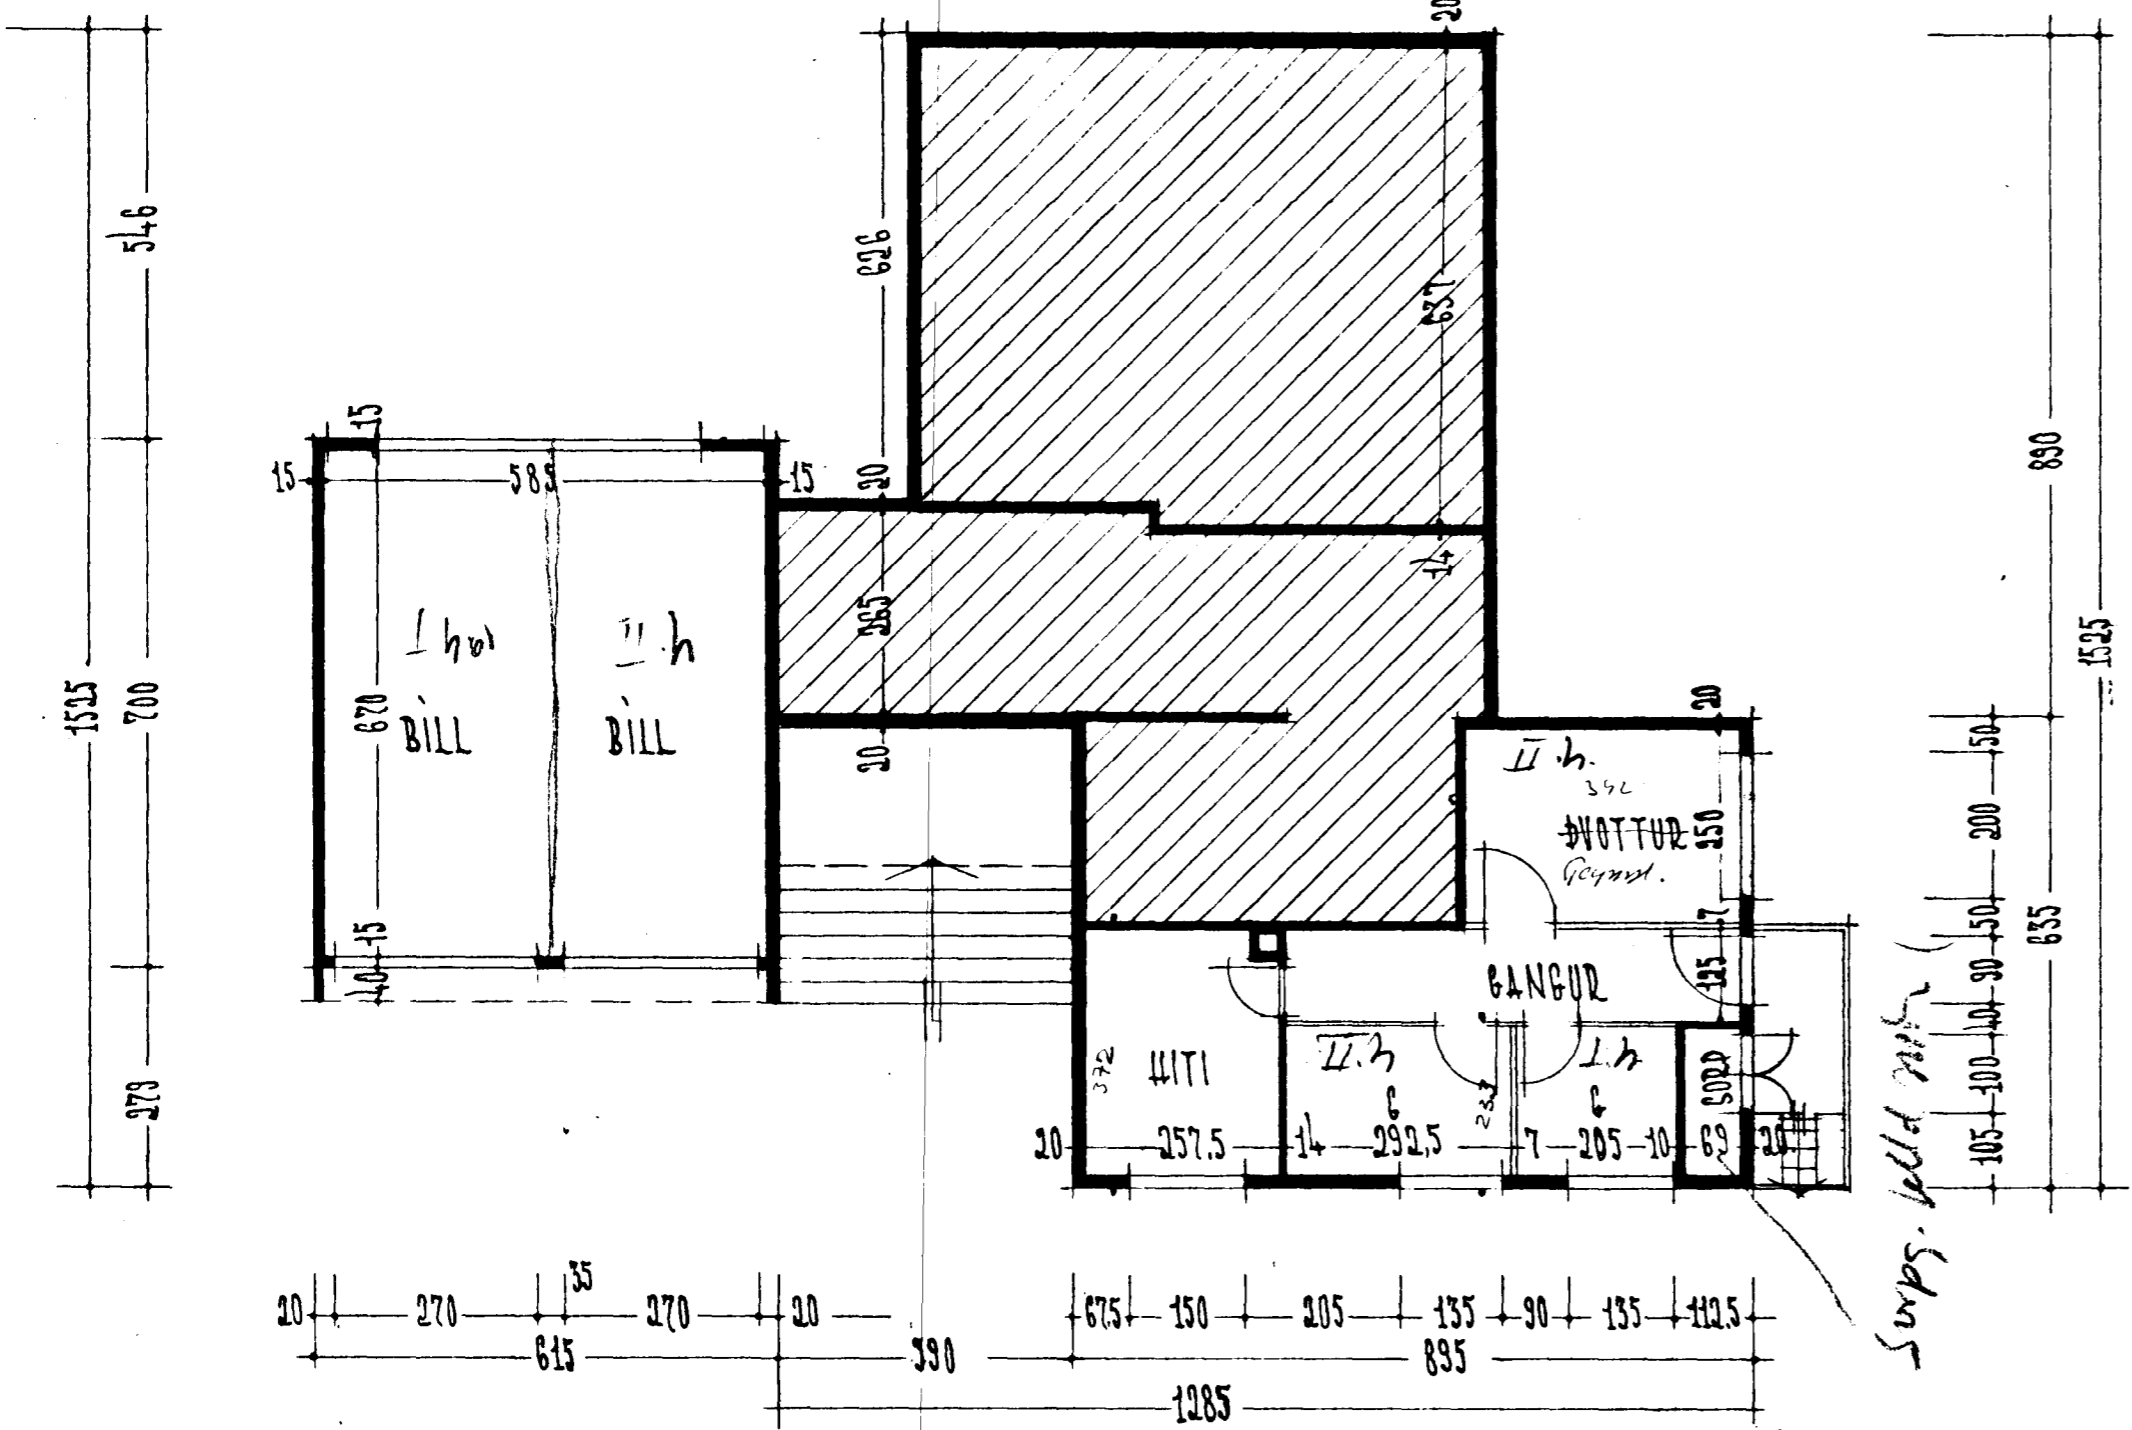
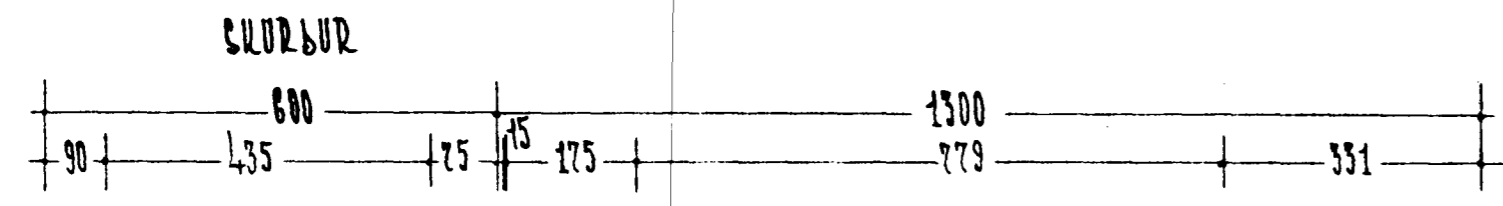


UVIHOFT NR. 6 HAFNARFIRÐI M 1:100

Einar Þjornar
Miscan
Konardur Mejsursson
Jan Gunnar



Samþykkt á fundi bygginga-
 nefndar p. 12. 8. 1964

BYGGINGAFULLTRÚINN
 I HAFNARFIRÐI
Póst. Longfner

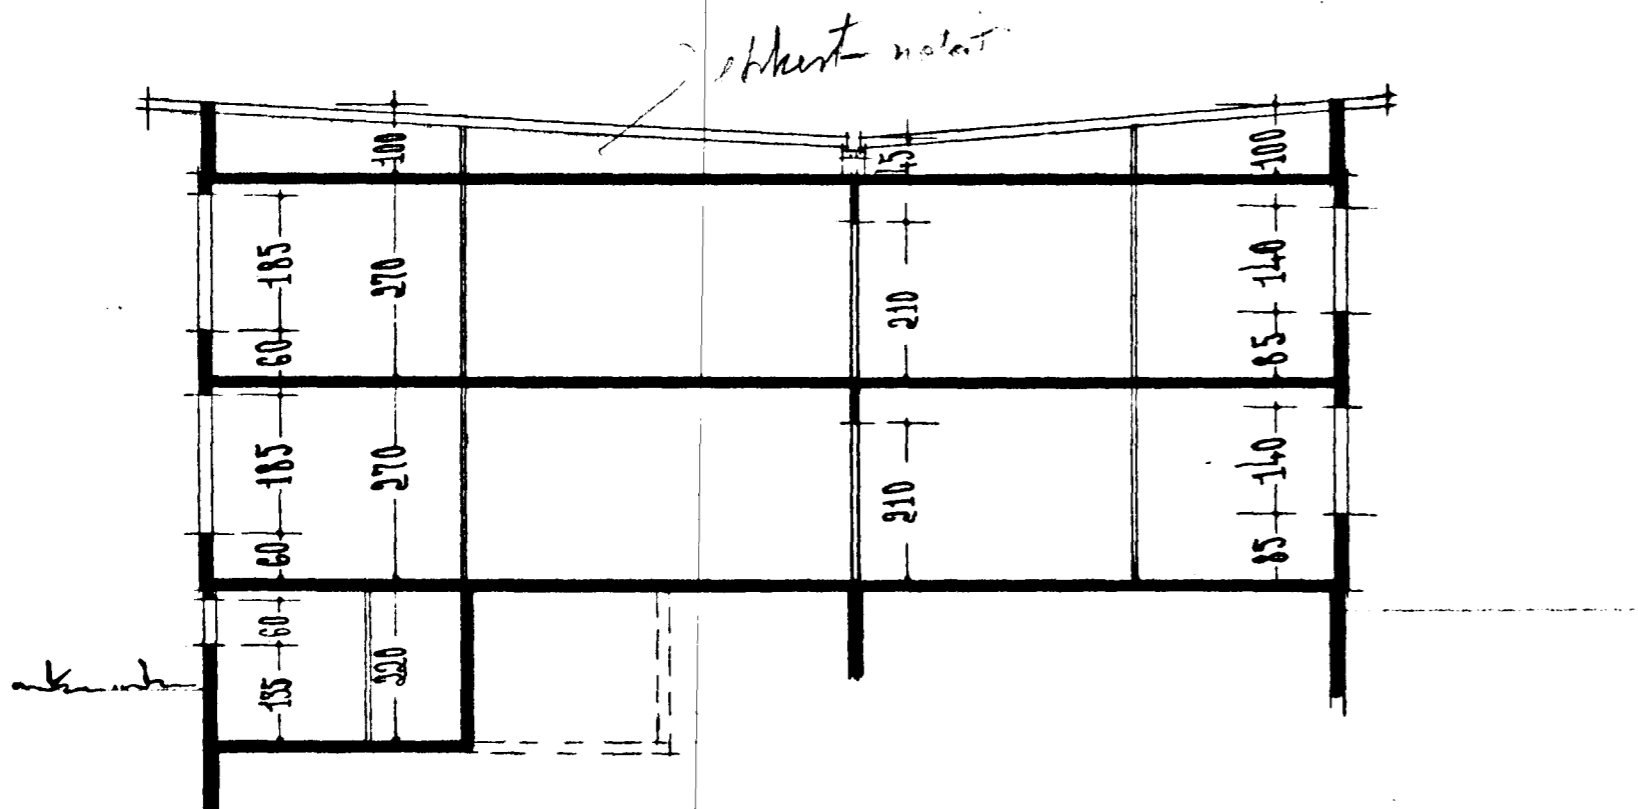

KJALLARI

$\frac{390}{10.25}$

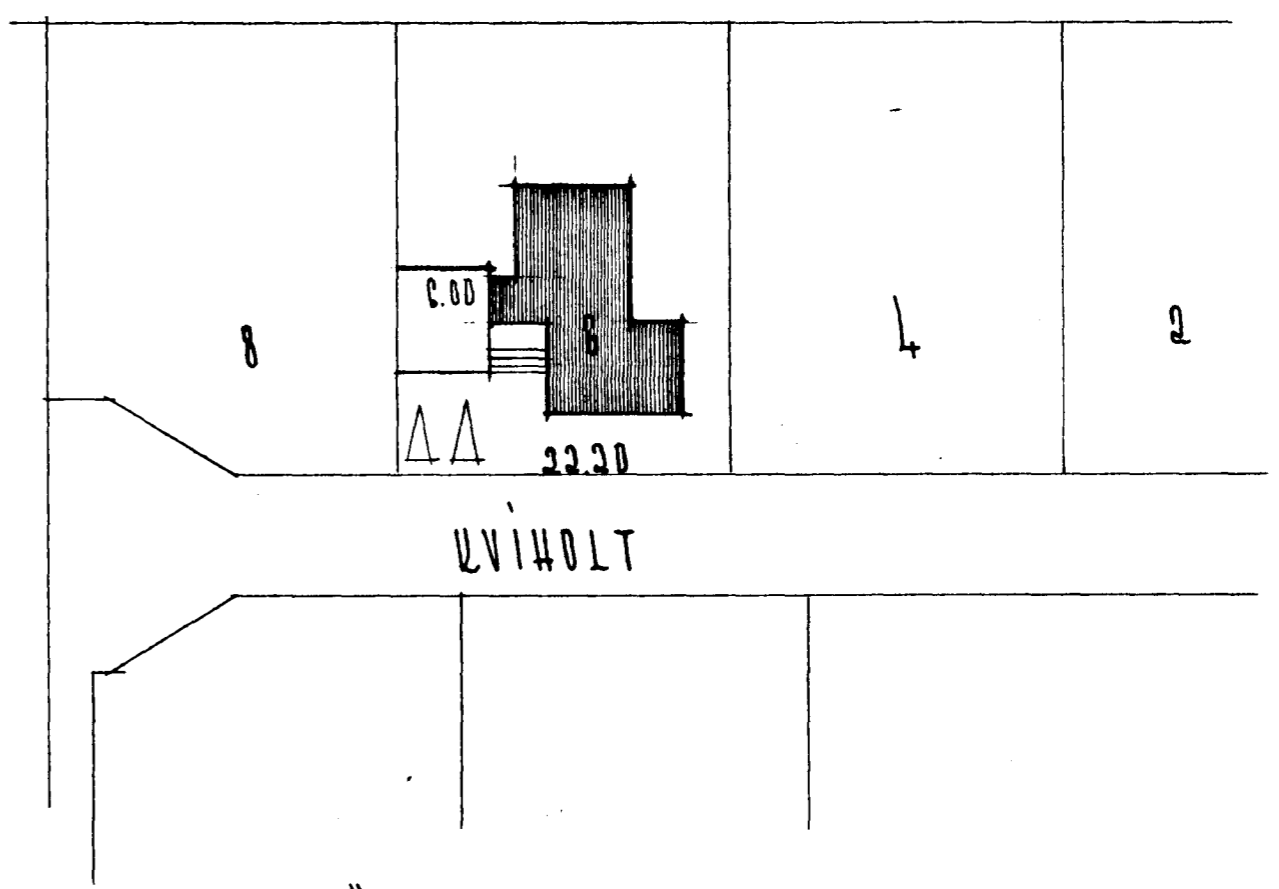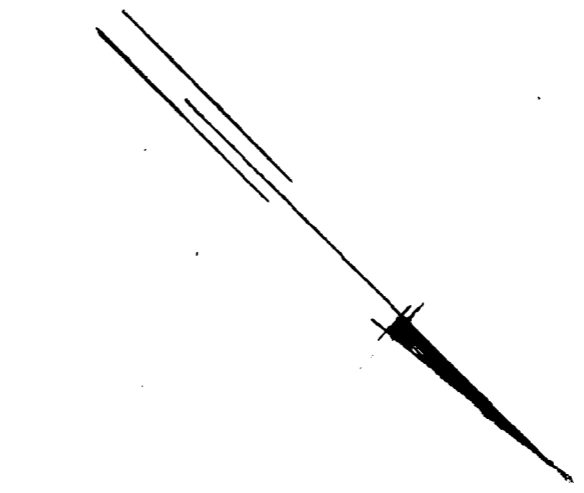

AFSTÖÐUMYNI M 1:500
 FLATARMÁL HÚSS 132.02 M²

7

REVURVIR I AGUST 1964
Thjartan Sveinsson