


KVIHOLT NR 8 HAFNARFJEDI M. 1:100.


Þorvaldur Magnússon  
Guðbjörg Þ. Stefánsdóttir  
Einar Hallgrímsson

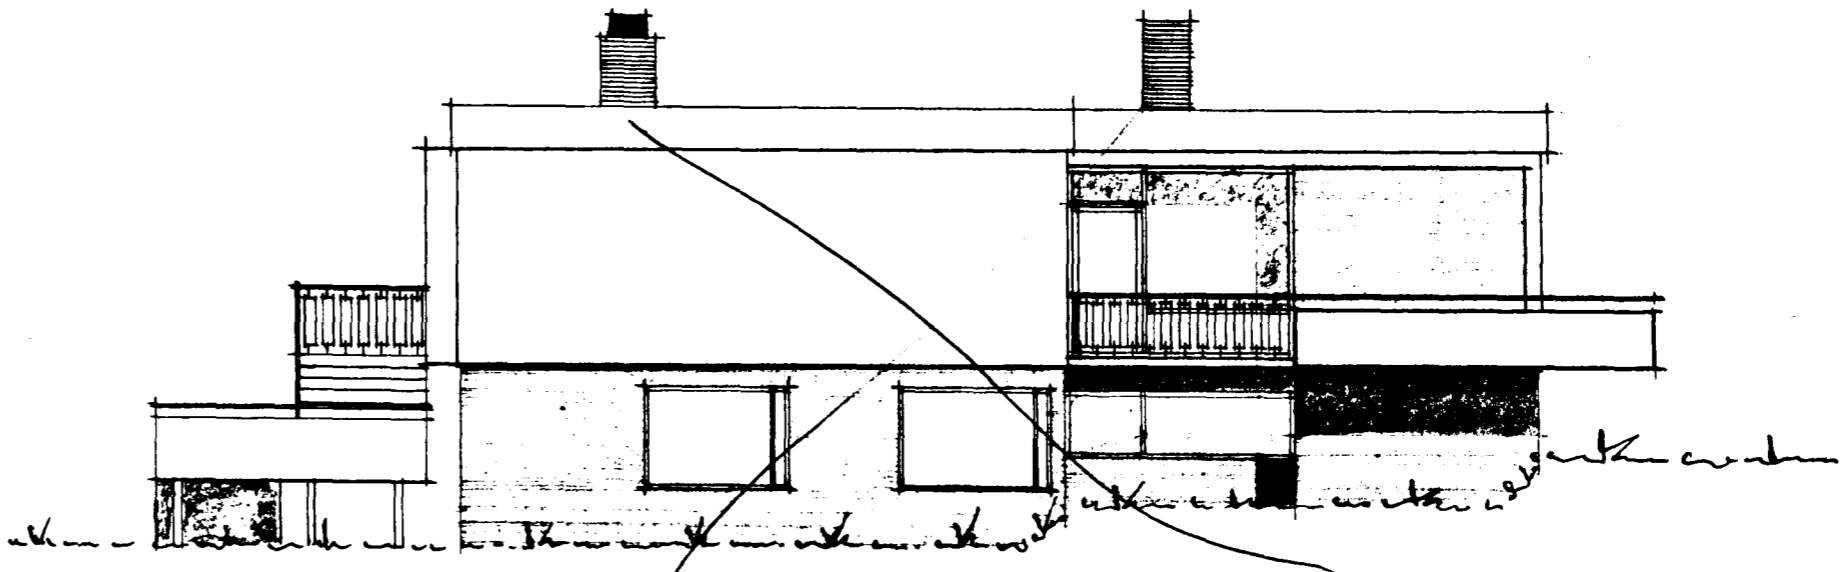


NORD-AUSTUR



NORD-VESTUR

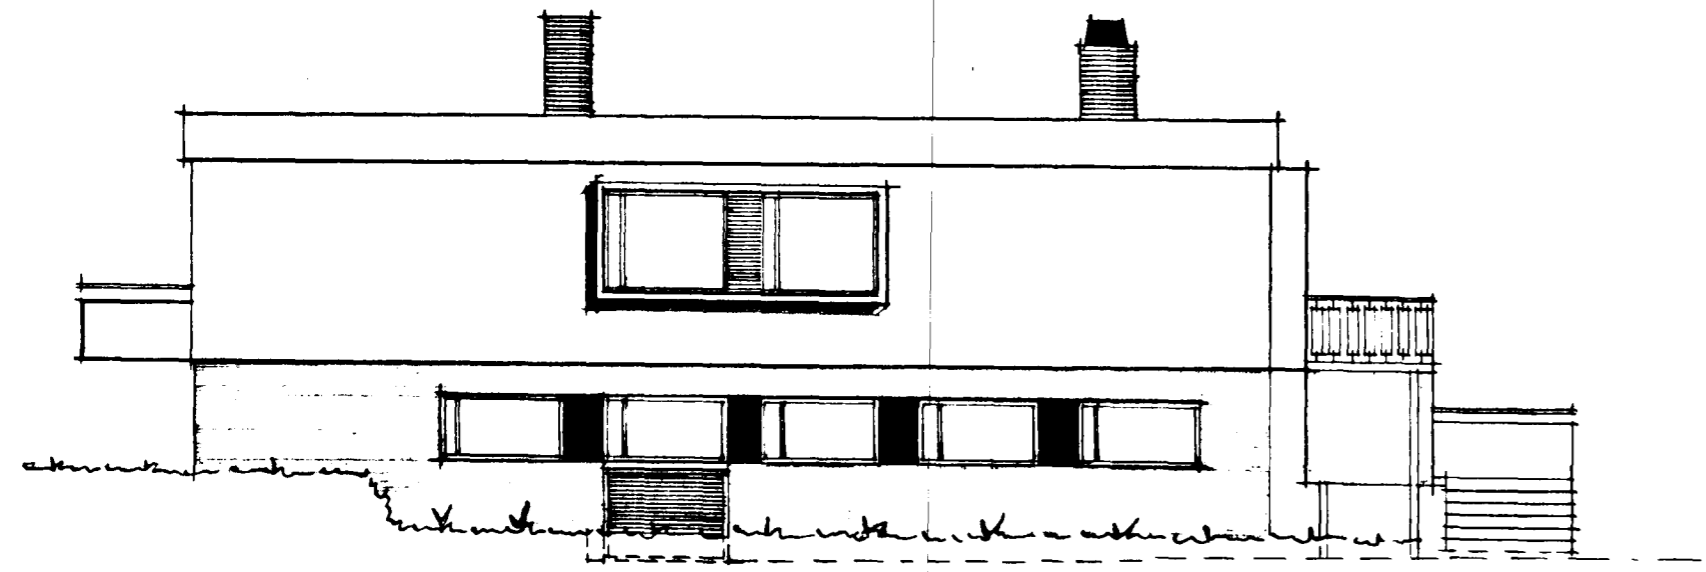

SUD-AUSTUR

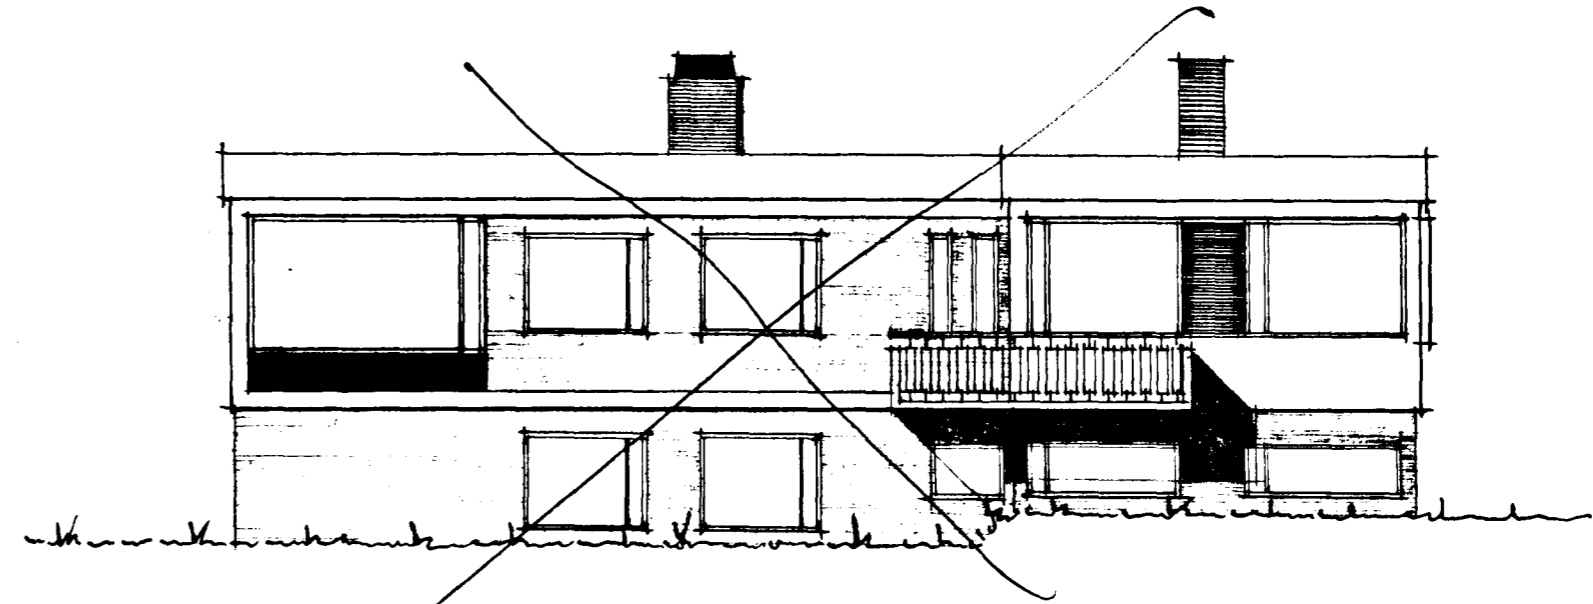

SUD-VESTUR

REYKJAVIK I MARS 1965

Þjartan Sveinsson