



Úr Gildi

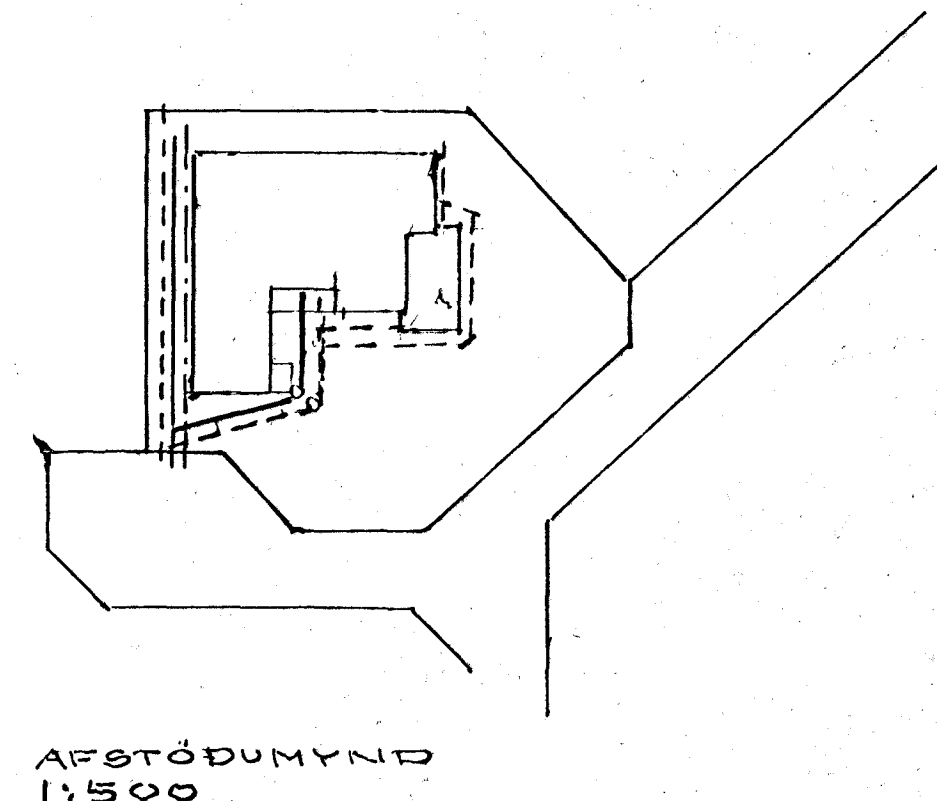

ÓGILT

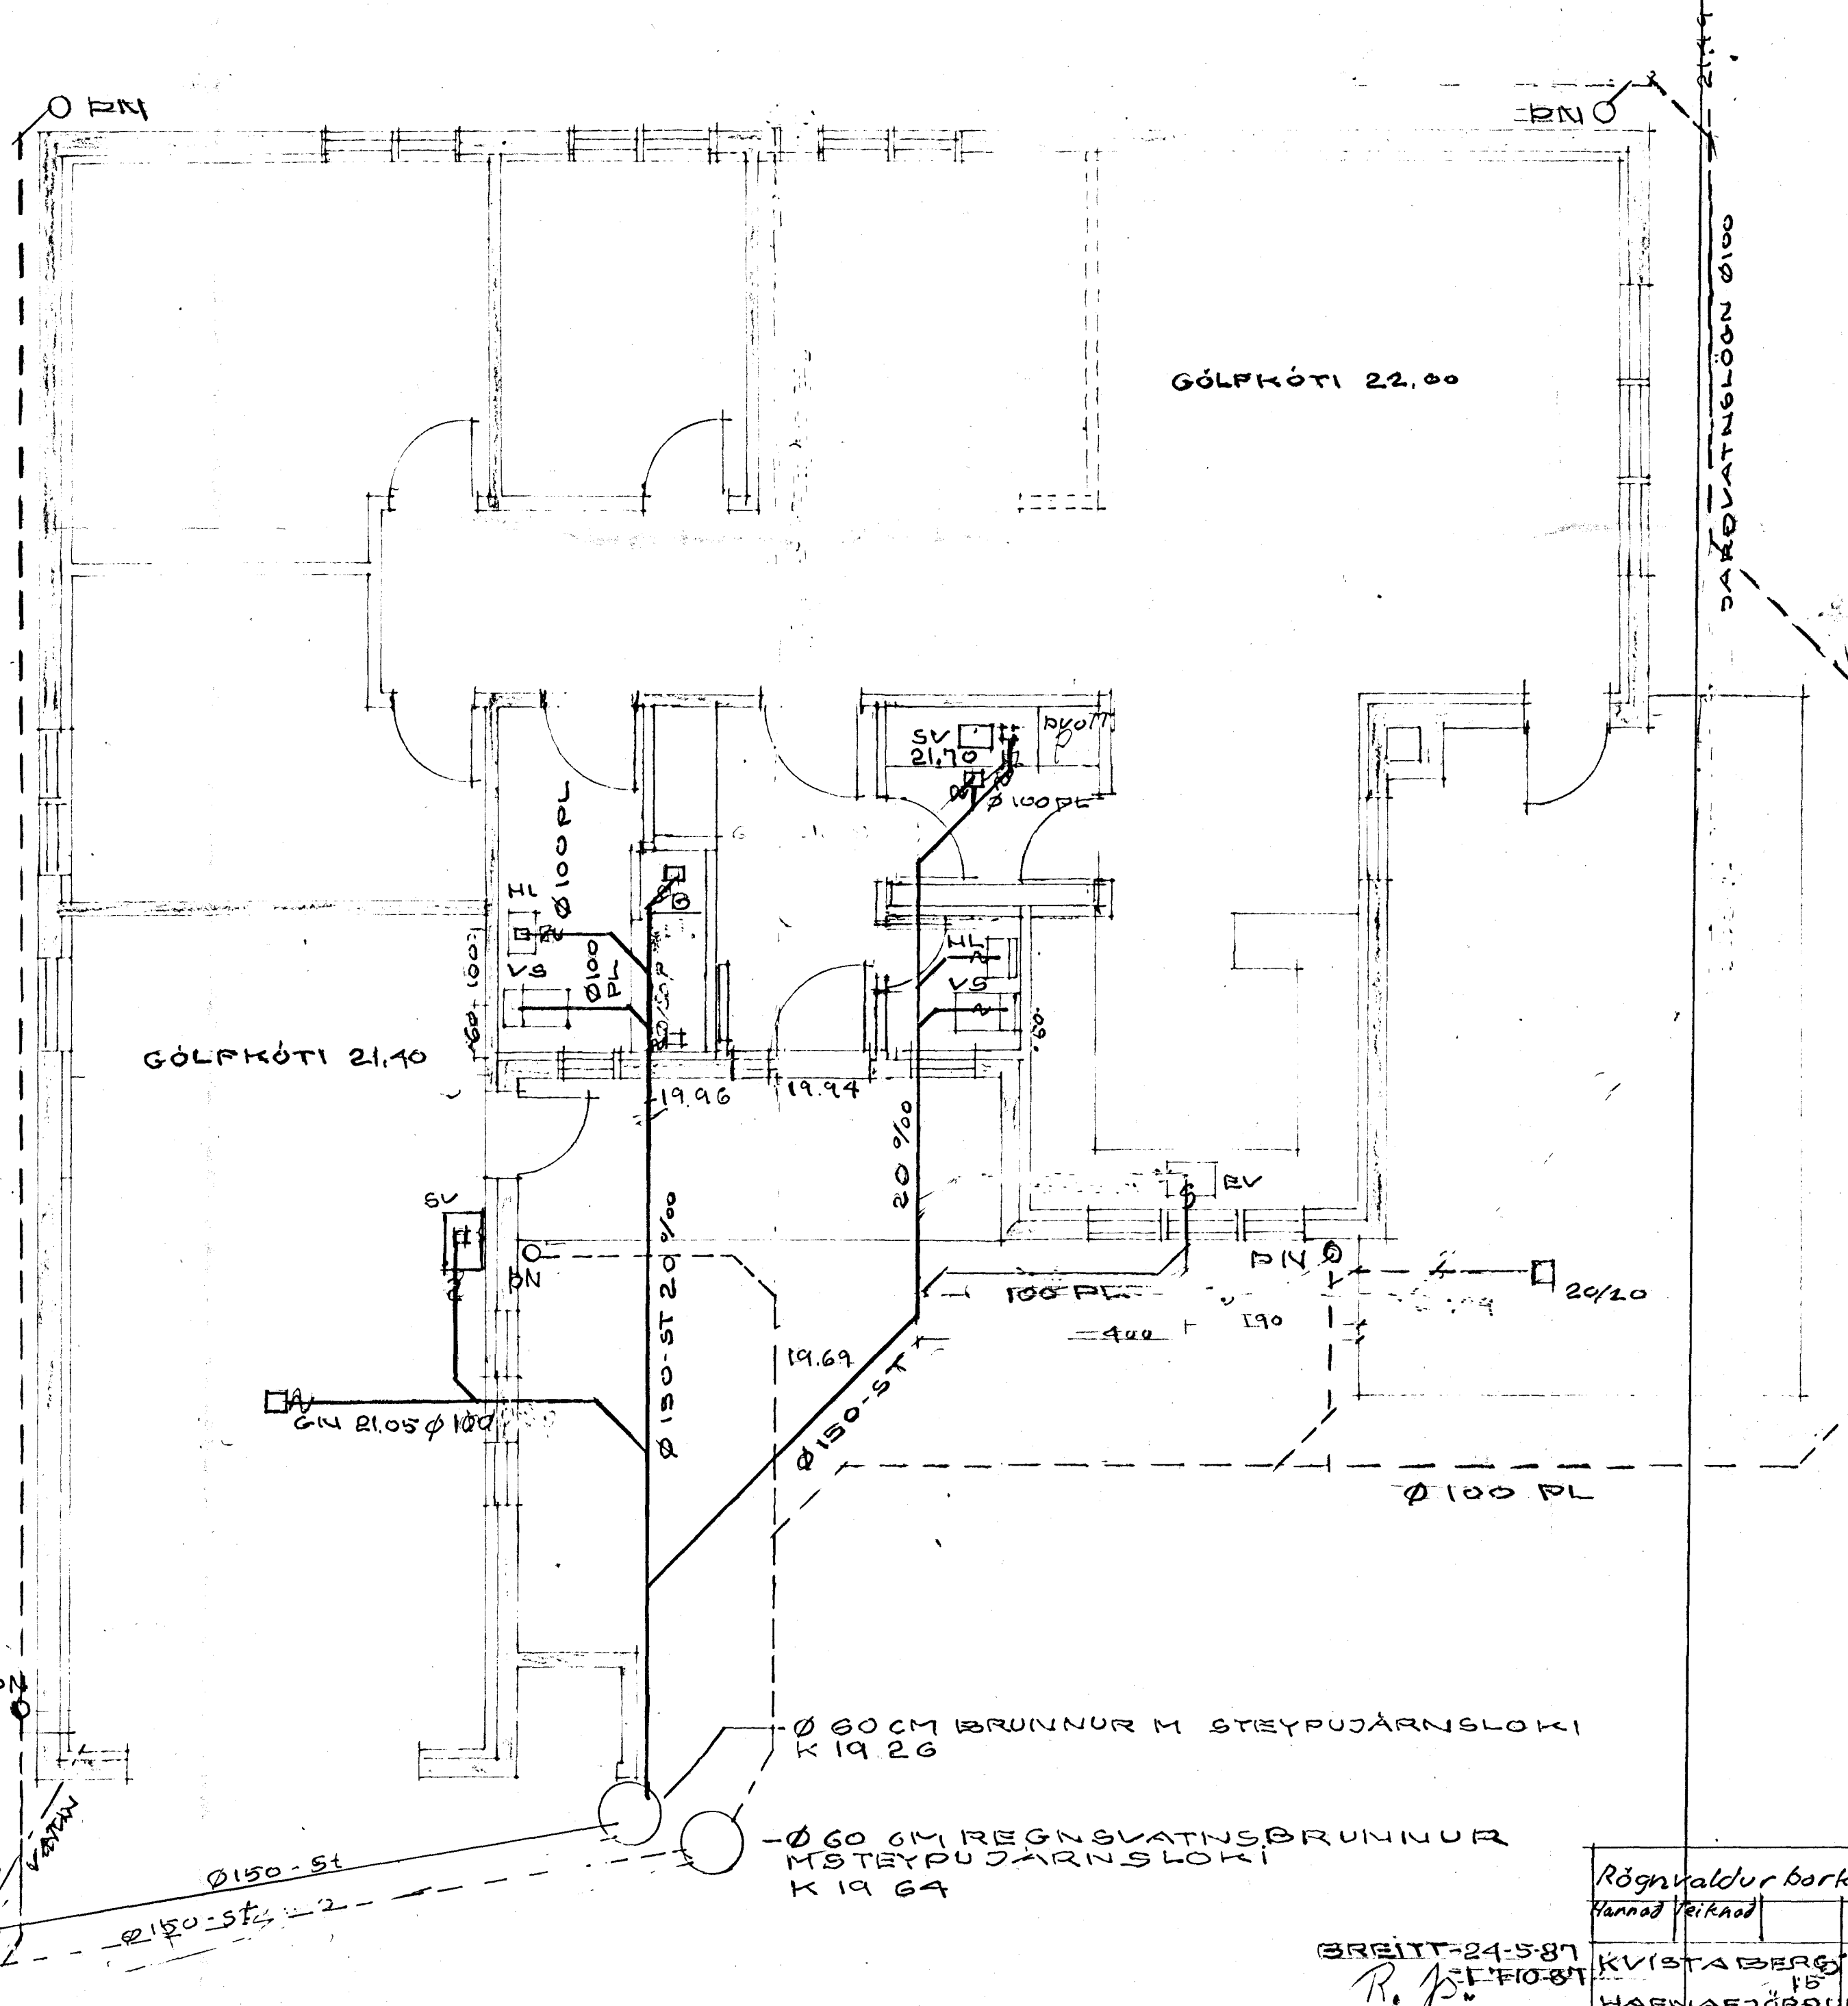

Rögnvaldur Þorkelsson, verkfr. Eikjuvogi 23 - Sími 96-32575				
Hannað	Teiknað	Rögnvaldur Þorkelsson	1:50	1-11-86
HAFNAFJÖRÐUR			Verk nr. 1228	
			Teikn. nr 201	

BREITT-24-5-87  
R. Þ.