


RUMMYND 1:50

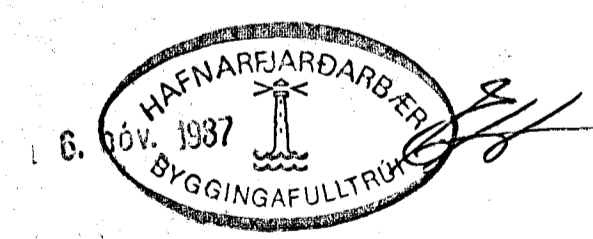

DI	5.11.87	SKV. LÖGN PÍPULM.	
DR.NR.	DAGS	EDLI BREVINGAR	SIGN.
		KVISTABERG 17 HAFNARFIRÐI	DAGS AÚST' 87
		RUMMYND HITLAGNA	HANNA
		MELKV. 11:50	TEIKNAD
		SIGURÐUR ÞORLEIFSSON TEKNIFRÆÐINGUR F.T.F.I.	VERK NR. 8712
		STRANDGÖTU 11 HAFNARFIRÐI SÍMI 54751	BLAÐNR. 2-04