


GRUNNMYND 1:50

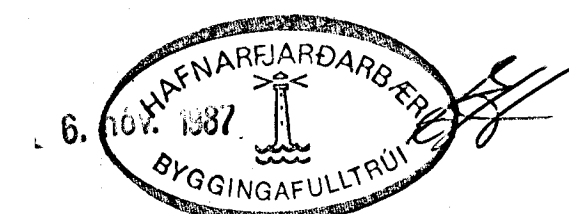

DI	5.11.57	BR. SKV. LÖGN PÍPUL.M.	
BR.NR.	DAGS.	EDLI BREVTINGAR	SIGN.
		KVISTABERG 17 HAFNARFJARDI	DAGS. ADST '37
		GRUNNMYND HITA OG VATNSLAGNA.	HANNAÐ
		MÆLIKV. 1:50	TEIKNAD
		SIGURÐUR ÞORLEIFSSON TEKNIFRÆÐINGUR F.T.F.I.	VERK NR. 8712
		STRANDGÖTU 11 HAFNARFJARDI SÍMI 54751	BLAD NR. 2-03