


20/ 88 4474 D 5/1

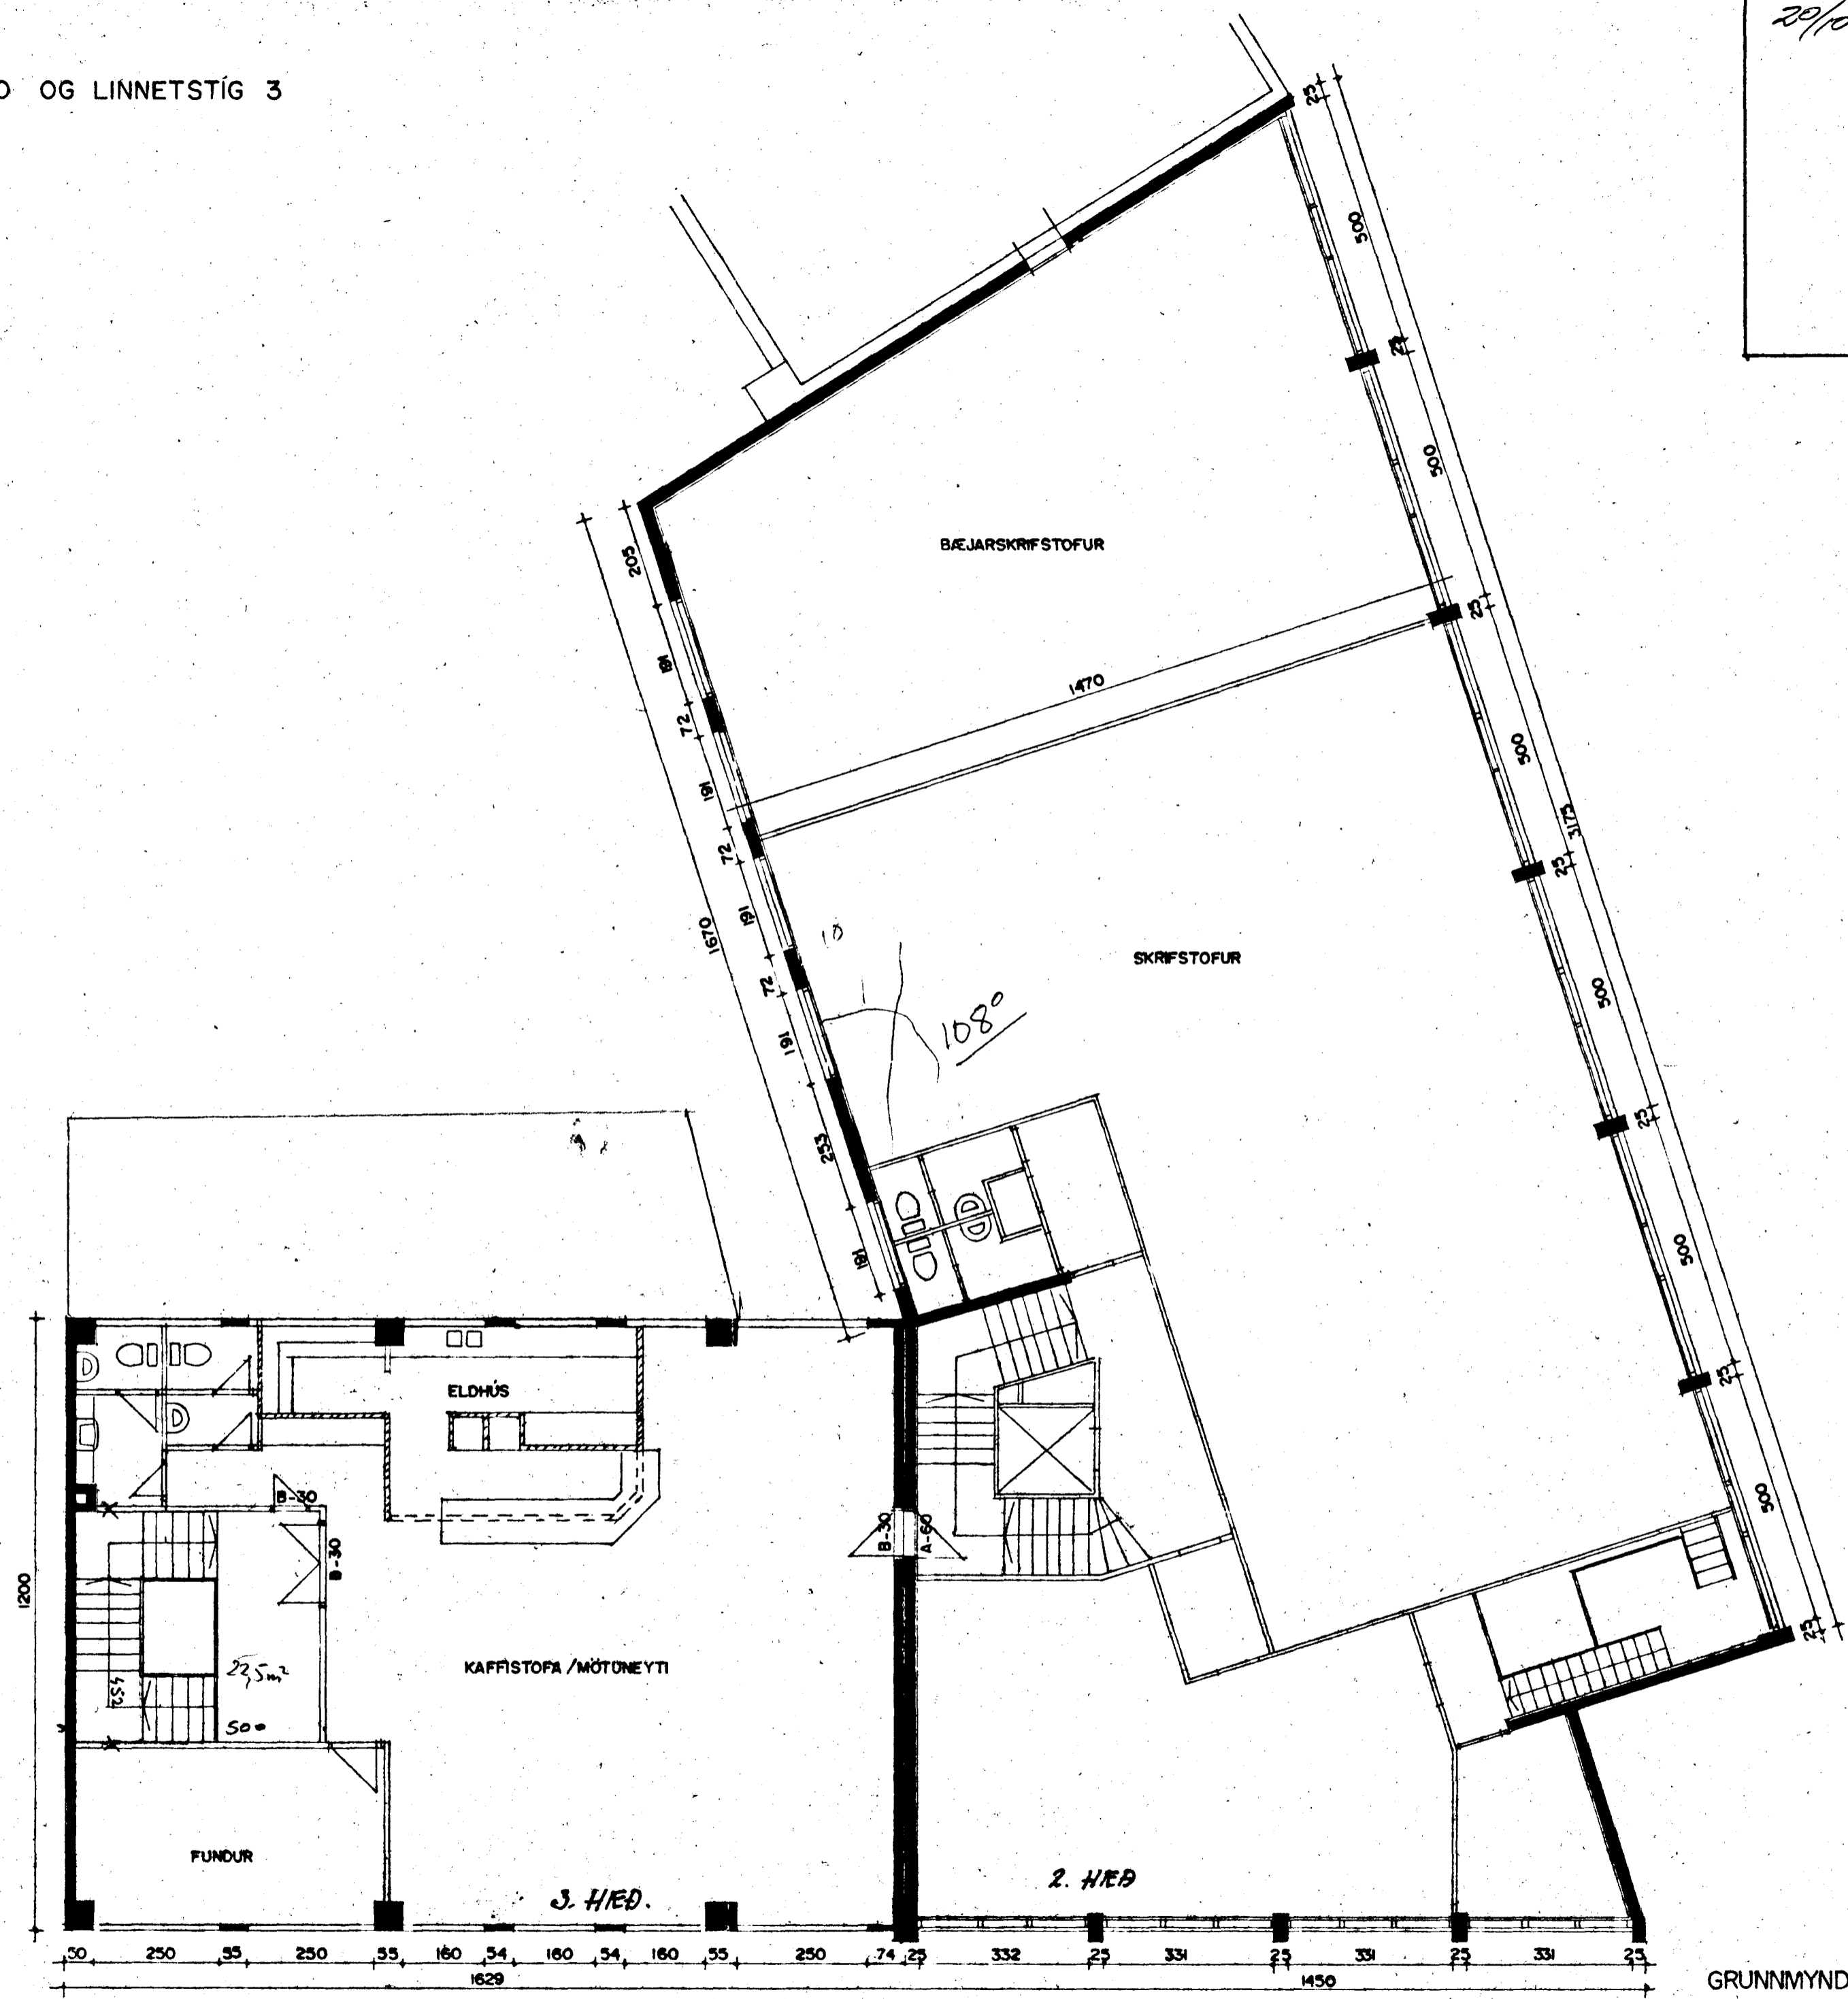

GRUNNMYND M:100.

*Handwritten signature*