
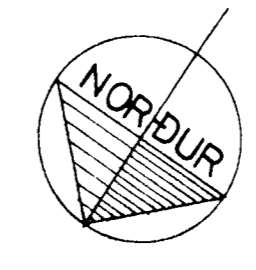


Undirritotar samþykkir uppdráttina

Nafn	Kt.	Stödur
Valdís Þorvaldsdóttir	180851-4459	Lækjarhvammur 14
Dagbjart Lóa Sveinólfsson	021274-4539	Lækjarhvammur 8
Ólafur Ragnsson	310142-2209	Lækjarhvammur 6
Róbert Gunnarsson	270466-5374	Lækjarhvammur 4
Ólafur Gunnarsson	160555-5558	Lækjarhvammur 2
Halla Ólafía Ólafsdóttir	240953-4809	Lækjarhvammur 16
Þjófkjör Pétursdóttir	200762-2909	Lækjarhvammur 18
14. Sigrún Ólafsson	270260-7219	Lækjarhvammur 20
Ólafur H. Ólafsson	150440-4859	Lækjarhvammur 22
Sigrún Ólafsson	091248-2639	Lækjarhvammur 10

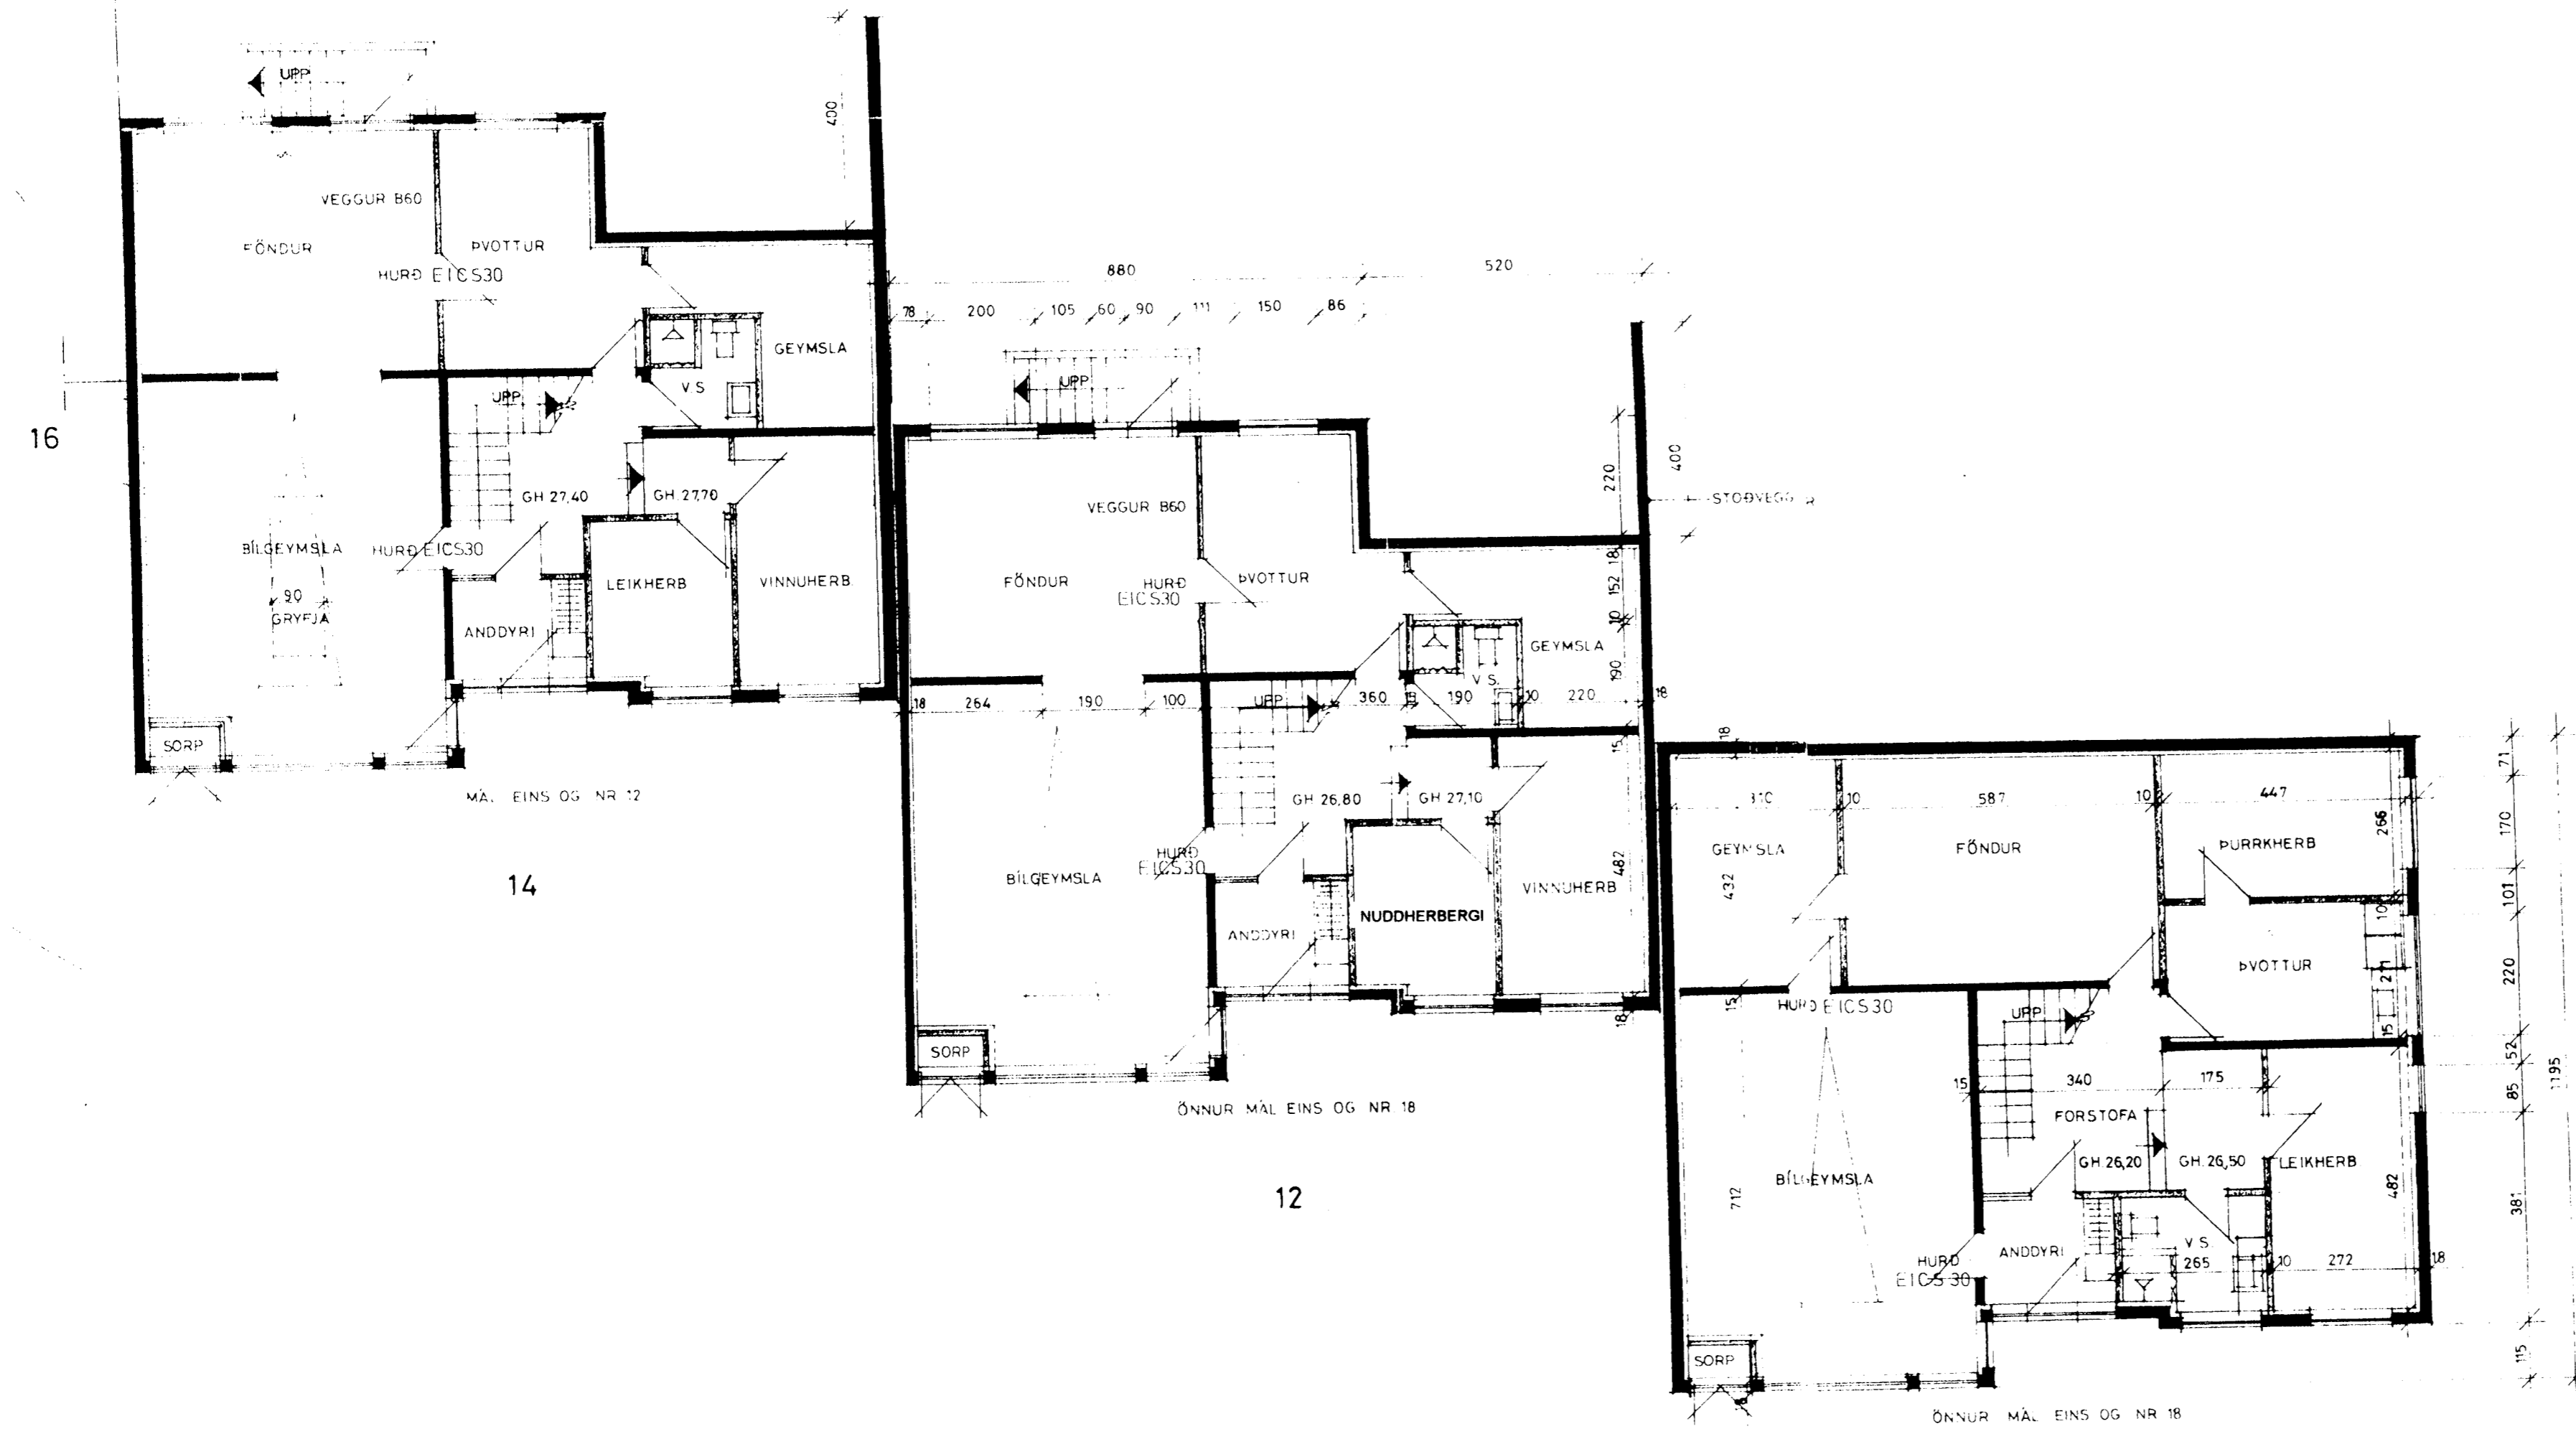

LEIKHERBERGI BREYTT Í NUÐDHERBERGI 31. MAÍ 2003

LÆKJARHVAMMUR 12, HAFNARFIRÐI
 RADHÚS 50.01

TEIKNISTOFAN ÞRÚÐVANGUR PÁLL V. BJARNASON, FAÍ
 Hönnun - Ráðgjöf - Endurbýggingar kt. 060346-2249

GRUNNMYND JARÐHÆÐAR LAUFÁSVEGUR 7 101 REYKJAVÍK
 Sími: 561-0280 FAX: 561-0285
 bláð 2 af 5 HANNAÐ: PVB TEIKNÁÐ: PVB DAGS: 29.05.03 MKV: 1:100

breytt 20.09'02 kj

O.K. Arkitektar ehf.	Nýbýlavegi 22
Lækjarhvammur 16	kt. 700402-6140
grunnmynd neðri hæð	hannað Kristín Jónsdóttir
dags 17.07.2002	sk. 1:100
	nr. 4