




súðvestur

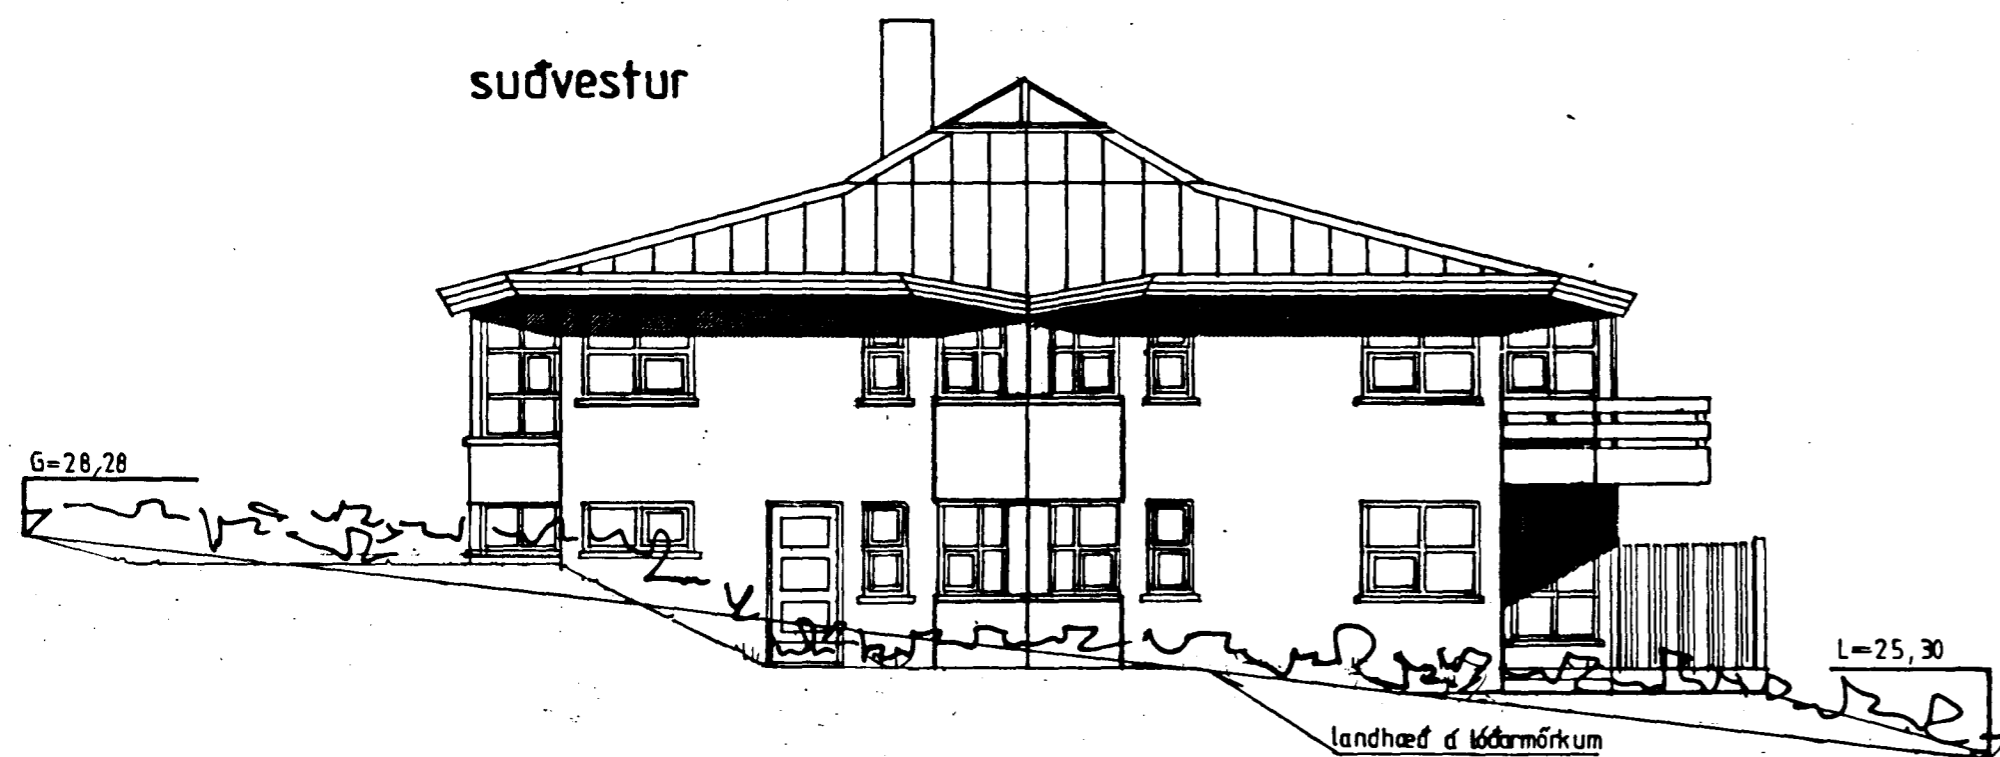

nordvestur

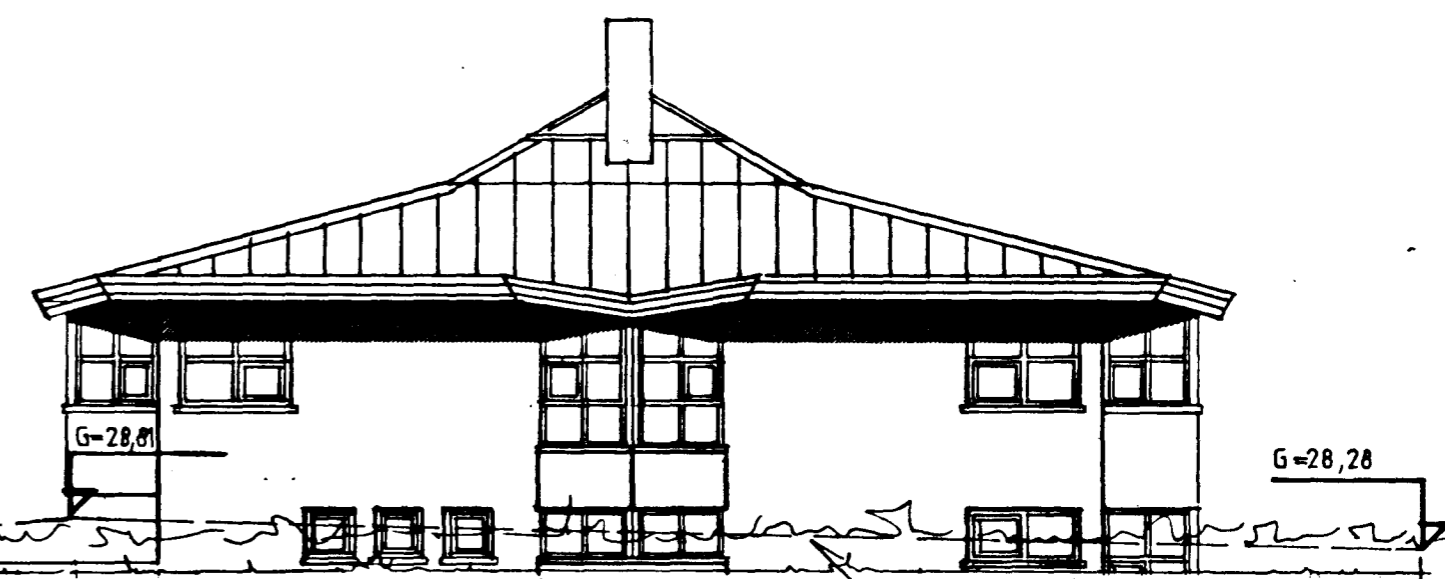

nordaustur

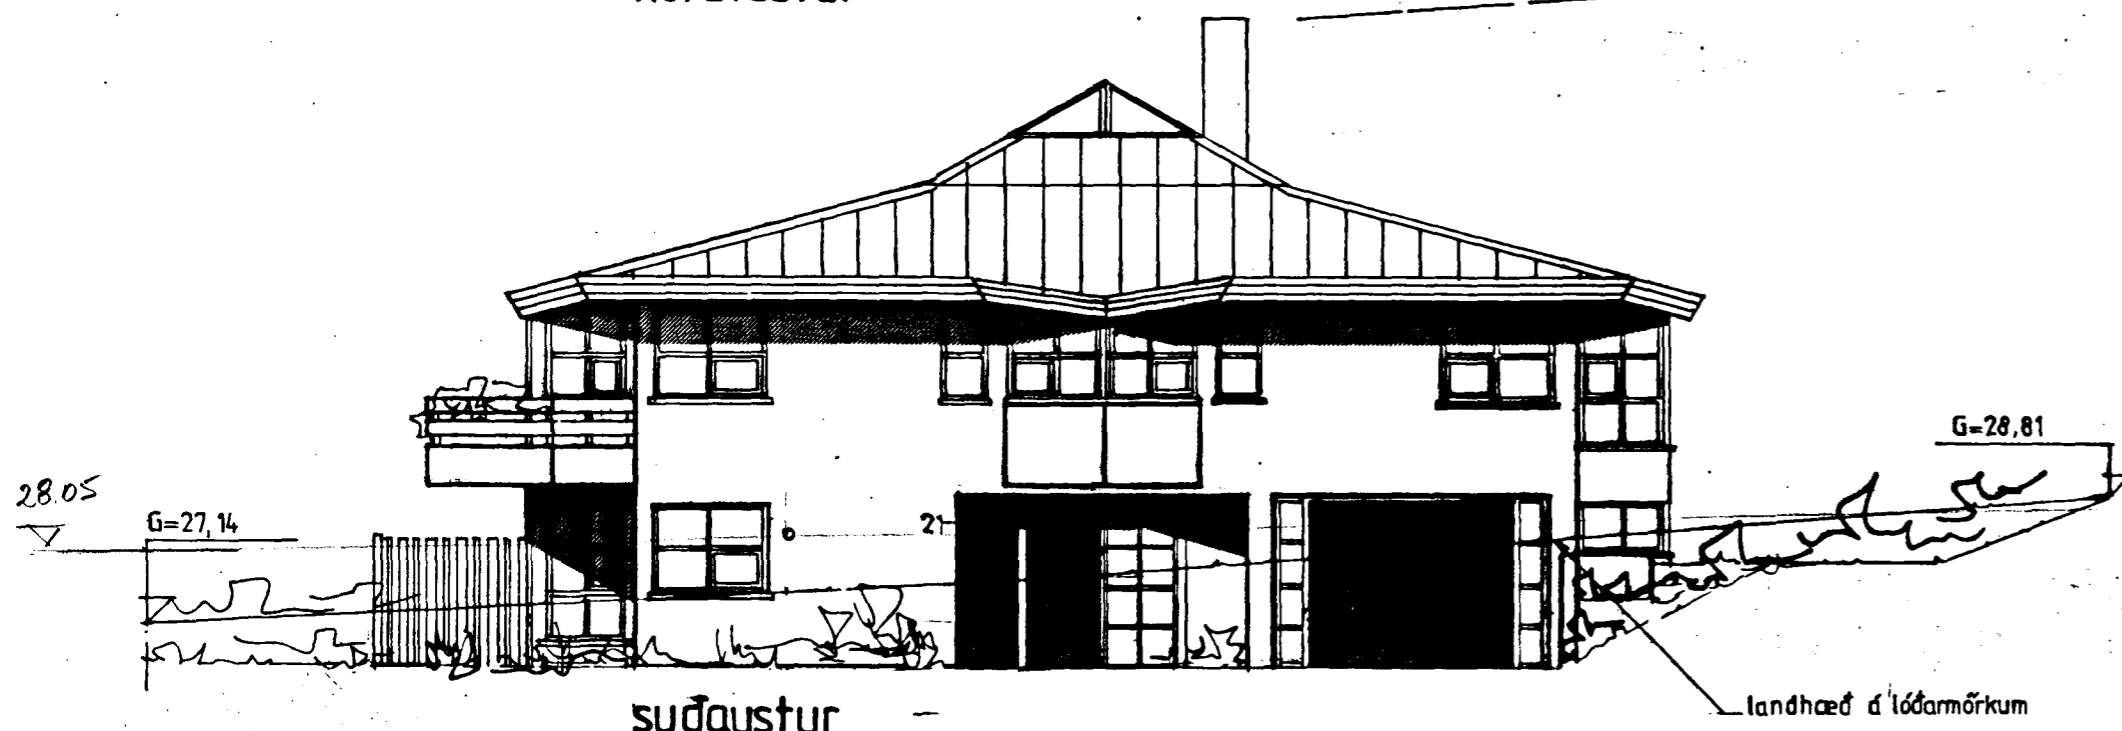

súðaustur

LÆKJARBERG 21, HAFNARFIRÐI.

BR. ÁG. 1990 JP/SS GÓLFKÓTI SEPT. 90 GLUGGAR BÍLG.+PV JP/SS

JÚNÍ 1990 ÚTLIT M. 1:100

JÓHANNES PÉTURSSON FTFI 46221 675107

SIGURÐUR SIGURÐSSON 666613

S+S

