
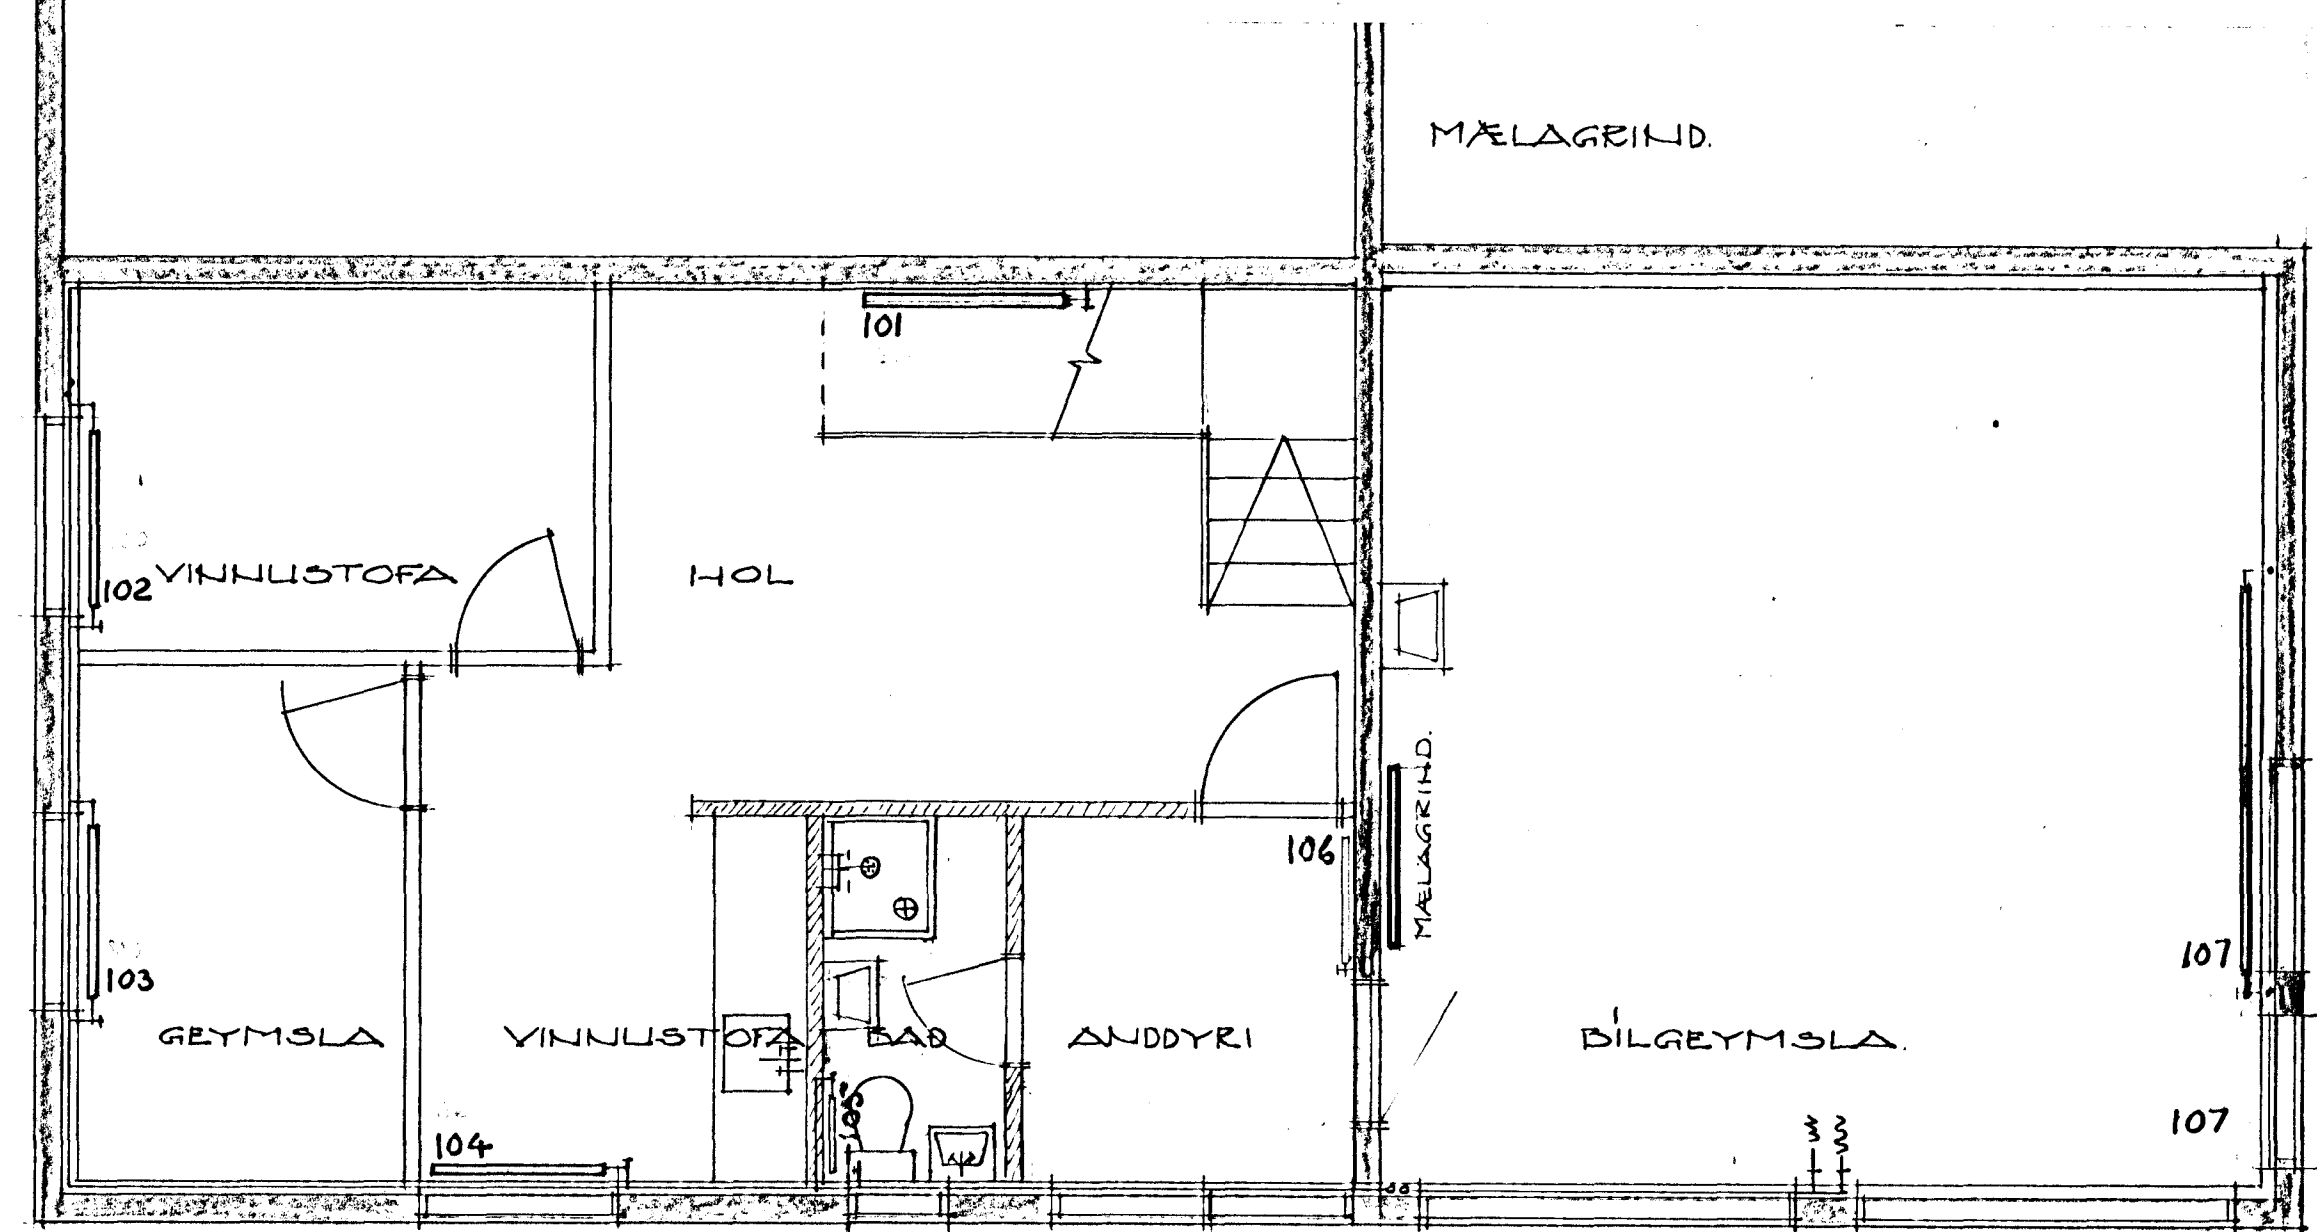
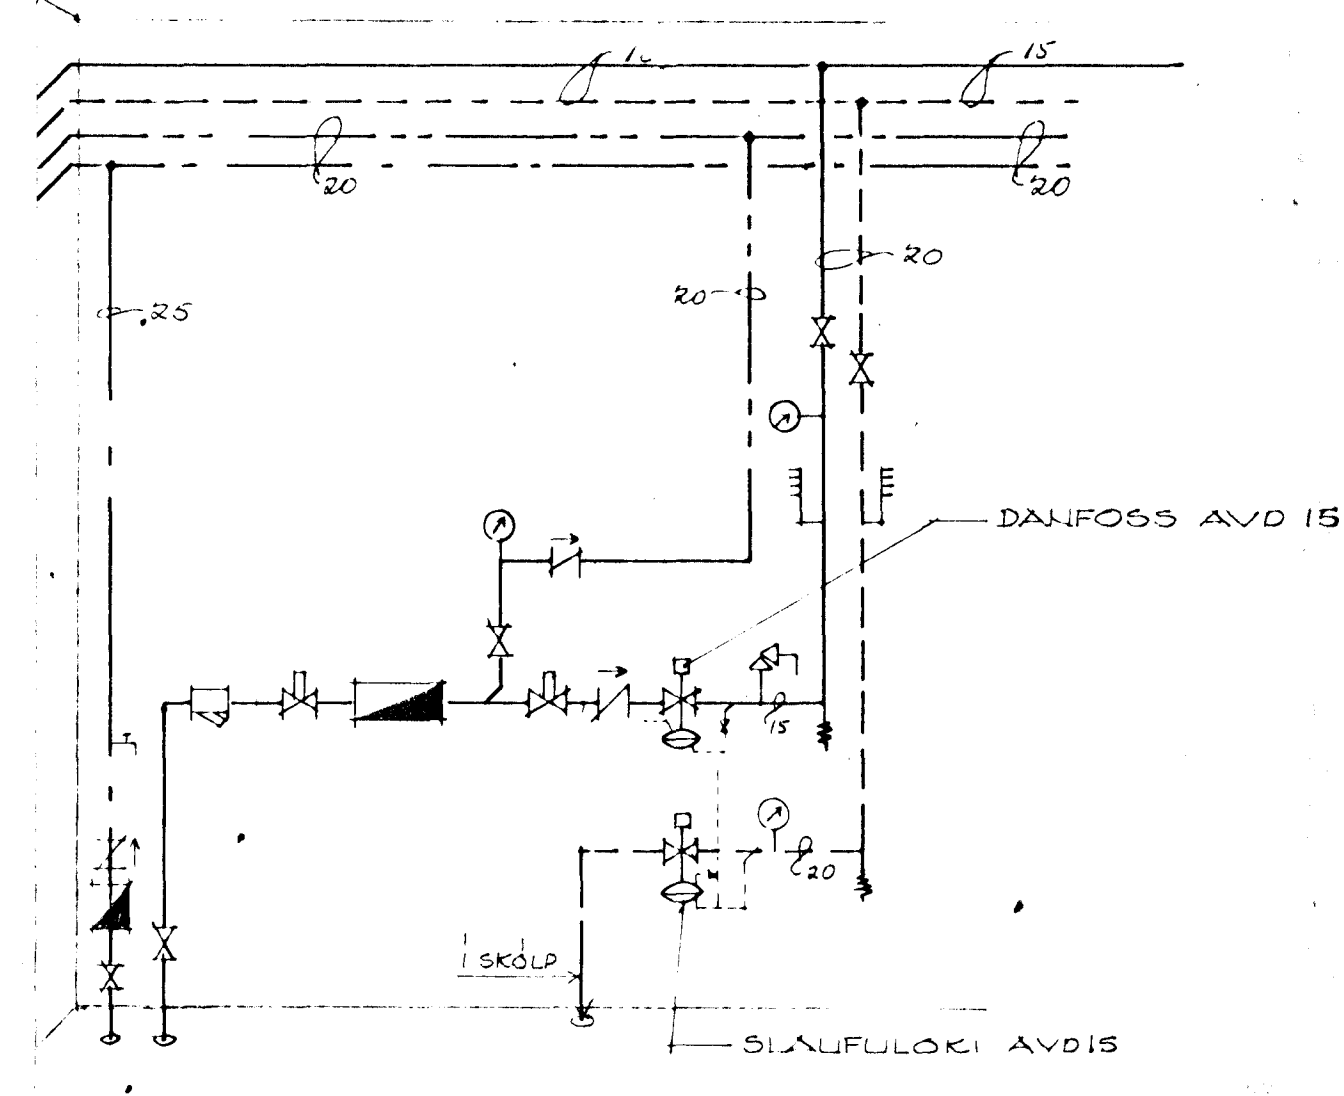


OFN NR.	KCAL ORCLDÖRF	VALINN OFN.		
101	1600			
102	700			
103	800			
104	600			
105	400			
106	700			
107	2000			
201	1300			
202	900			
204	1000			
205	600			
206	1300			
207	1000			
208	1000			
209	500			
210	1000			
211	900			
212	900			
213	1600			
214	1300			

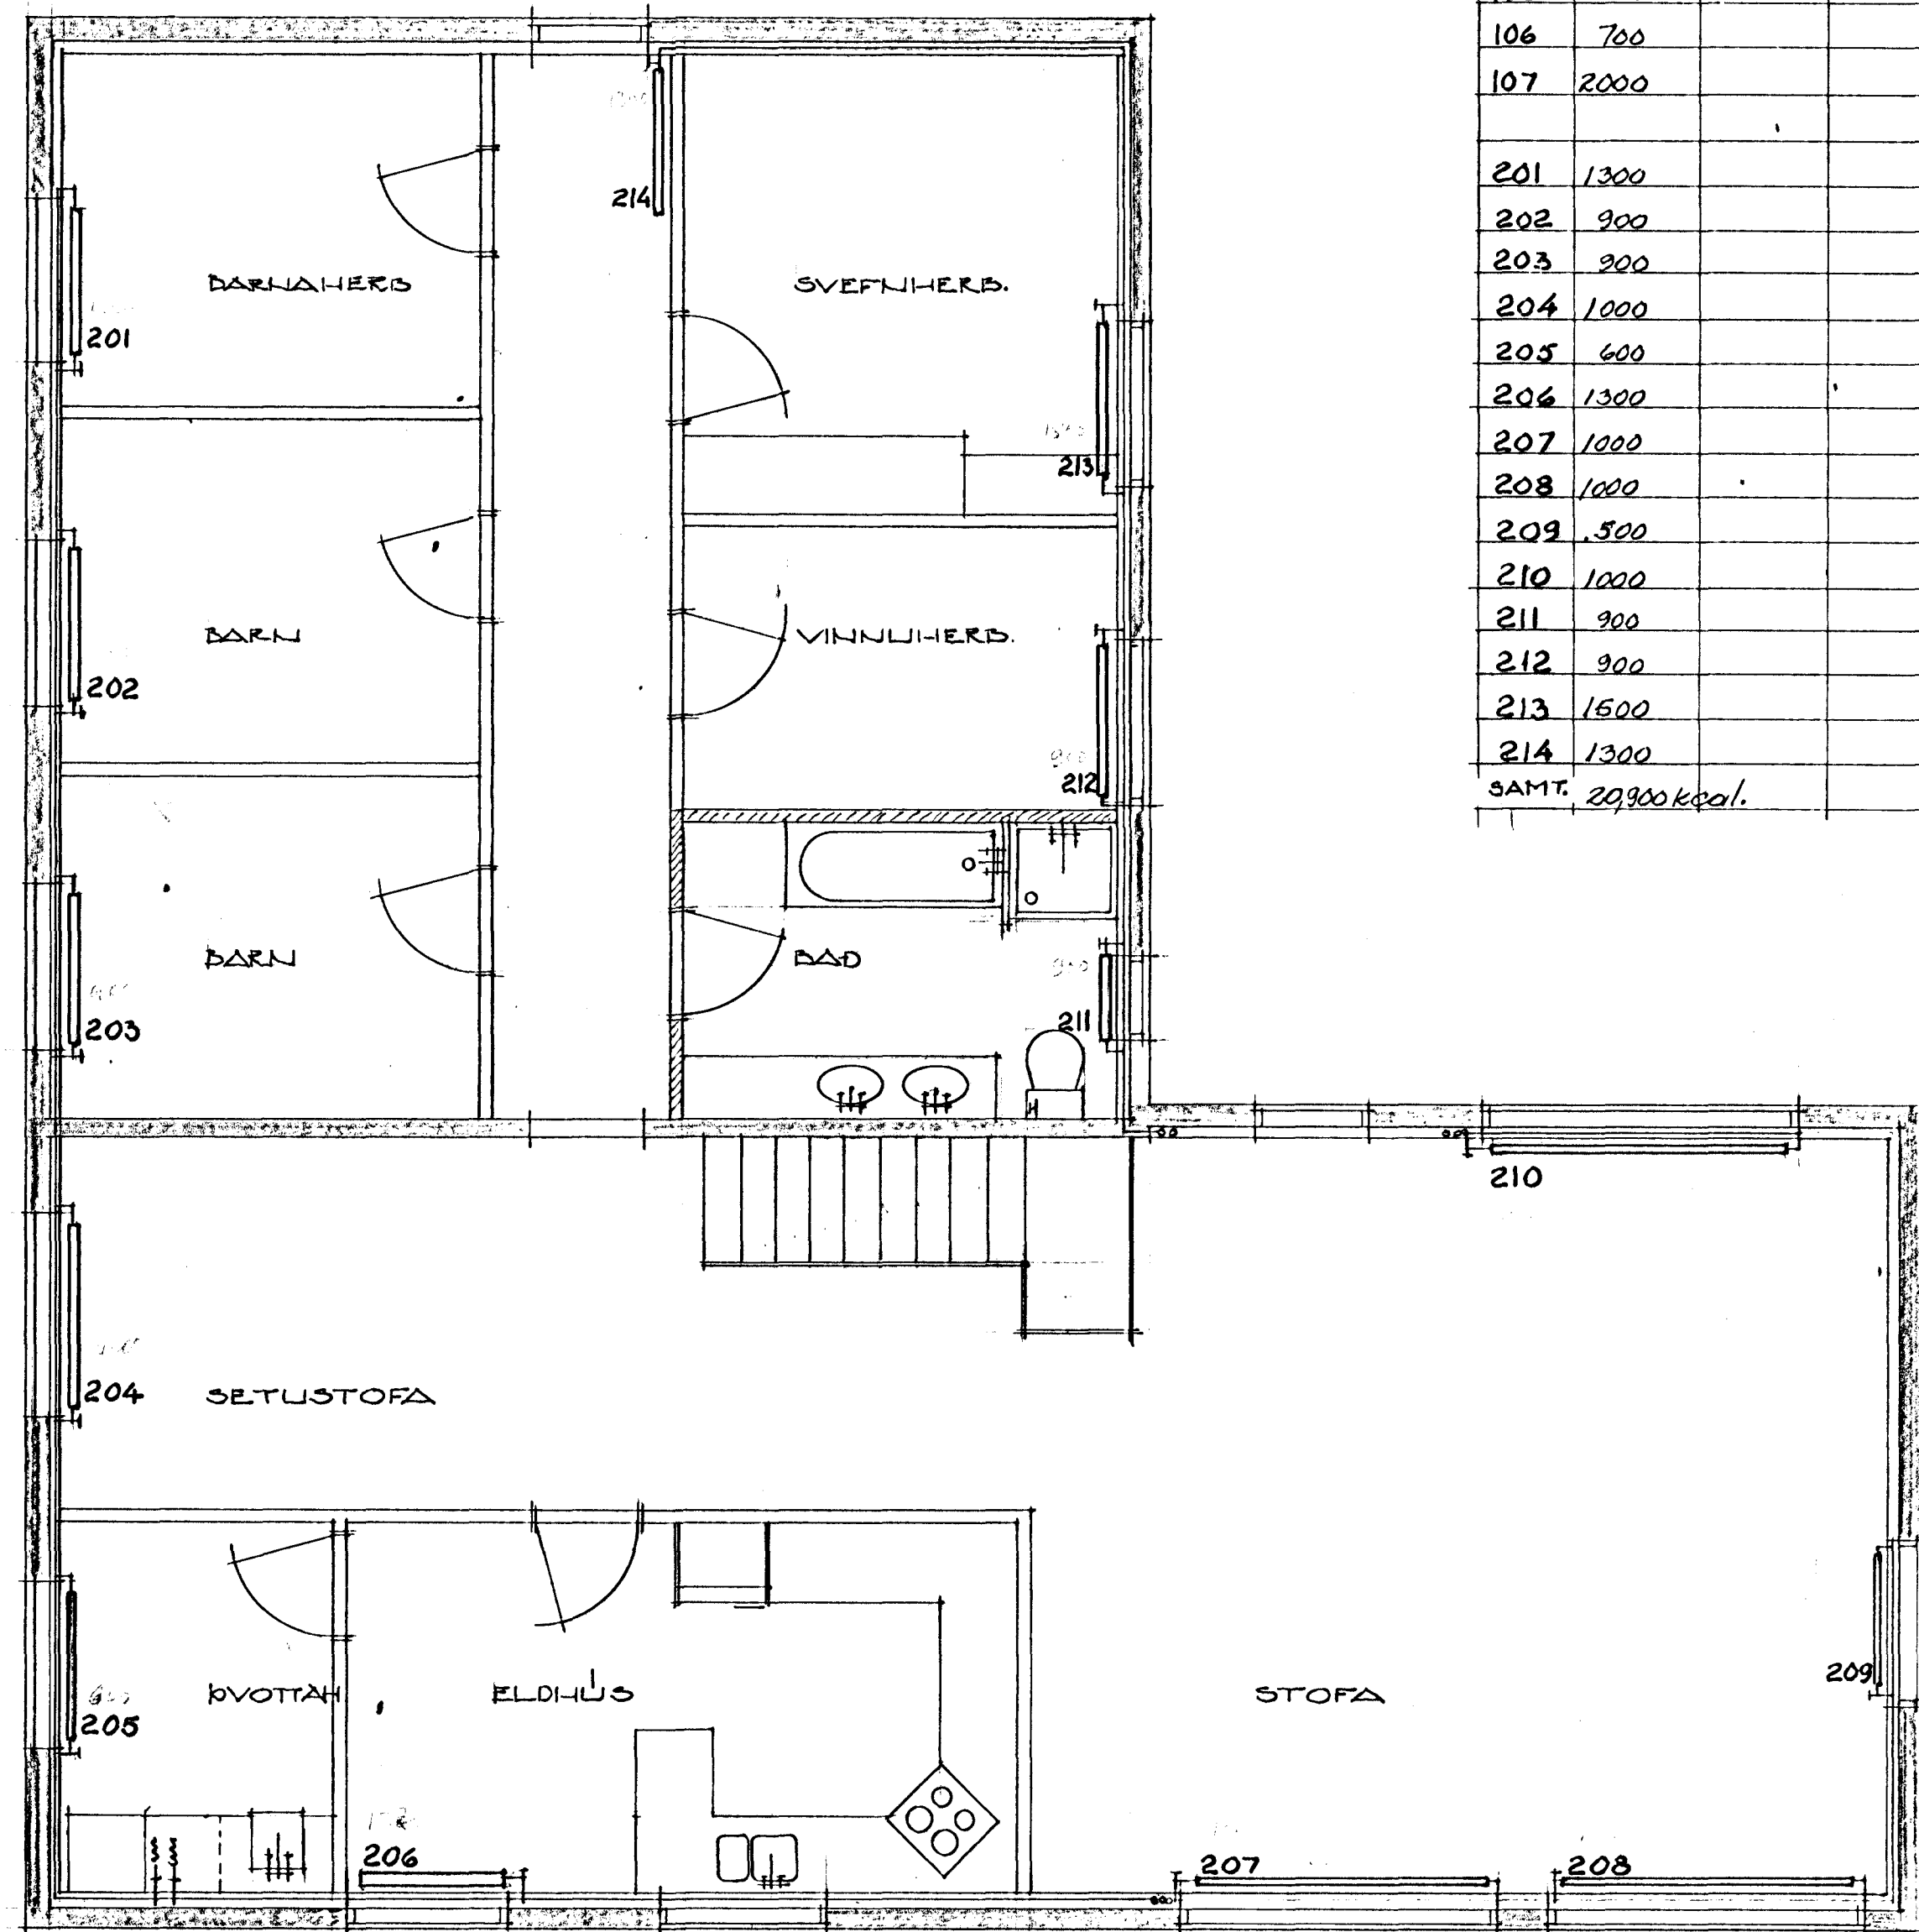

Breyting 16.07.1990.

MÆLAGRIND FÆRÐ, OFNAR 105 OG 106 FÆRÐIR. JAN 190 1990

BREYTING DAGS. GERT AF

LÆKJARBERG 4 HAEFNARFIRDJ

ARMANN JÓHANNESSON
BYGGINGAVERKFRÆÐINGUR
BALDVIN EINARSSON
BYGGINGAFRÆÐINGUR

HITAL OG VATNSLAGNIR

reikn. yfir t. mkr. 1:50
teikn. 1:50 samþ. daga. FEIS '89 verk nr. blað af.