
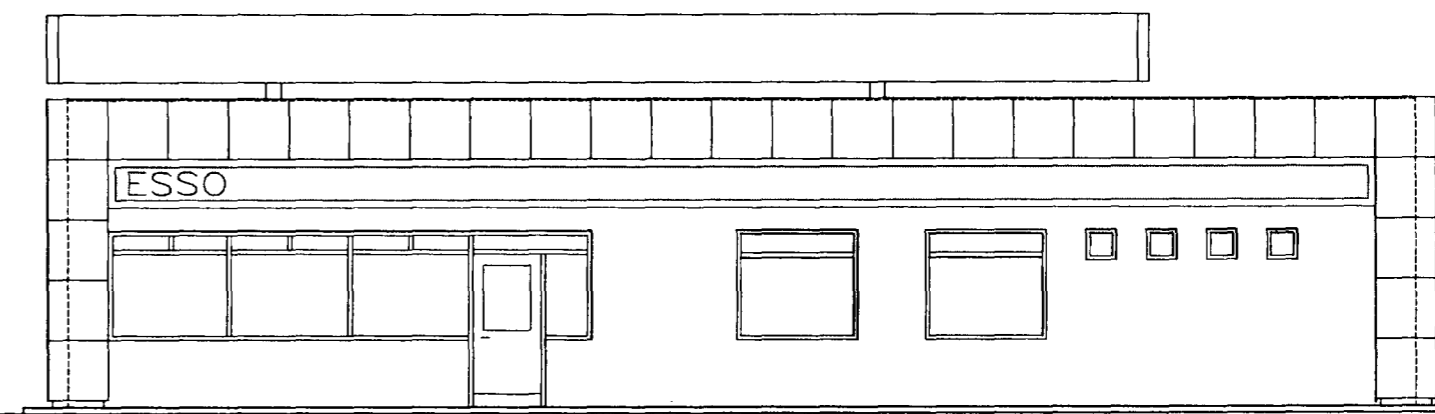




Úr Gildi

SUDURHLID

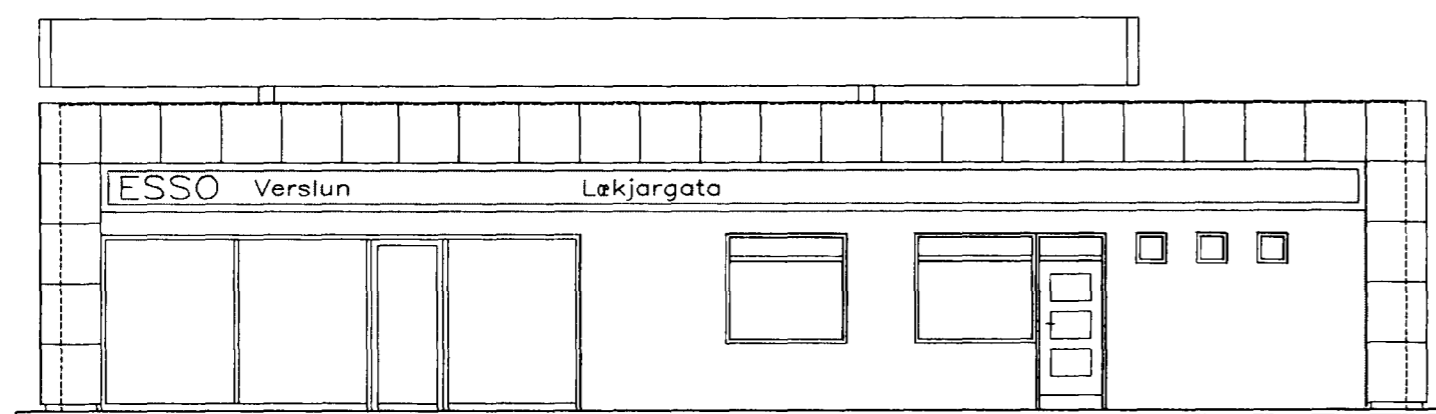


NORDURHLID

NORDURHLID FYRIR BREYTINGU

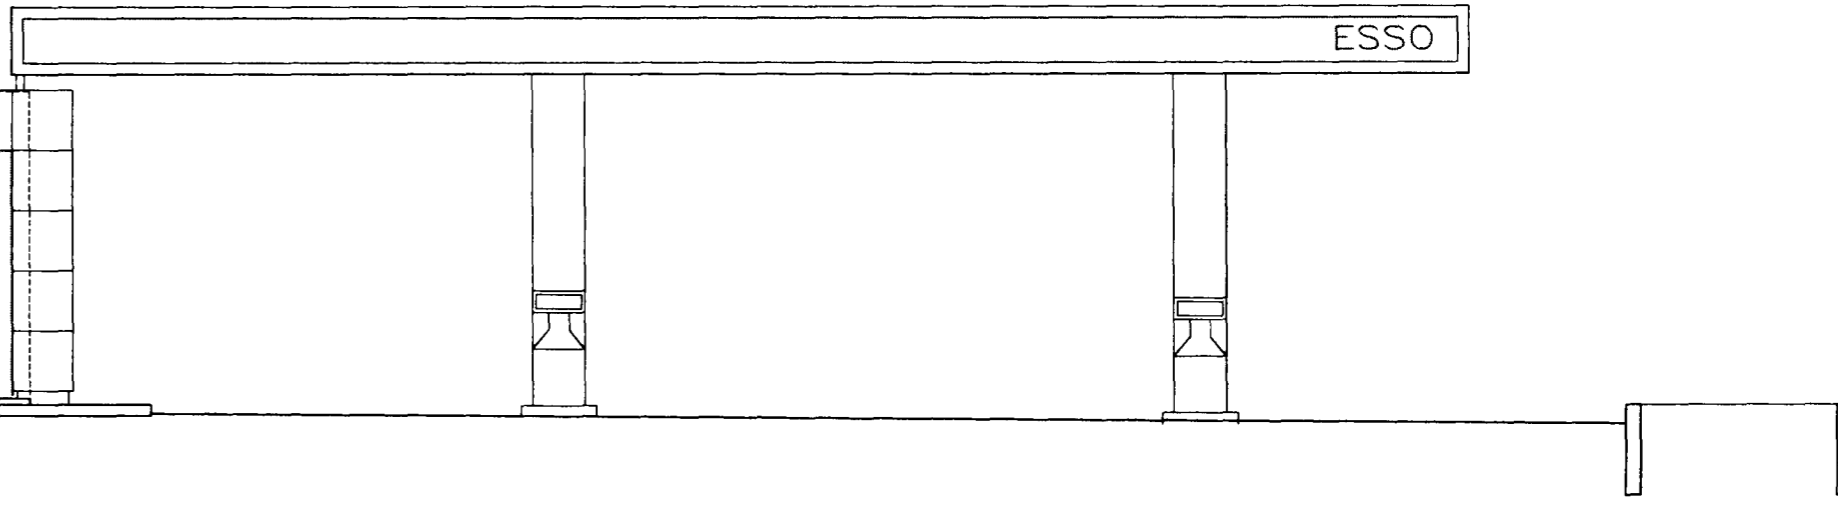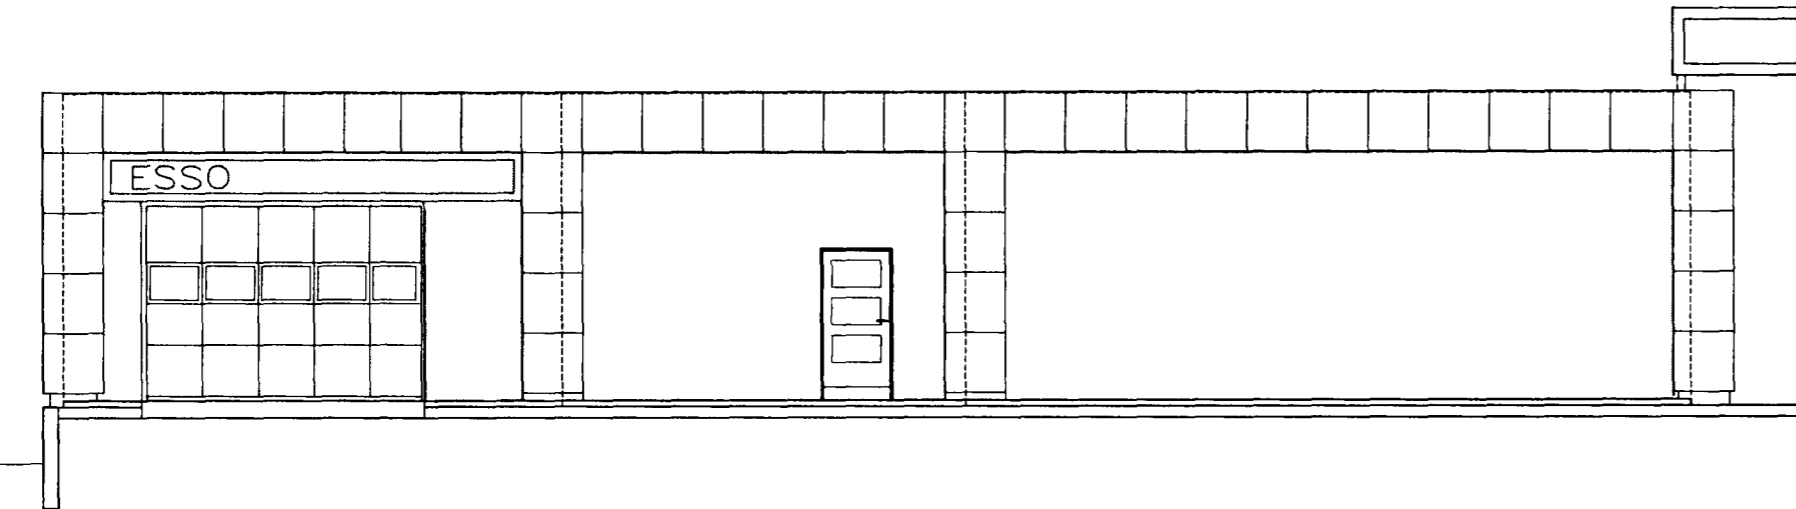

AUSTURHLID

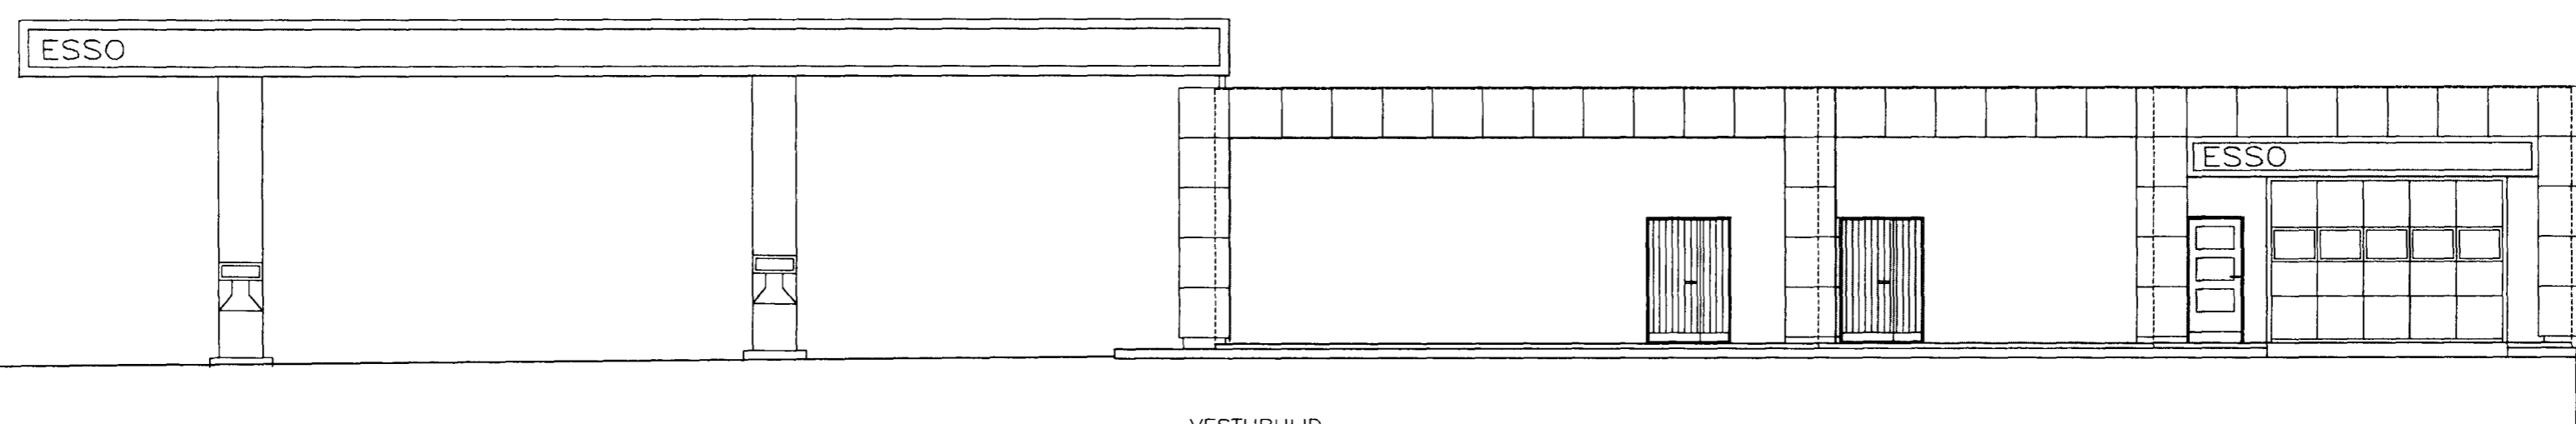

LÆKJARGATA

VESTURHLID