


NR 21

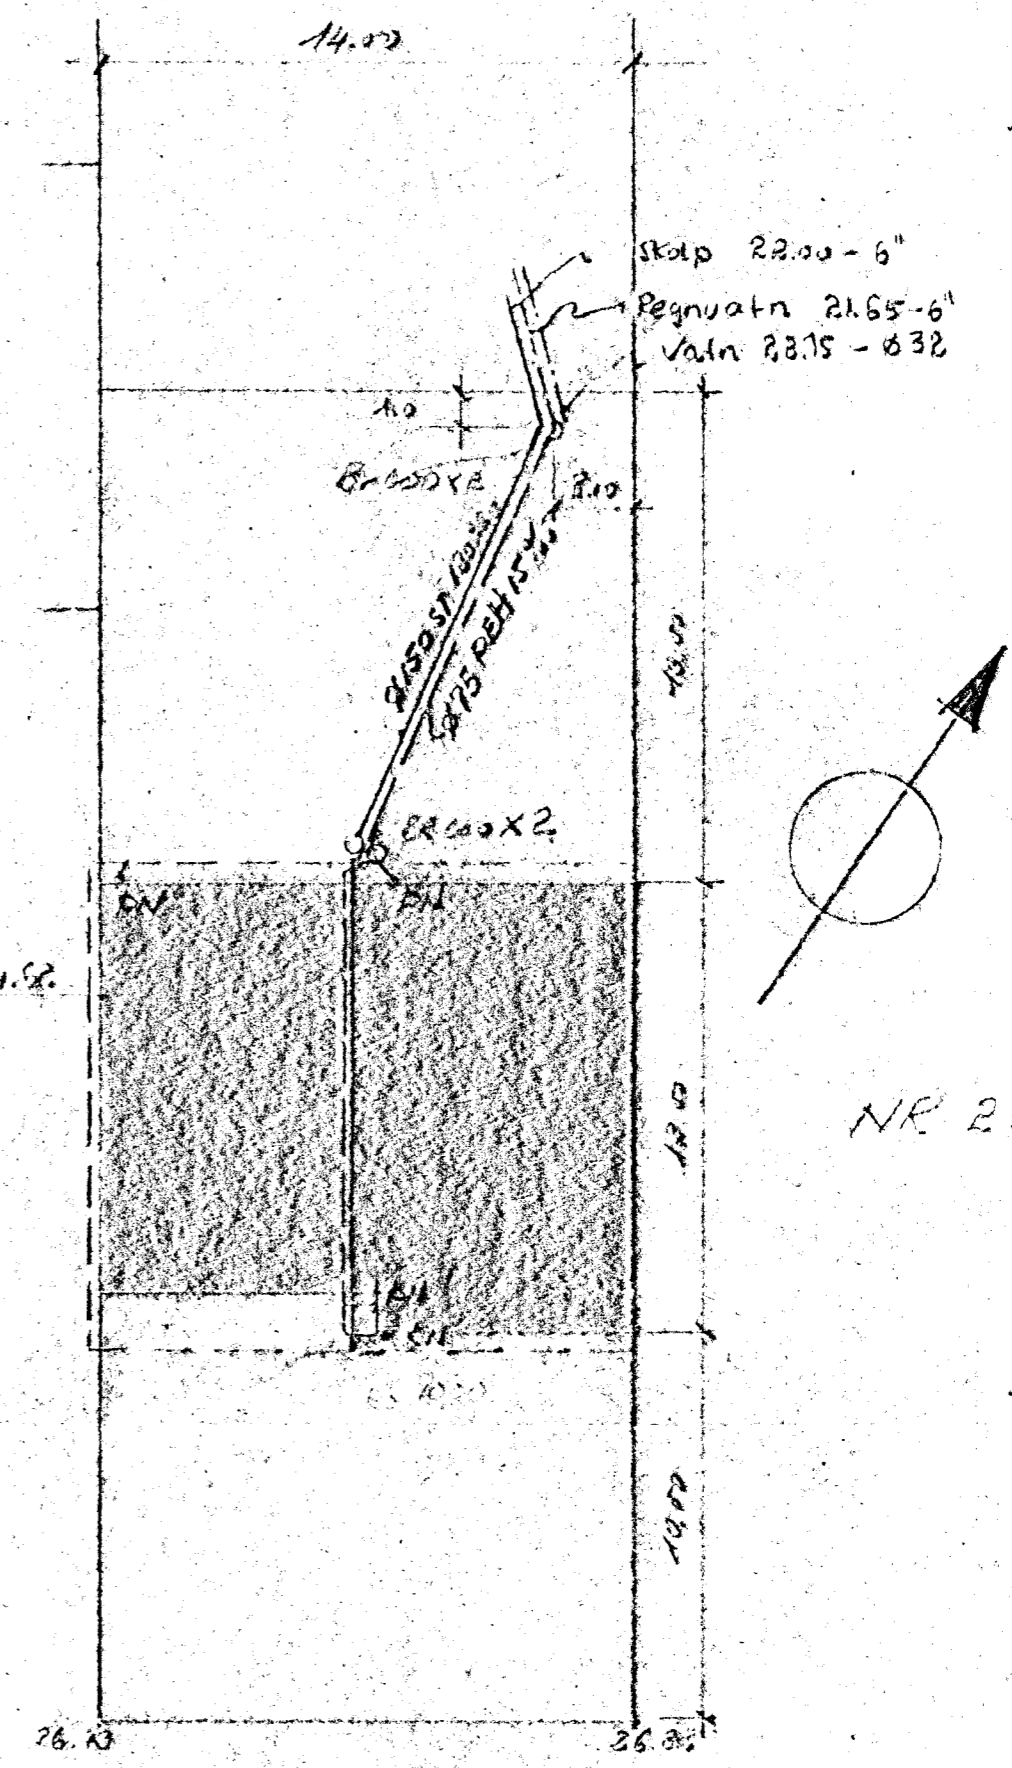

GATA  
 Afstæðamynd  
 MKV 1:200

NR 25

Mkv:1:50

BREYTT OKT '80	JJP	1
LÆKJARHVAIMUR 23		
HAENAREIRDI		
FRÆRERINSULISLAGNIR		
21.04	1. FEBR '80	
J. Jónsson		