



Samþykkt bann


07. MAÍ 2006

Byggingafulltrúinn í Hafnarfirði  
Erlendur Hjalmarsson

fl. G. Valskjöldsdóttur



AUSTURHLID

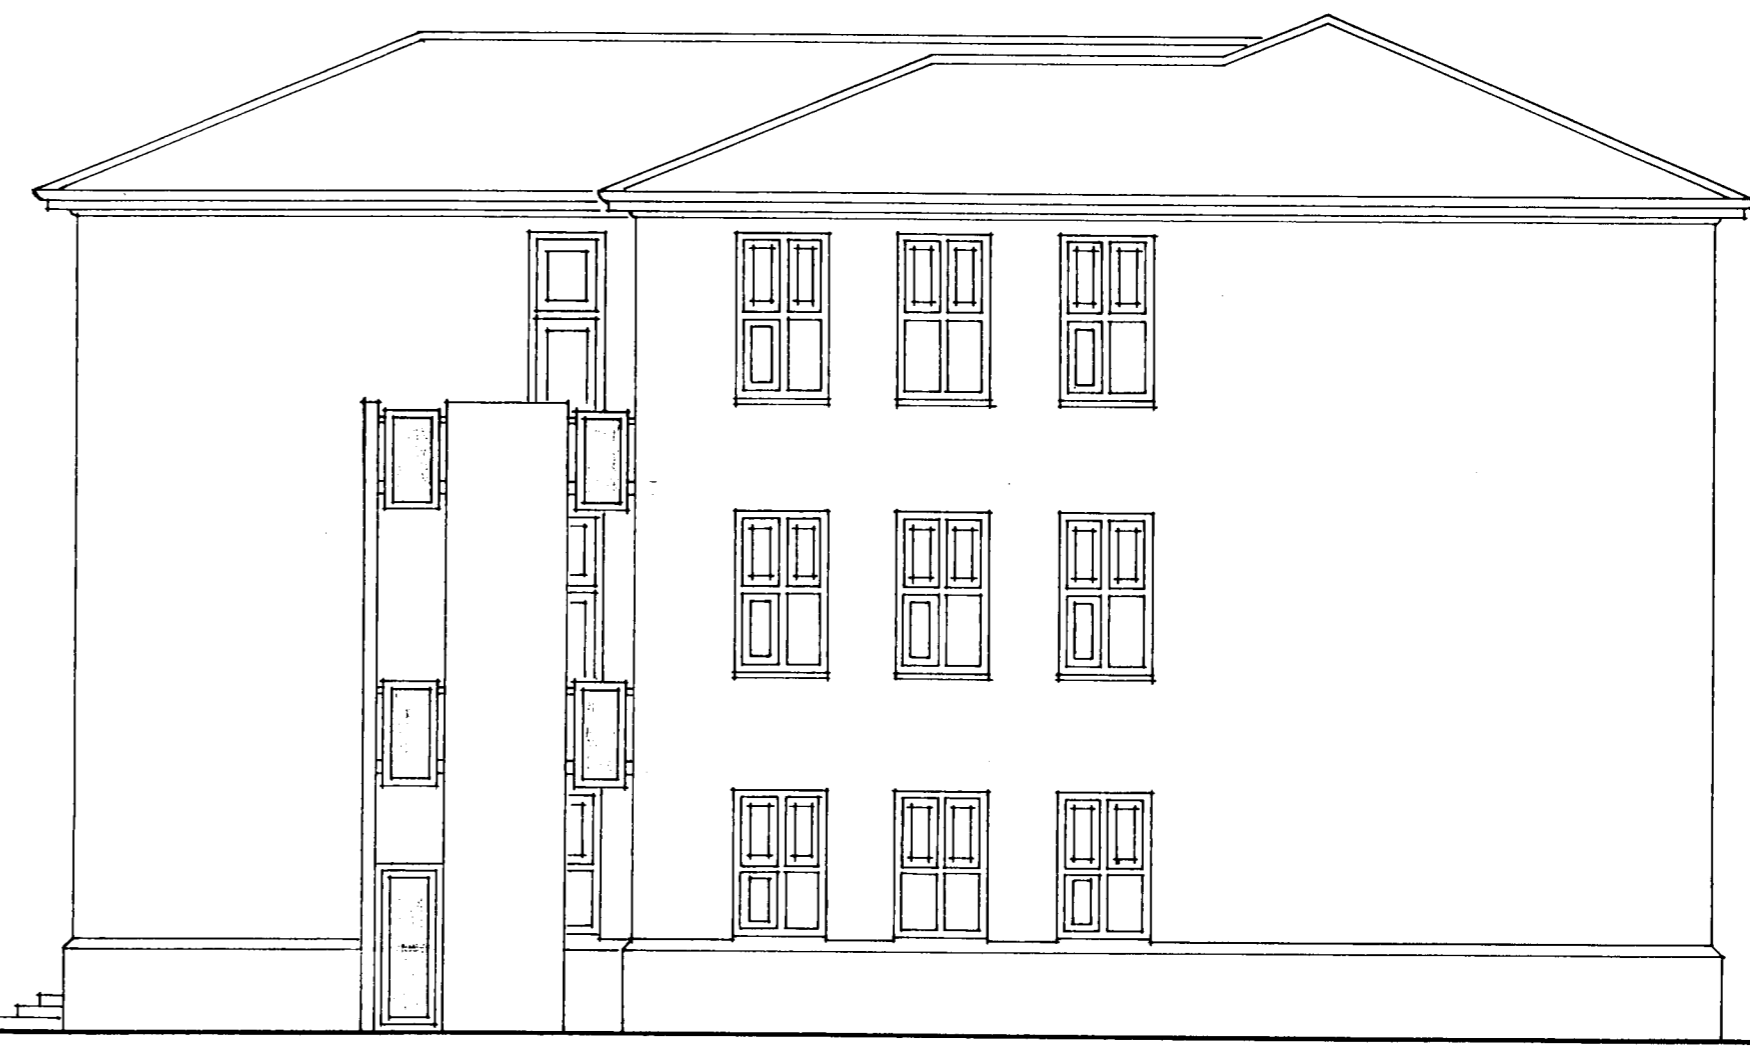

VESTURHLID

Breyting 20.07.99  
Björgunaropum bætt við.



KVARÐI : 1:100  
VERK NR : 236  
TEIKN.NR : 106

NAFN : LÆKJARSKÓLI HAFNARFIRÐI  
VERK : VIBBYGGING  
TEIKNING : ÚTLIT  
TEIKNAD : MARS 99 \$ BREYTT : 20. 07. 99 HR

*Ormar Þór Gunnarsson* *Órnólfur Hall*  
**ARKITEKTASTOFAN SF**  
ORMAR ÞÓR GUNNARSSON OG ÖRNÓLFUR HALL ARKITEKTAR F.A.Í.  
0202-4629 000  
SÍÐUMULA 23 REYKJAVÍK  
SÍMI 83655