


**LANGEYRARVEGUR 16 A**  
**HAFNARFIRÐI**




Samþykkt þann

19 AUG. 1999


Byggingafulltrúinn: Hamarríði Erlendur Hjálmarsson

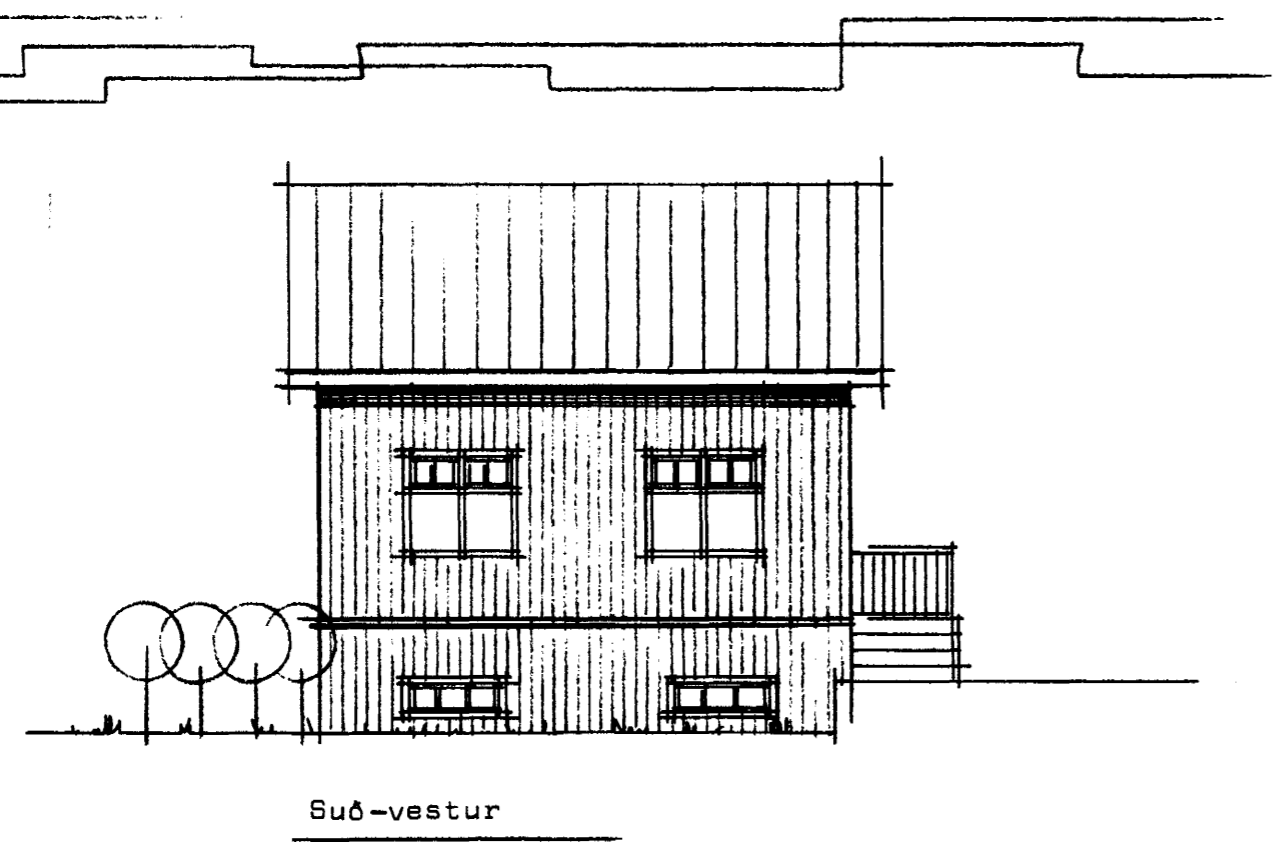


Suð-vestur

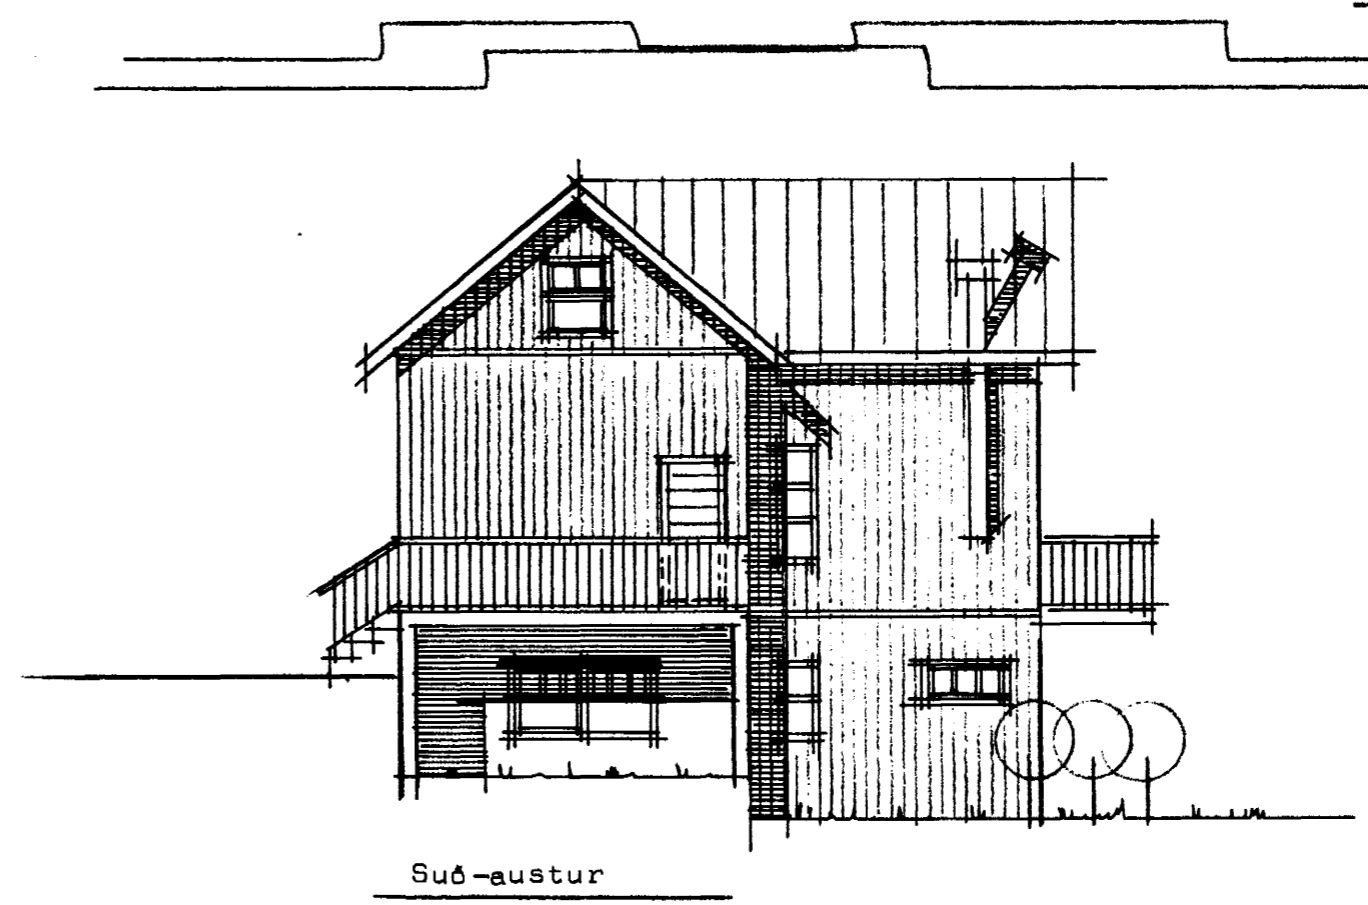

Suð-austur

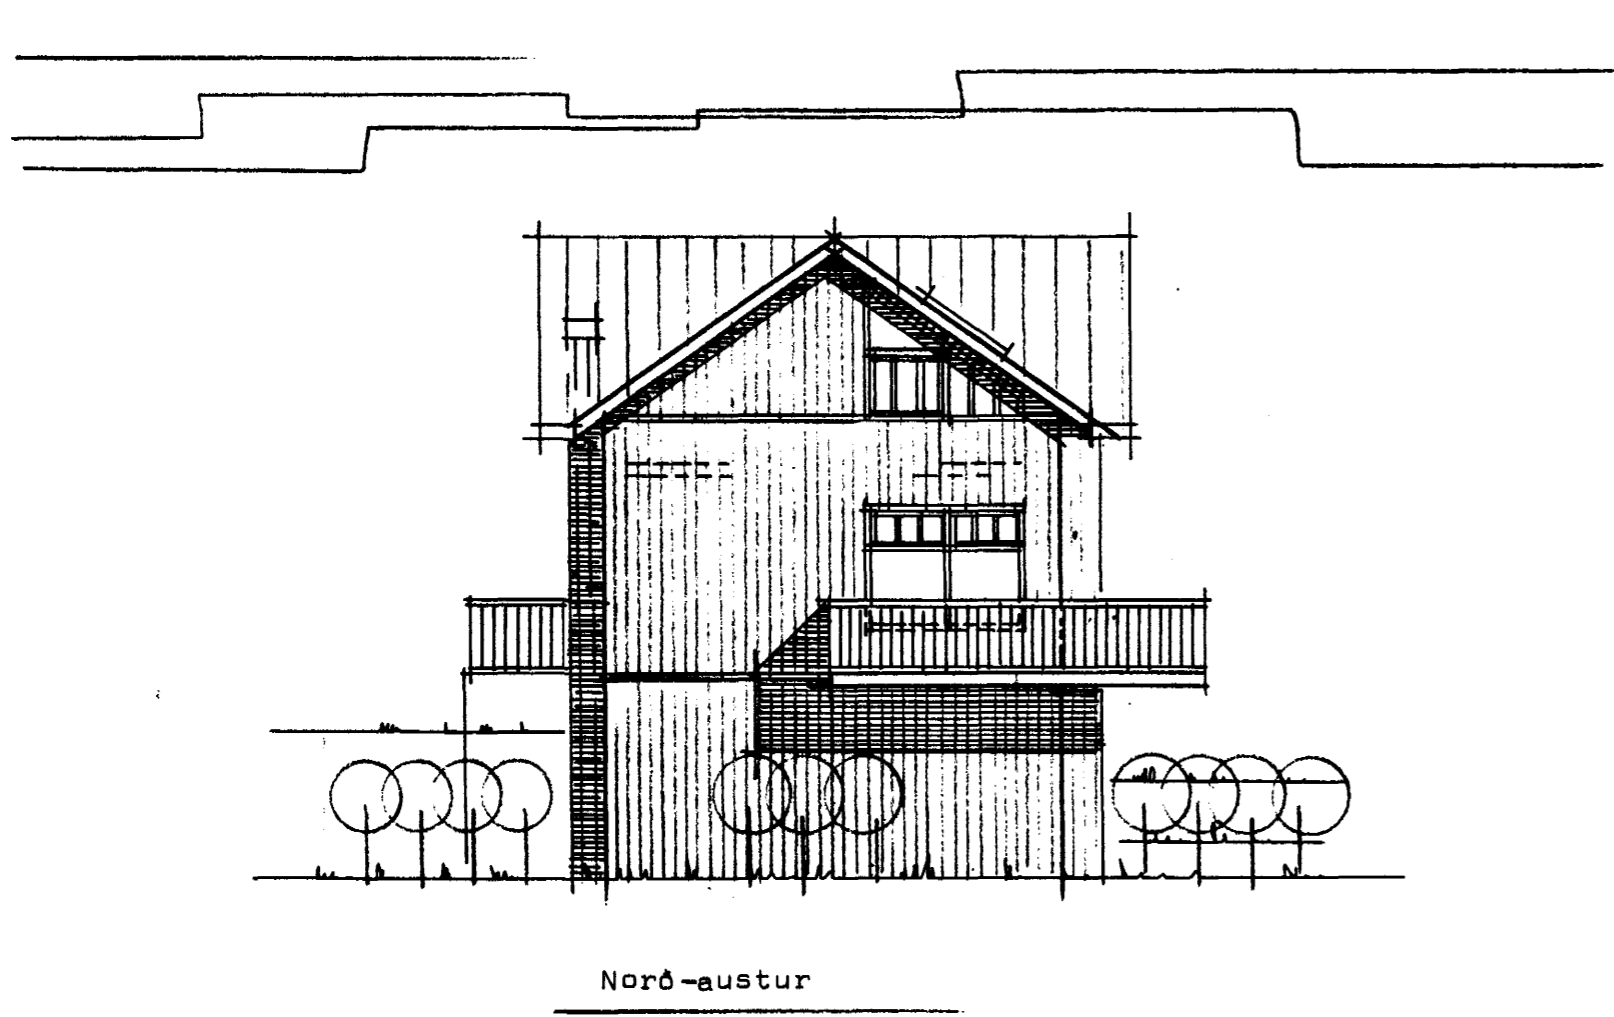

Norð-austur

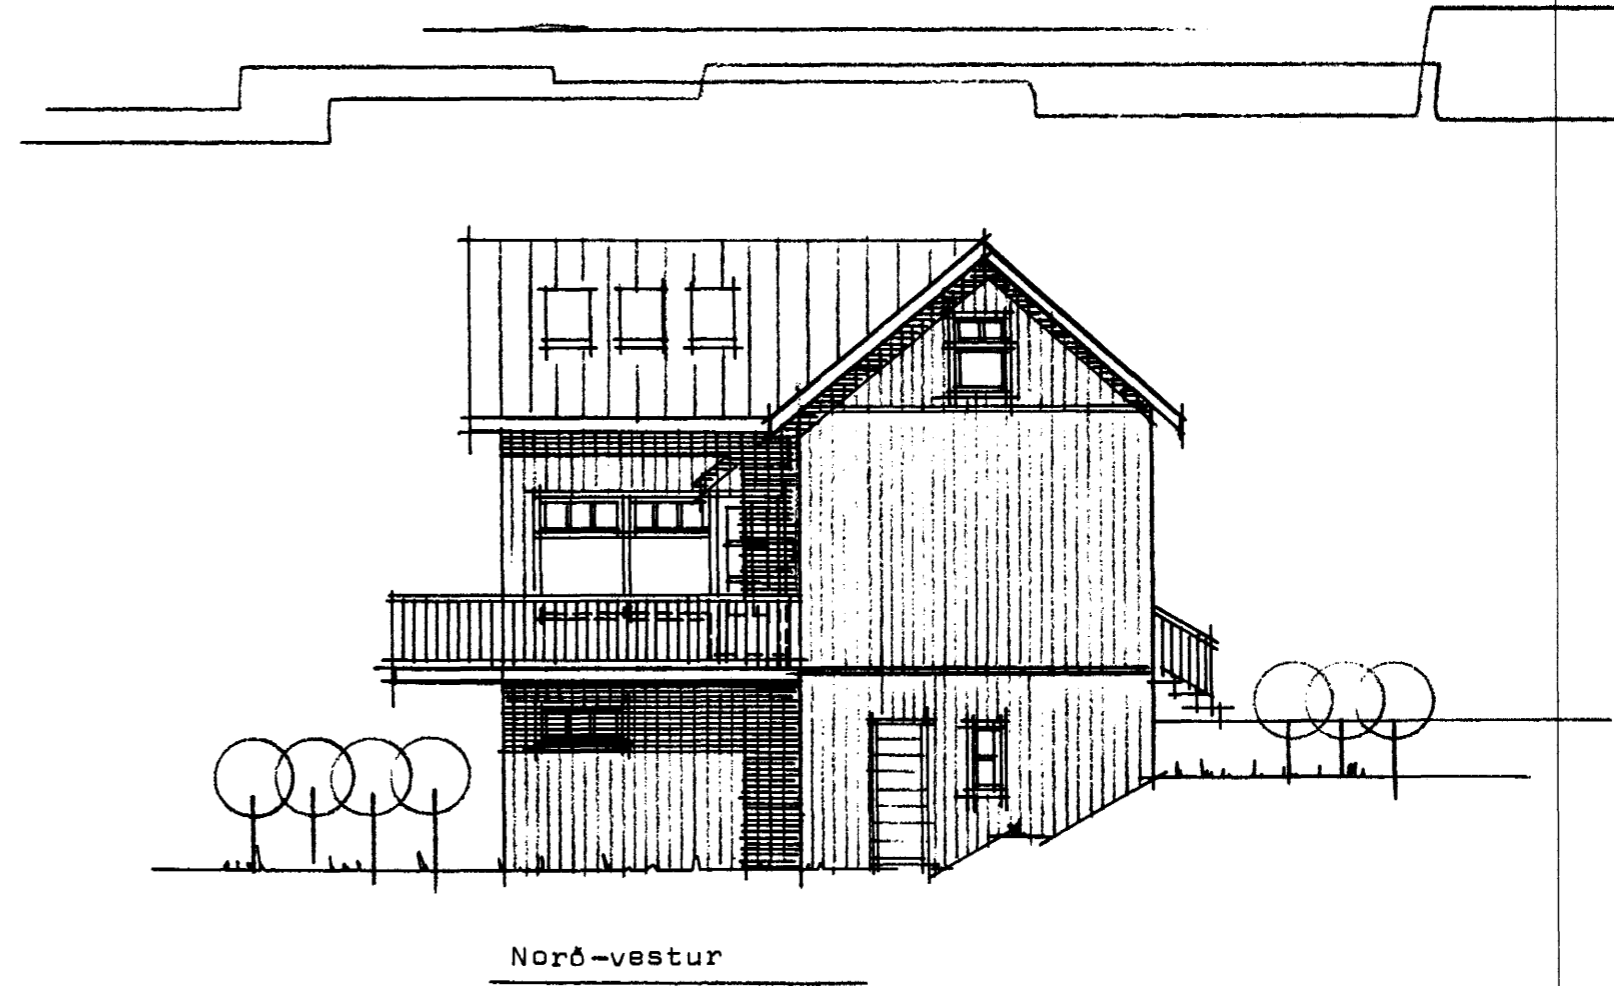

Norð-vestur

**EFTIR BREYTINGU**

**TEIKNISTOFAN HÁALEITI**  
 HÁALEITISBRAUT 125 - 108 REYKJAVÍK  
 KT. 270738-4439 - SÍMI 553 6239 & 985 6132



BYGGINGASTADUR	Langeyrarvegur 16A Hafnarfirði		
HEITI	Ótlitsmyndir		
MKV:	BREYTT	BLAD NR.	
1:100		1.03	
		VERK NR.	
		9906	