



Langeyrarvegur nr. 5
Breyting á þaki
Mál 1:200


Egill Egilsson

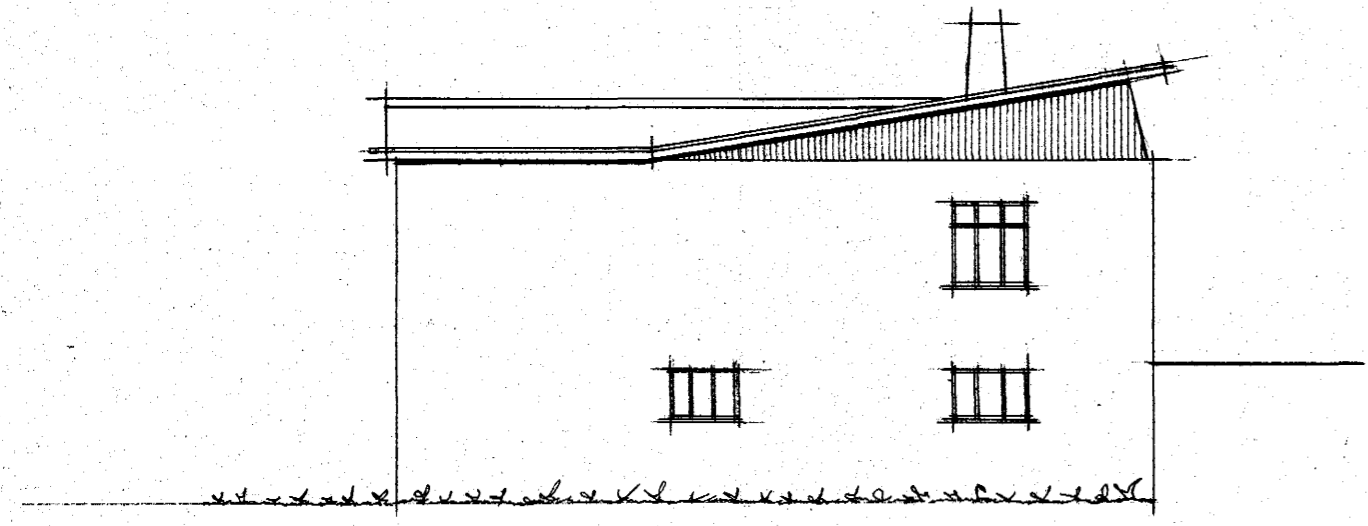


Sub-austur

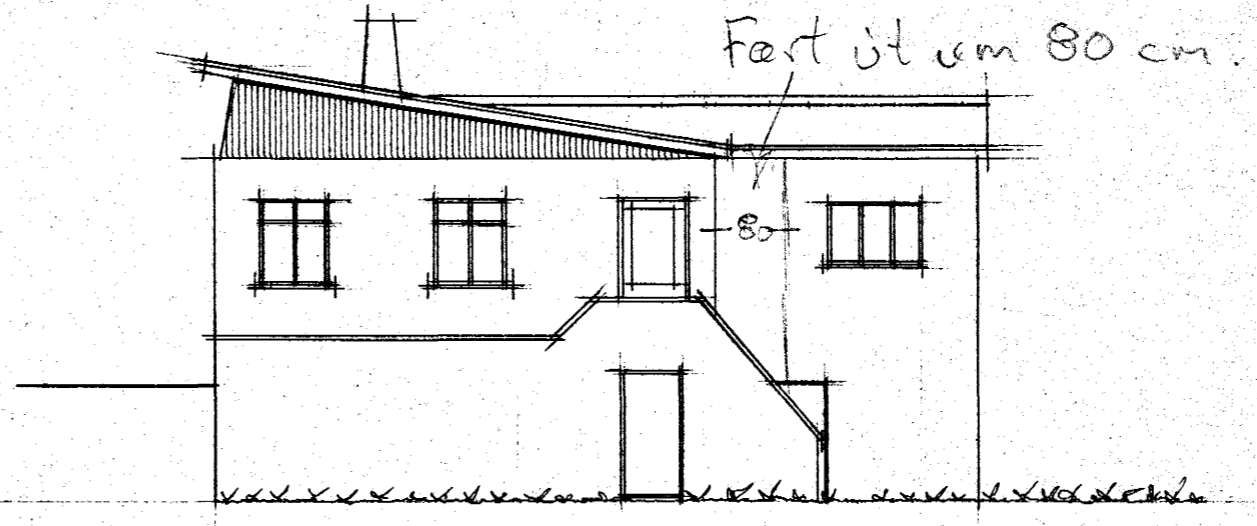


Norð-vestur

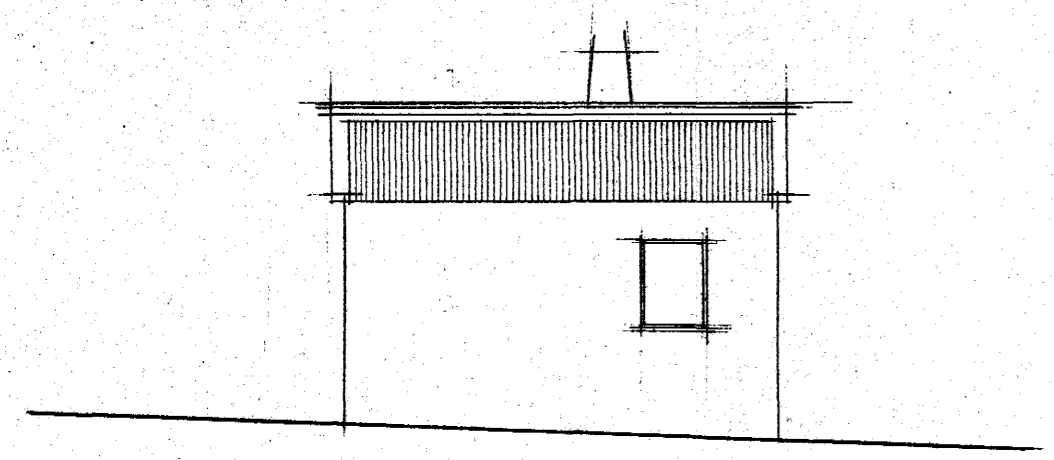


Norð-austur

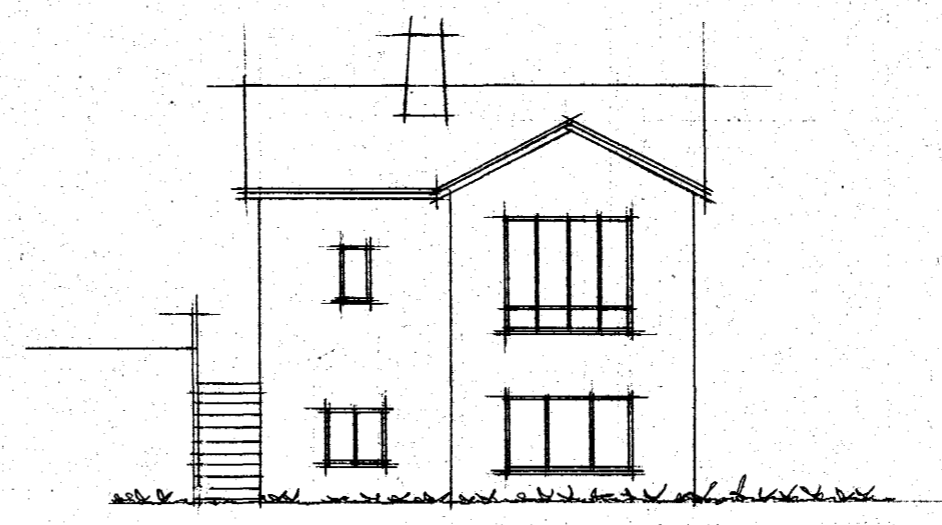


Sub-vestur

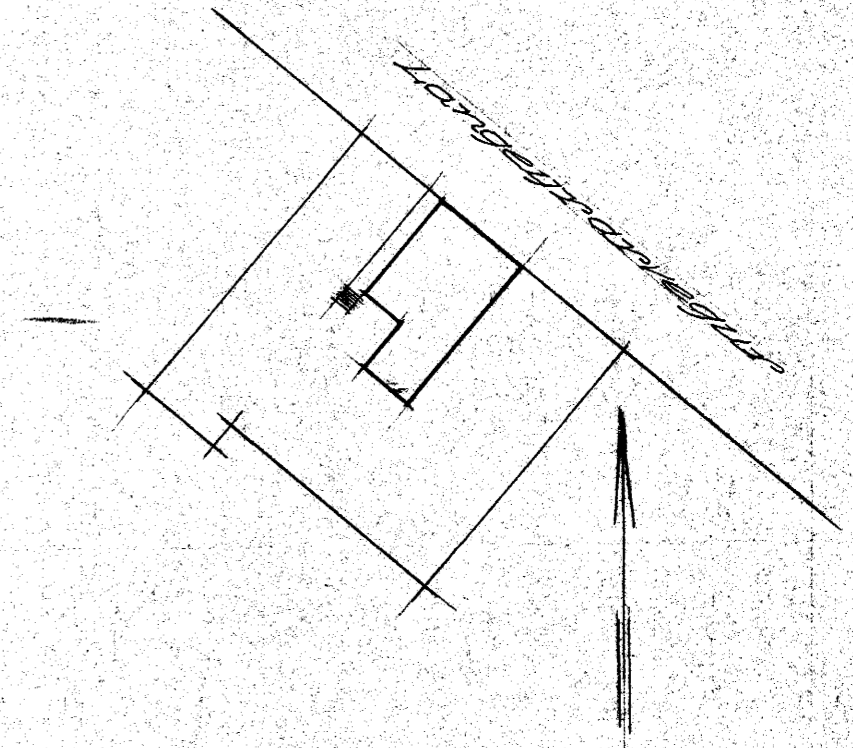


Afstæðumýri 1:500

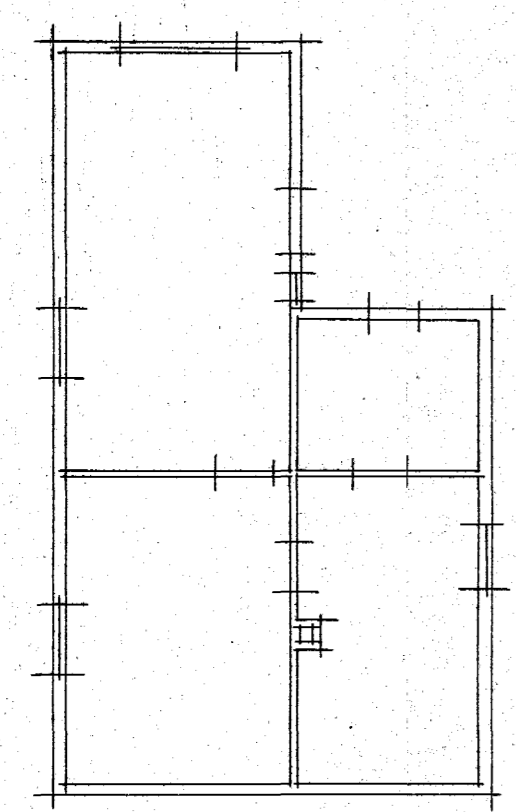

Kjallari

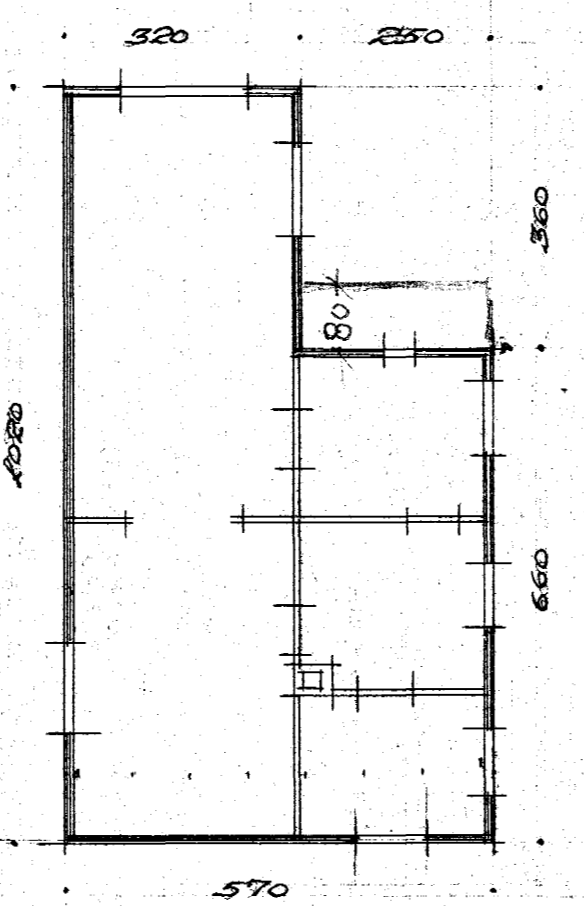

1. hæð

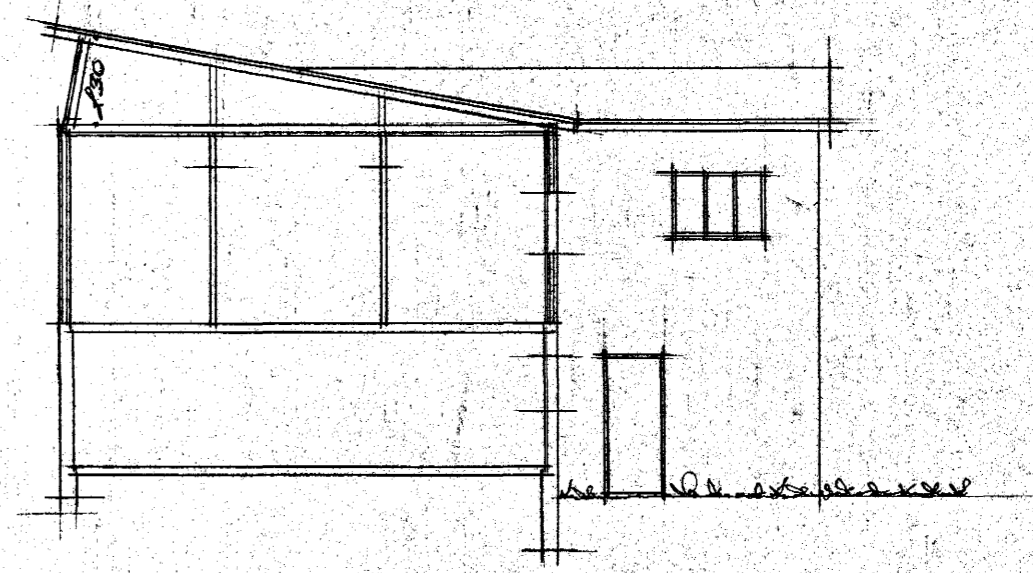

Sneiðing

Reykjavík 27.6.1960
Egill Egilsson arkitekt