



FLATIRUGIL HÚSS 939,00M²
NETTING LÖBAG 0,575

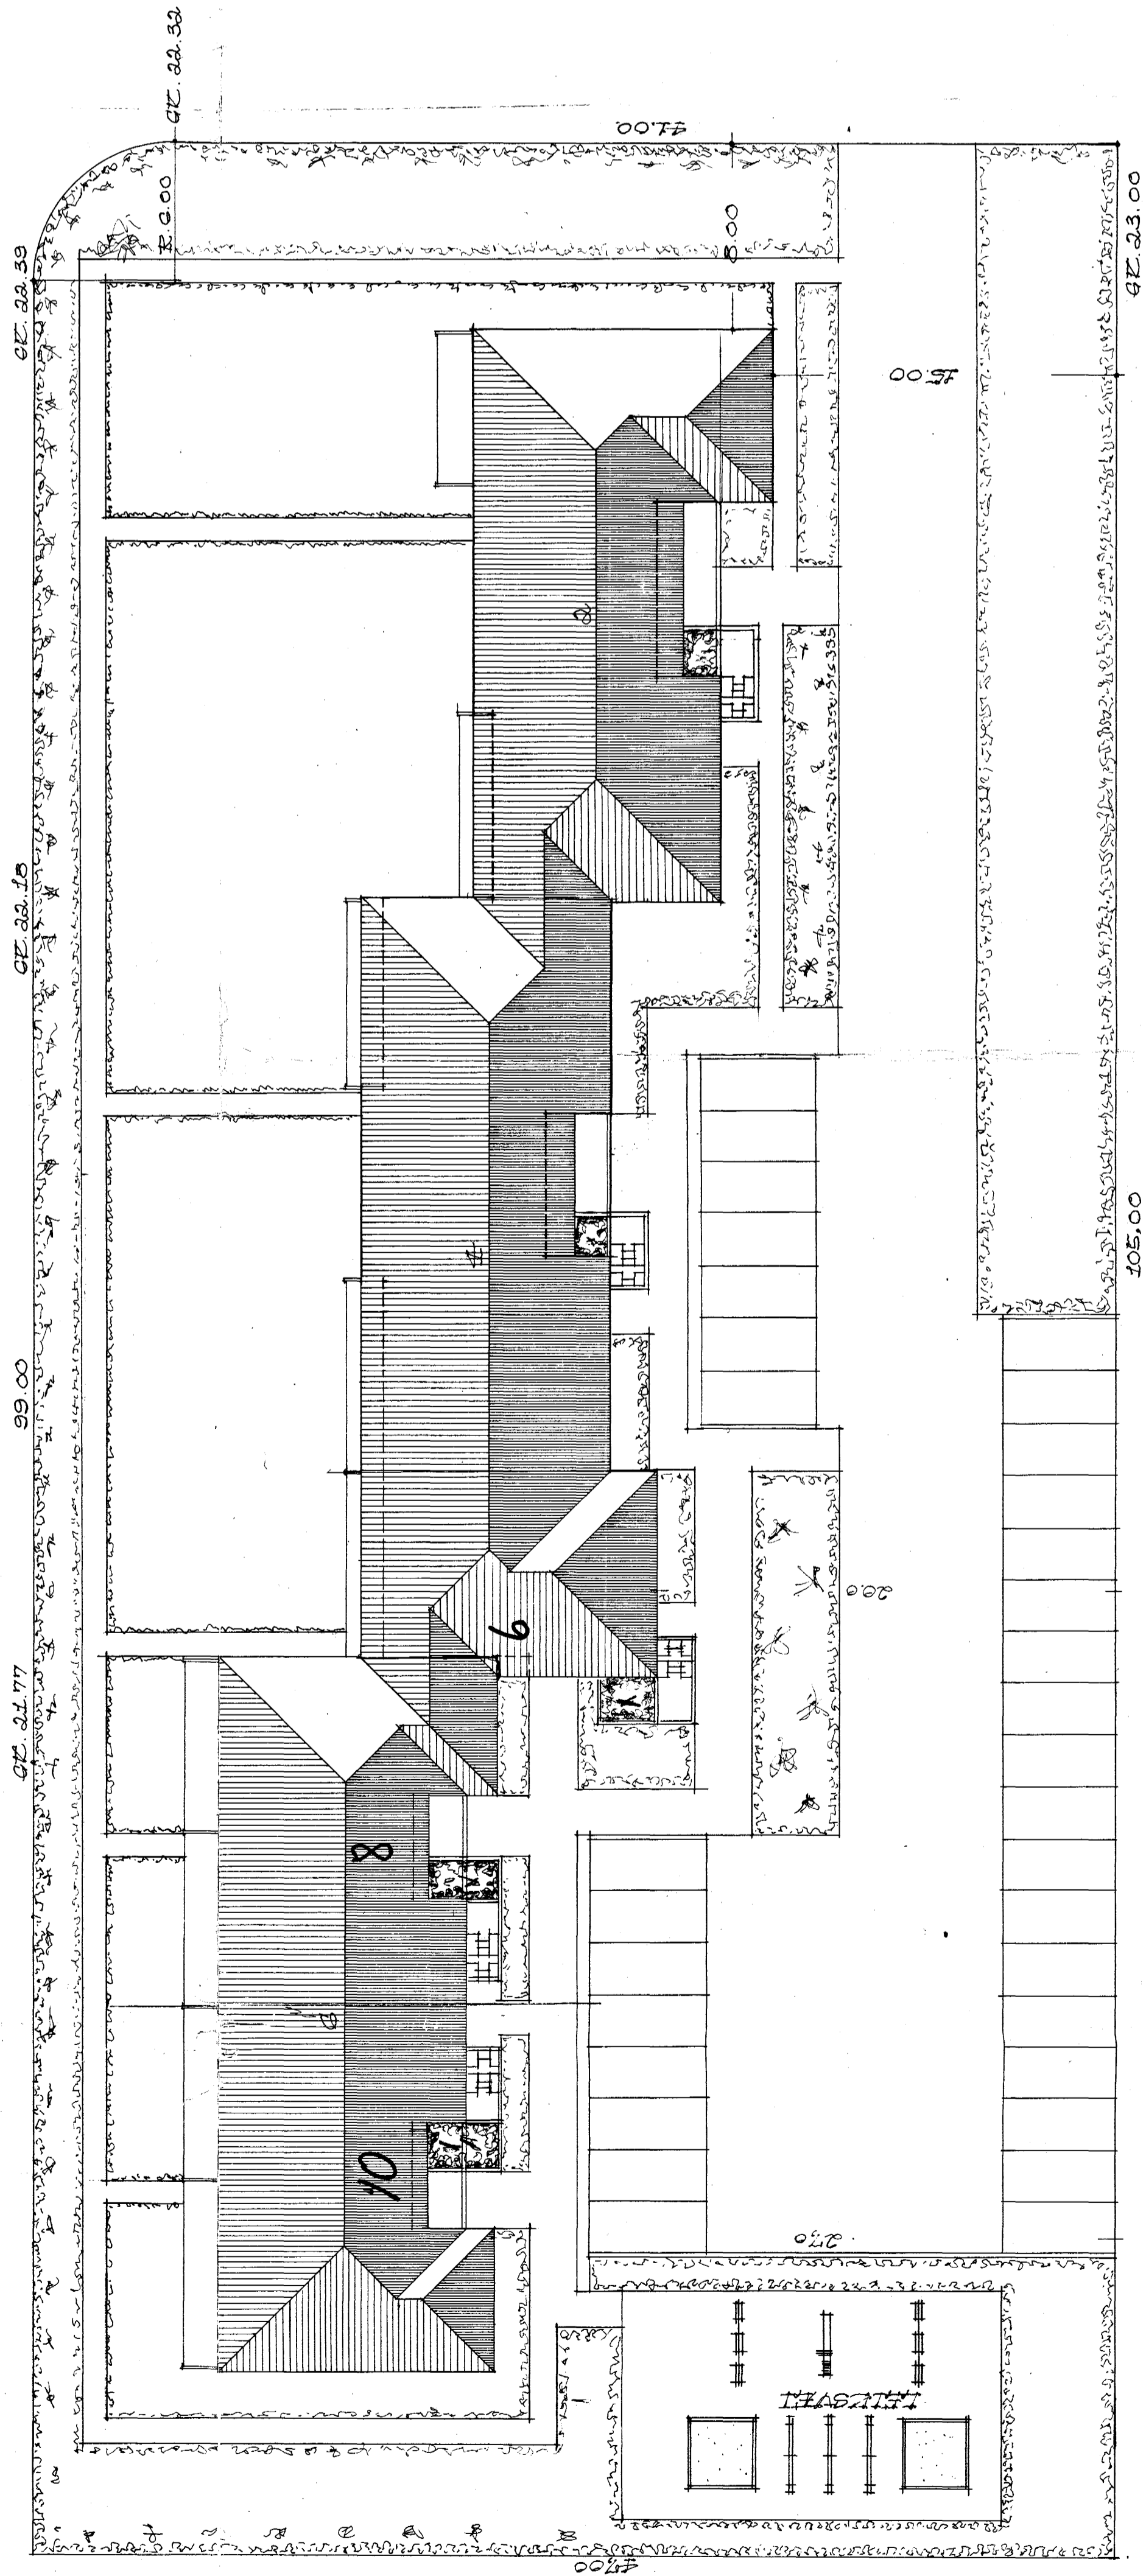

FLATIRUGIL HÚSS

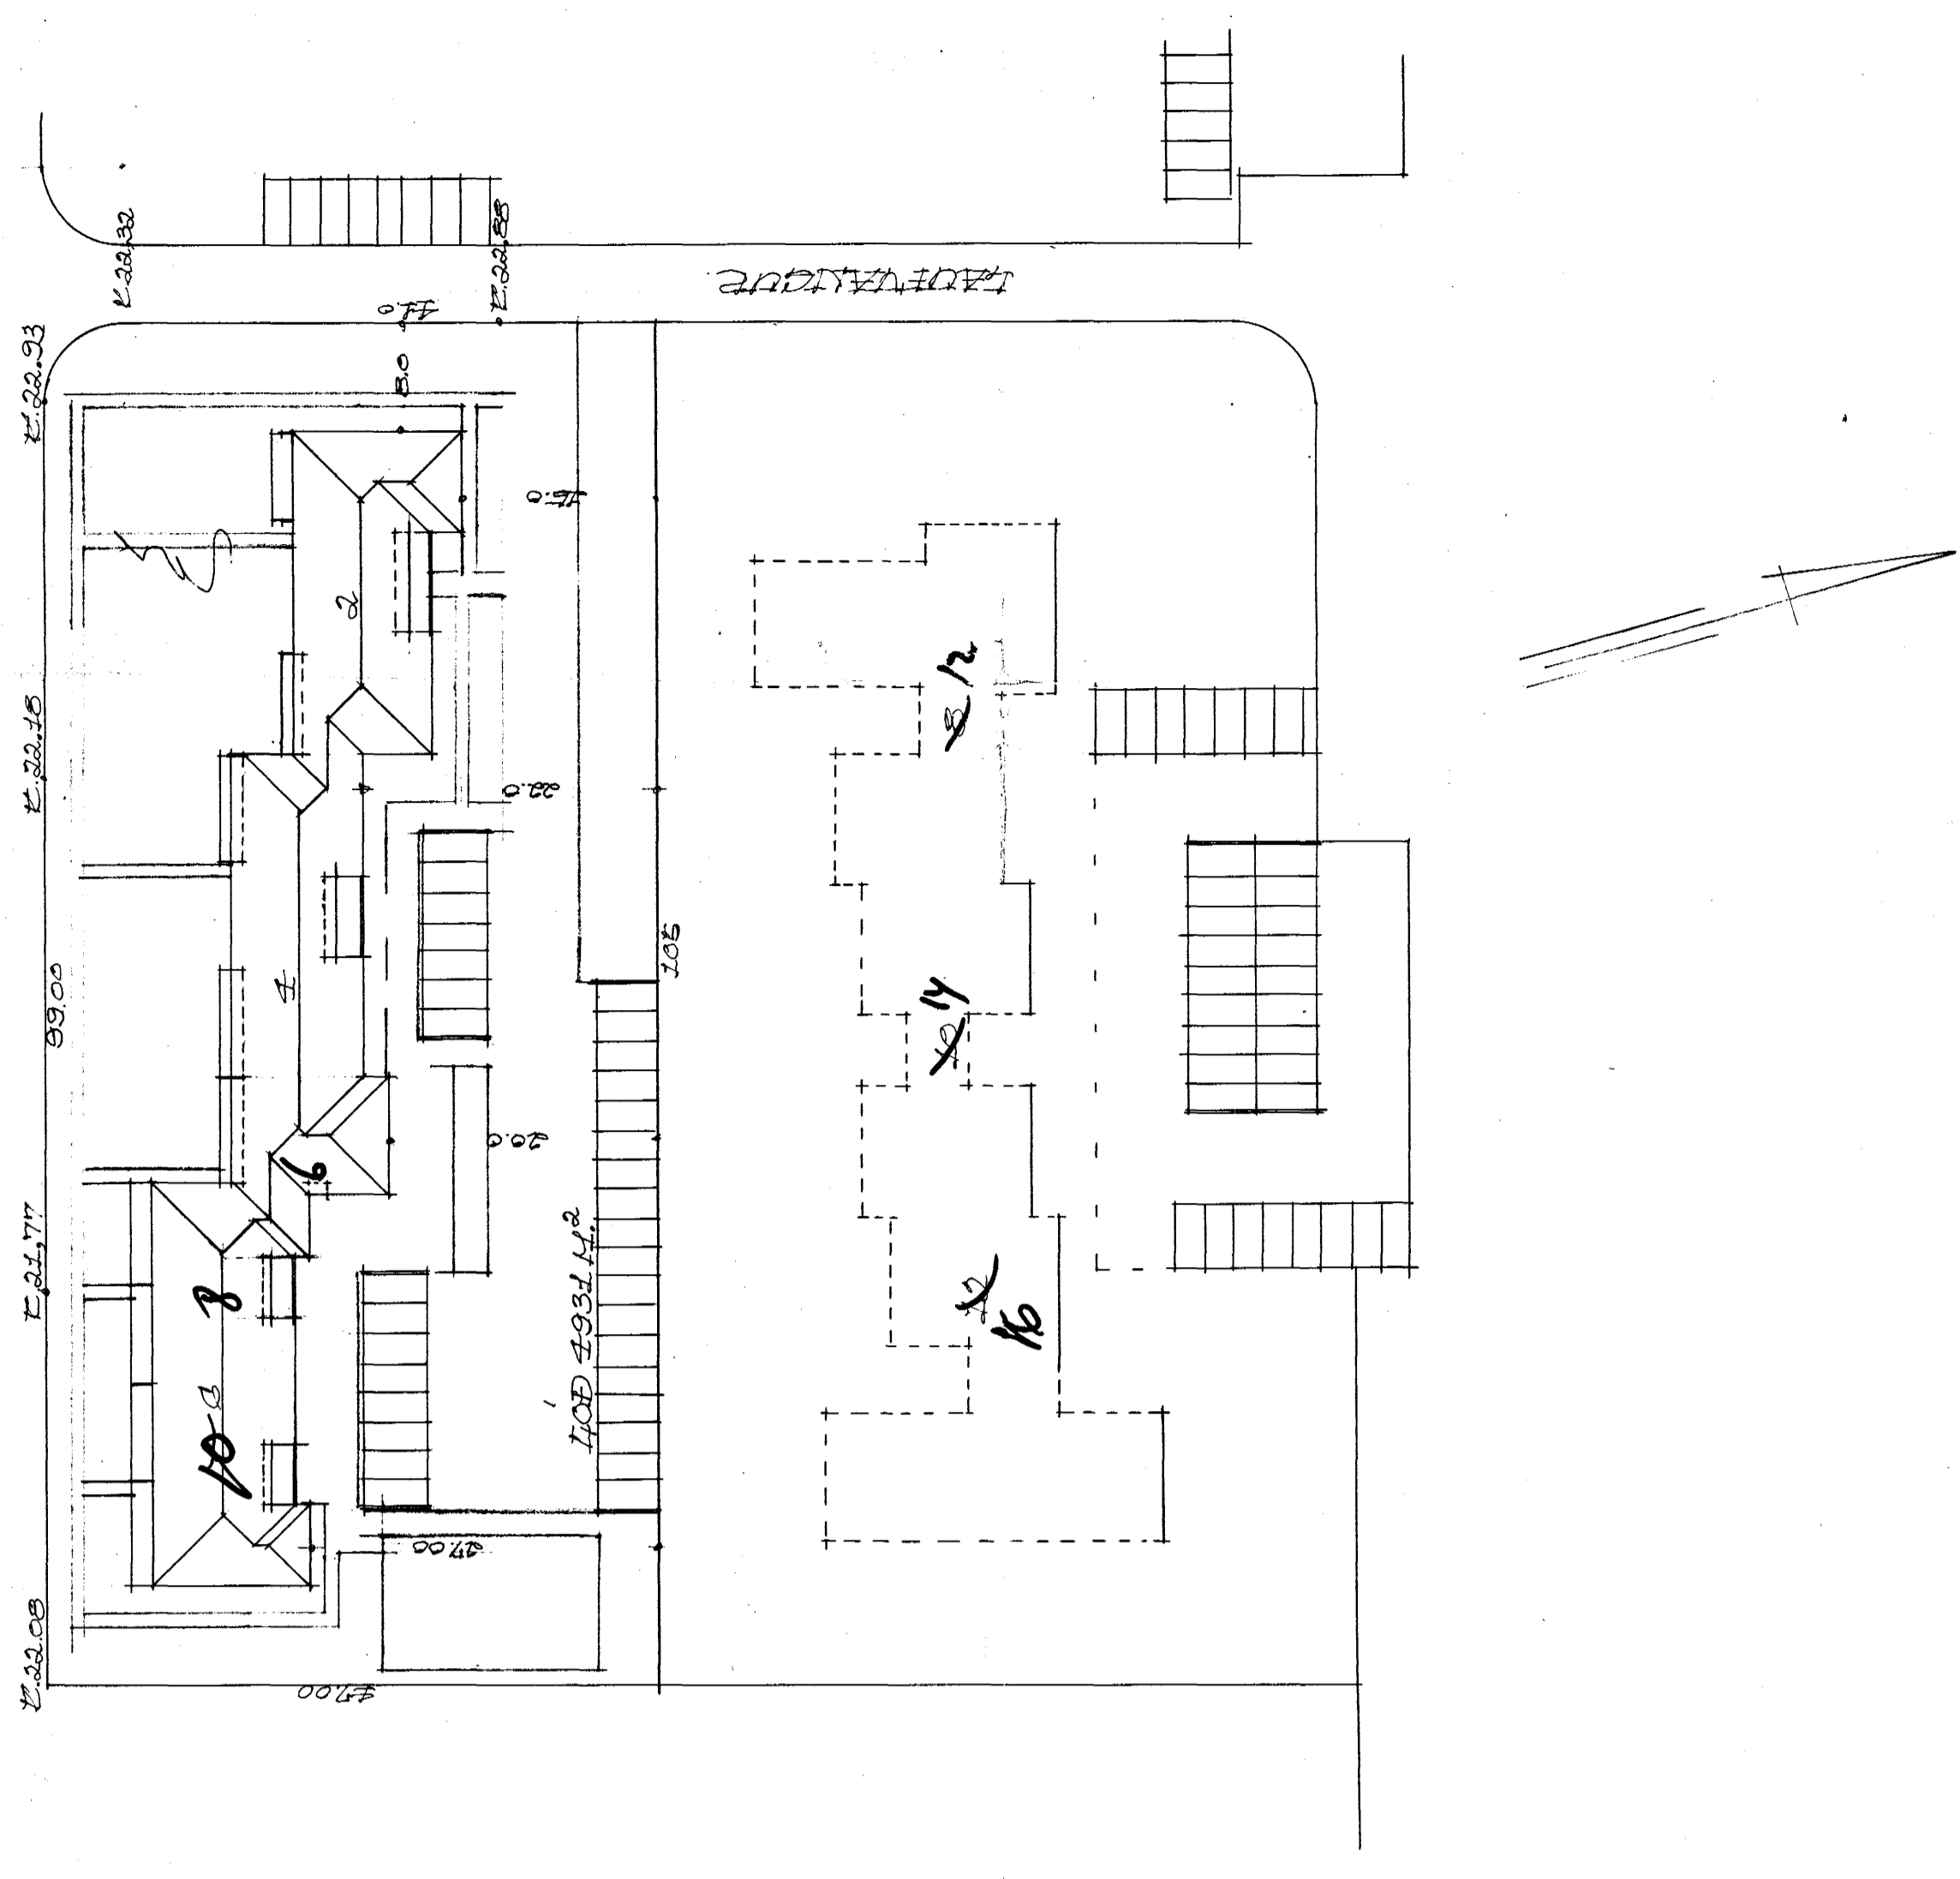

Samþykkt af fundi bygginga-
nefndar þ. 26. / 2. / 1969
BYGGINGARÁBULTRUINN
I HAFNARBERÐI
E. Jónsson