


GRUNNMÝND 1:50

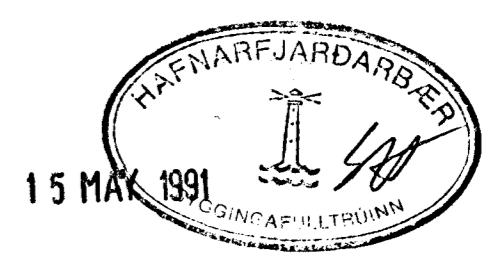

01	MAJ 91	DR. A. JARÞVATNSLÖGVI	GH
BR NR	DAGS	EDLI BREVTINGAR	SIGN.
LINDARBERG 26 HAFNARFIRÐI			DAGS 01.11.90
GRUNNLAGNIK			HANNAÐ 4.2.
MÆLIKV. 1:50			TEIKNAD 4.2.
SIGURÐUR ÞORLEIFSSON TEKNIFRÆÐINGUR F.T.T.F.I.			VERK NR 9040
STRANDGÖTU 11 HAFNARFIRÐI SÍMI 54751/54255			BLAD NR 2-02