


RÚMMYND HITALAGNA 1:50

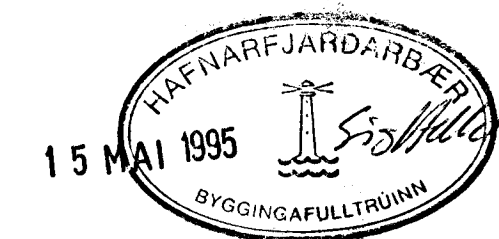

01	04.05'95	OFNAR FERÐIR, LEGU LAGNA ISK.	GA
BR.NR.	DAGS	EDLI BREVTINGAR	SIGN.
LINDARBERG 68 HAFNARFIRÐI			DAGS MARS '92
RÚMMYND HITALAGNA			HANNA
MÆLIKV. 1:50			TEIKNAR
SIGURÐUR ÞORLEIFSSON TEKNIFRÆÐINGUR F.T.F.I.			VERK NR. 9116
STRANDGÖTU 11 HAFNARFIRÐI SÍMI 54751/54255			BLAD NR. 2-05