


GRUNNMYND NEÐRI HÆÐ M 1:50

OFNASKRA:

NR.	STADUR	TENGING	HEITI VALINS OFNS	AFKOST VALINS OFNS kcal./klst	MESTA LEIFILEG LENGD OFNS mm	MESTA LEIFILEG HÆÐ OFNS mm	ÞORF OFNS wött/klst
101	BÍLSKÚR	A/B		29 16	3000	900	3000
102	STOF	C/D		19 18	1800	560	2000
103	STOFA	A/B		14 25	1800	250	2000
104	STOFA	A/B		19 18	1800	560	2000
105	ÞVOTTUR	C/D		8 27	1500	560	960
106	GESTASNYRTIN	E/F			600	900	480
107	ANDDYRI	E/F		12 28	800	2100	1500
108	HORNHERBERGI	C/D		10 11	1800	560	1300
109	ELDHÚS	A/B		15 62	2800	560	1800
001	INNGANGUR	A/B		6 44	1200	900	700
002	HORNHERBERGI	C/D		9 19	1800	560	1120
003	HERBERGI	A/B		8 50	1800	560	950
004	HJÓNAHERBERGI	A/B		13 30	1800	560	1550
005	BAD	E/F			1800	560	1580
006	SJÓNVARP	C/D		13 30	1700	900	1500
201	RISHERBERGI	C/D		10 45	2800	650	1180
SAMTALS HÚSID ALLT:							23620

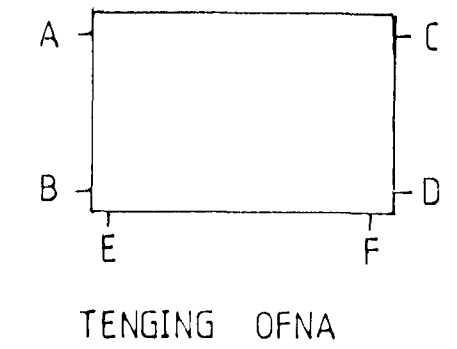

OFNI BÆTT VÍÐ I HERBERG OFAN BÍLSKÚRS NR. 202 1744kcal TENNING A-B

Lindarberg 6, Hafnarfirði
Hita og neysluvatnslagnir, stammar
Grunnmynd neðri hæðar og ofnaskrá

Dags: Mar-92 MK: 1:50 Blað 1 af 4
Klaesinn Baldursson Lindarbergi 8, Hafnarfirði. F.T.F.L. KNT. 100454-4599 Sími: 91-633484