



M.K.V. 1:50

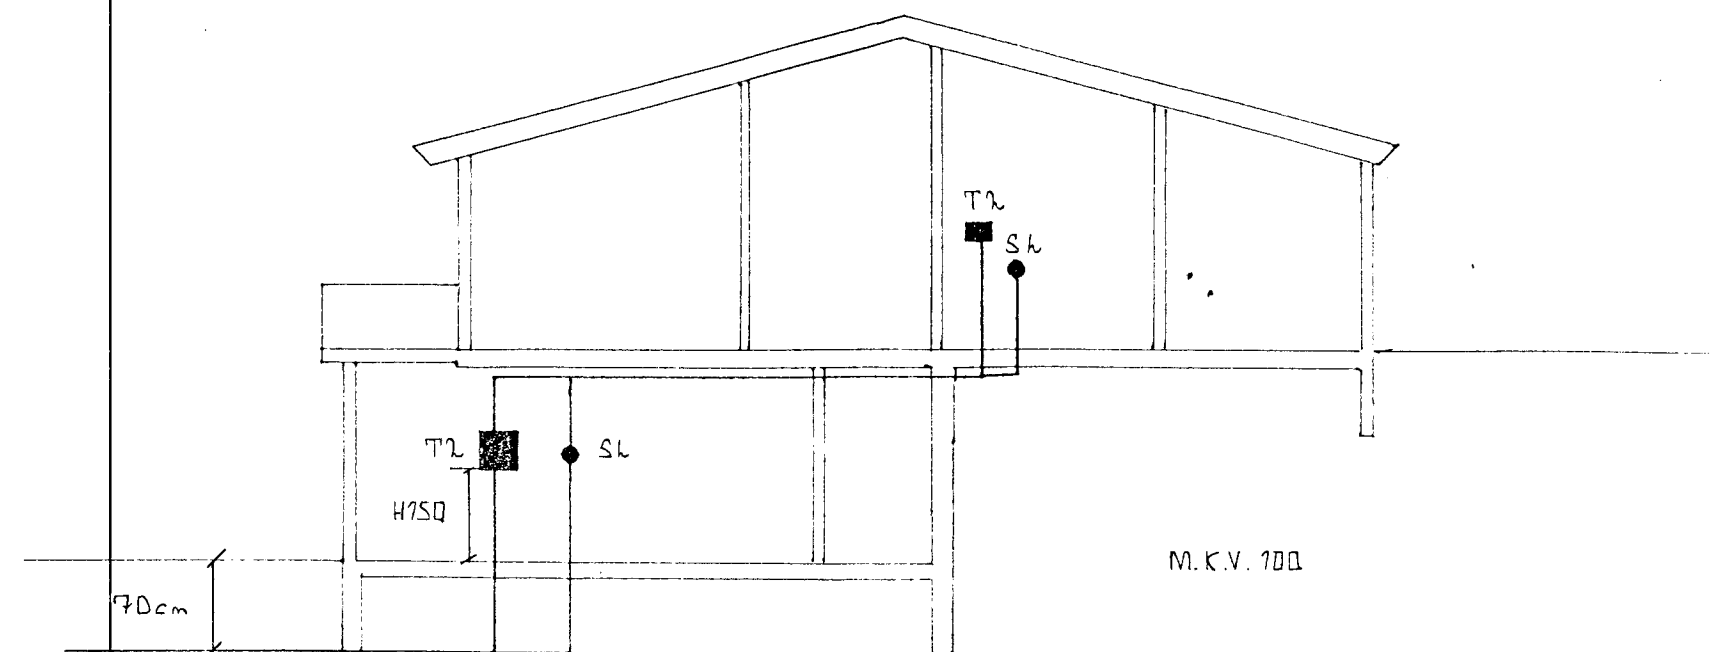

M.K.V. 1:50

Inntök samþykkt 4.2.1998.  
 S. h. RAFFVEITU HAFNARFIJARDAR  
 Birgir Dagbjört.

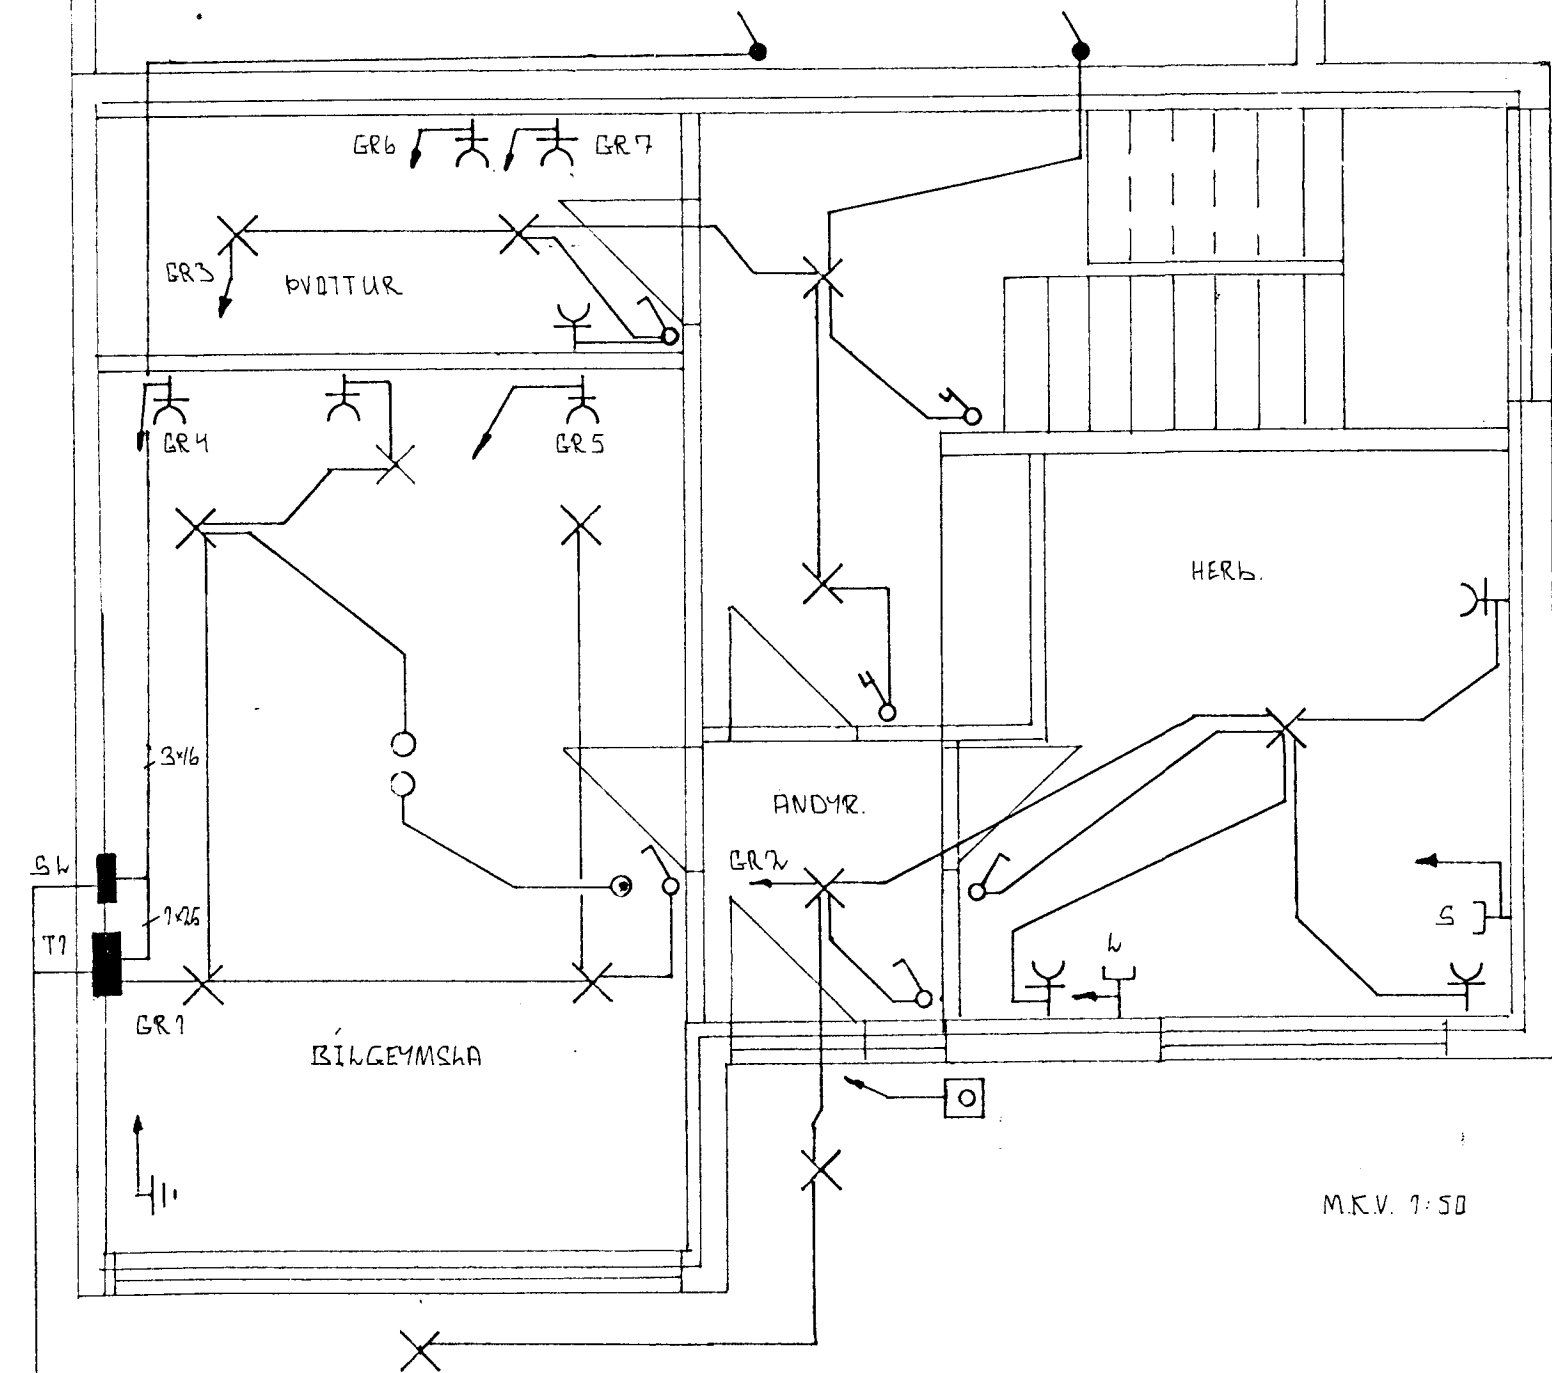

M.K.V. 1:50

RAFMAGN 50mm  
 SIMI 50mm  
 LÖFTNET 50mm

RÖR NÁ ÚT AD LÖDARMÖRKUM

LINDARBERG 84

M. No. 126/98

INGI Ó INGASON

*Ingi Ó Ingason*

3/4/98